FED. ROAD DIST. NO.	STATE	PROJ. NO.	YEAR	SHEET NO.	TOTAL SHEETS
HAWAII	HAW	E-5E	1932	1	11

INDEX TO DRAWINGS.	
SHEET NO	DESCRIPTIONS.
1	TITLE SHEET.
2	TYPICAL SECTIONS.
3-5	LINE AND PROFILE
6-7	STANDARD DETAILS.
8-11	CROSS-SECTIONS.

TERRITORY OF HAWAII.
TERRITORIAL HIGHWAY DEPARTMENT.
HONOLULU. T.H.
PLANS OF

HALEAKALA ROAD

EMERGENCY CONSTRUCTION HIGHWAY PROJECT F.A.P. E-5E.
WAILUKU DISTRICT
MAUI. T.H.

SCALE.

PLAN 1 INCH = 100 FEET.
PROFILE { HOR. 1 INCH = 100 FEET. VER. 1 INCH = 10 FEET.
CROSS SECTION { HOR. 1 INCH = 10' FEET. VER. 1 INCH = 10' FEET.

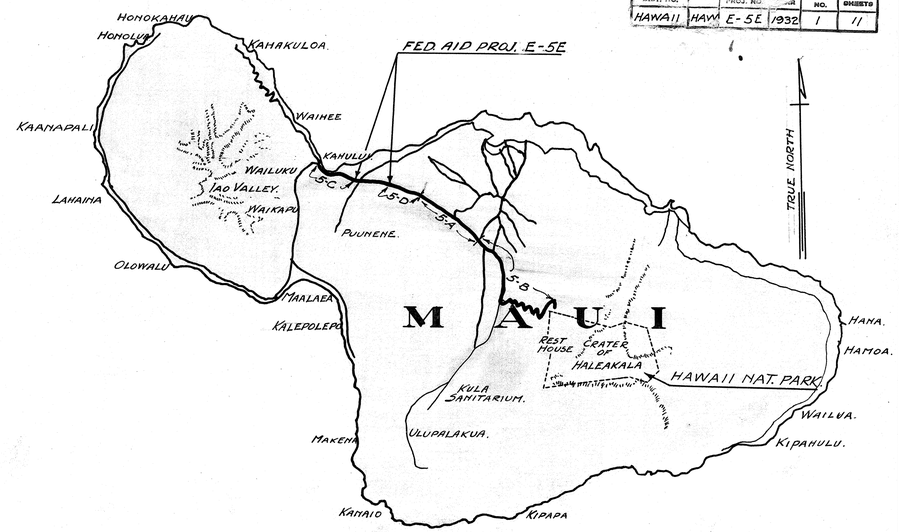

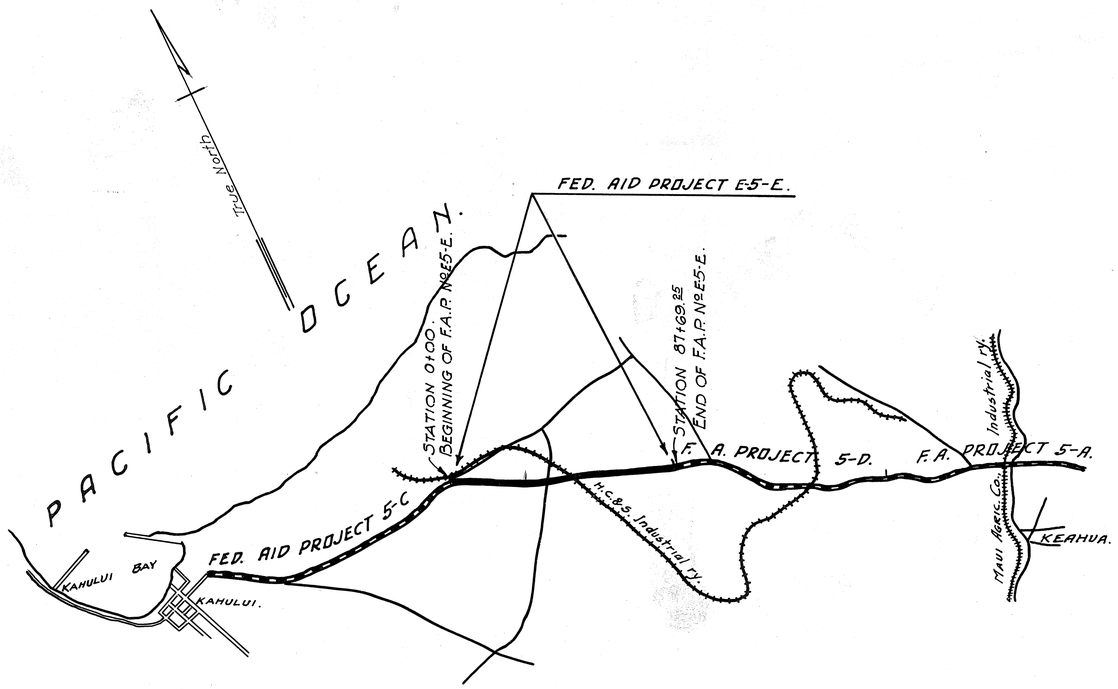

CONVENTIONAL SIGNS.

EDGE OF EXISTING ROAD
EXISTING FENCE
CENTER LINE
EXISTING CULVERTS
TREES

LAYOUT OF PROJECT.
Scale 1" = ½ Mile.

GROSS AND NET LENGTH 1.661 MILE.

APPROVED.
Lyman H. Bigelow
TERRITORIAL HIGHWAY ENGINEER.

RECOMMENDED FOR APPROVAL
S. C. Rudolph. 9/28/32
PRINCIPAL HIGHWAY ENGINEER Bureau of Pub. Roads.

RECOMMENDED FOR APPROVAL
[redacted]
CHIEF ENGINEER, Bureau of Public Roads.

APPROVED.
[redacted]
DIRECTOR Bureau of Public Roads.

Revised 10-24-32 for 18' Pavement JCM

4272.1