FED. ROAD DIST. NO.	STATE	PROJ. NO.	FISCAL YEAR	SHEET NO.	TOTAL SHEETS
HAWAII	HAW.	37A-01-68	1967	1	3

INDEX TO DRAWINGS	
SHEET NO	DESCRIPTION
1	TITLE SHEET
2-3	PLAN

PLAN

STATE OF HAWAII
DEPARTMENT OF TRANSPORTATION
HIGHWAYS DIVISION
HONOLULU, HAWAII

"AS BUILT" PLANS OF

RESURFACING A PORTION OF HALEAKALA HIGHWAY

KAHULUI TOWARDS PUKALANI

PROJECT NO. 37A-01-68

DISTRICT OF WAILUKU

ISLAND OF MAUI

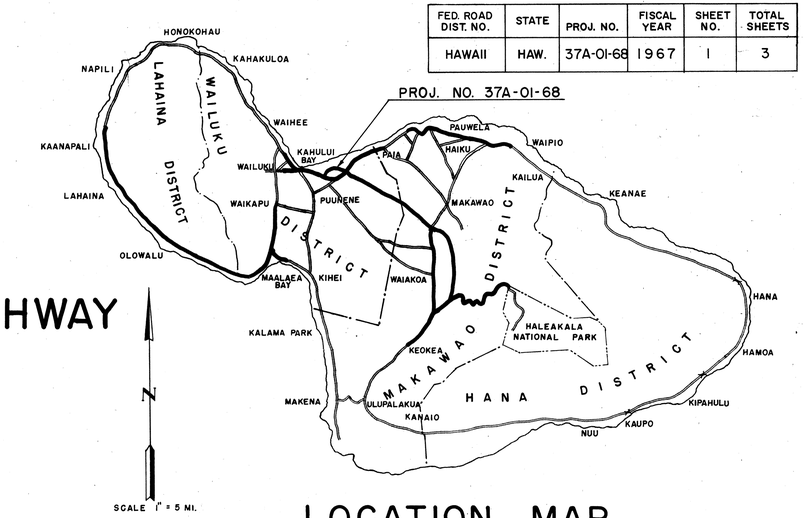

LOCATION MAP

FEDERAL AID PROJECTS PREVIOUSLY CONSTRUCTED OR UNDER CONSTRUCTION

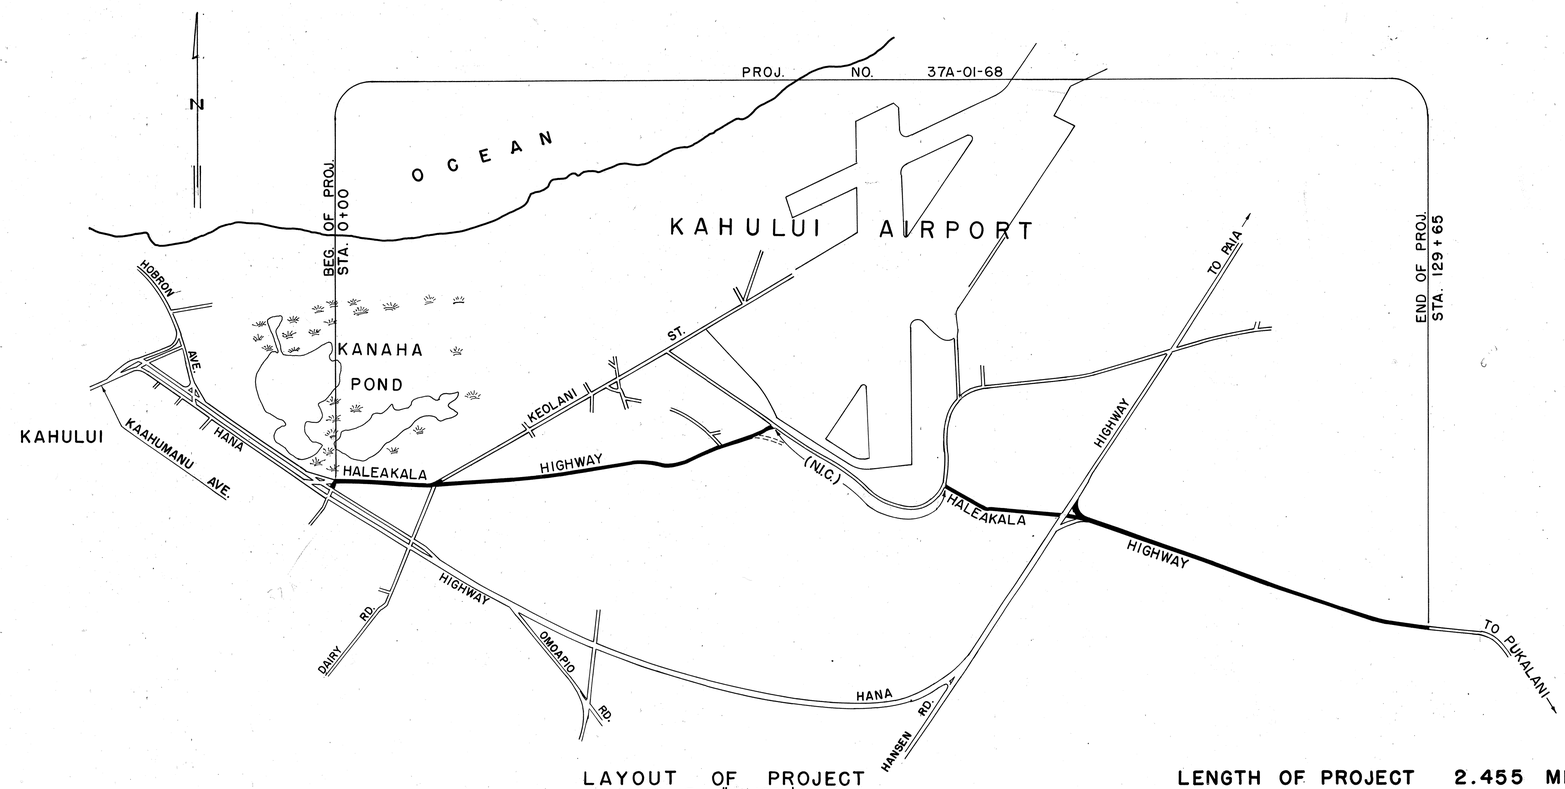

LAYOUT OF PROJECT

SCALE 1" = 1000'

LENGTH OF PROJECT 2.455 MILES

NOTE:

ALL CHANGES MADE DURING CONSTRUCTION HAVE BEEN NOTED IN RED ON THESE TRACINGS AND CHECKED BY:

Harrew Unemori
PROJECT ENGINEER

5/24/68
DATE

APPROVED: DATE 11/13/67

John H. Wise
FOR DIRECTOR OF TRANSPORTATION

K. Wong
Nov. 1967

C-4-J

1

.024 mi. 2.455 mi.