FED. ROAD DIST. NO.	STATE	PROJ. NO.	FISCAL YEAR	SHEET NO.	TOTAL SHEETS
HAWAII	HAW.	37C-01-71	1971	2	8

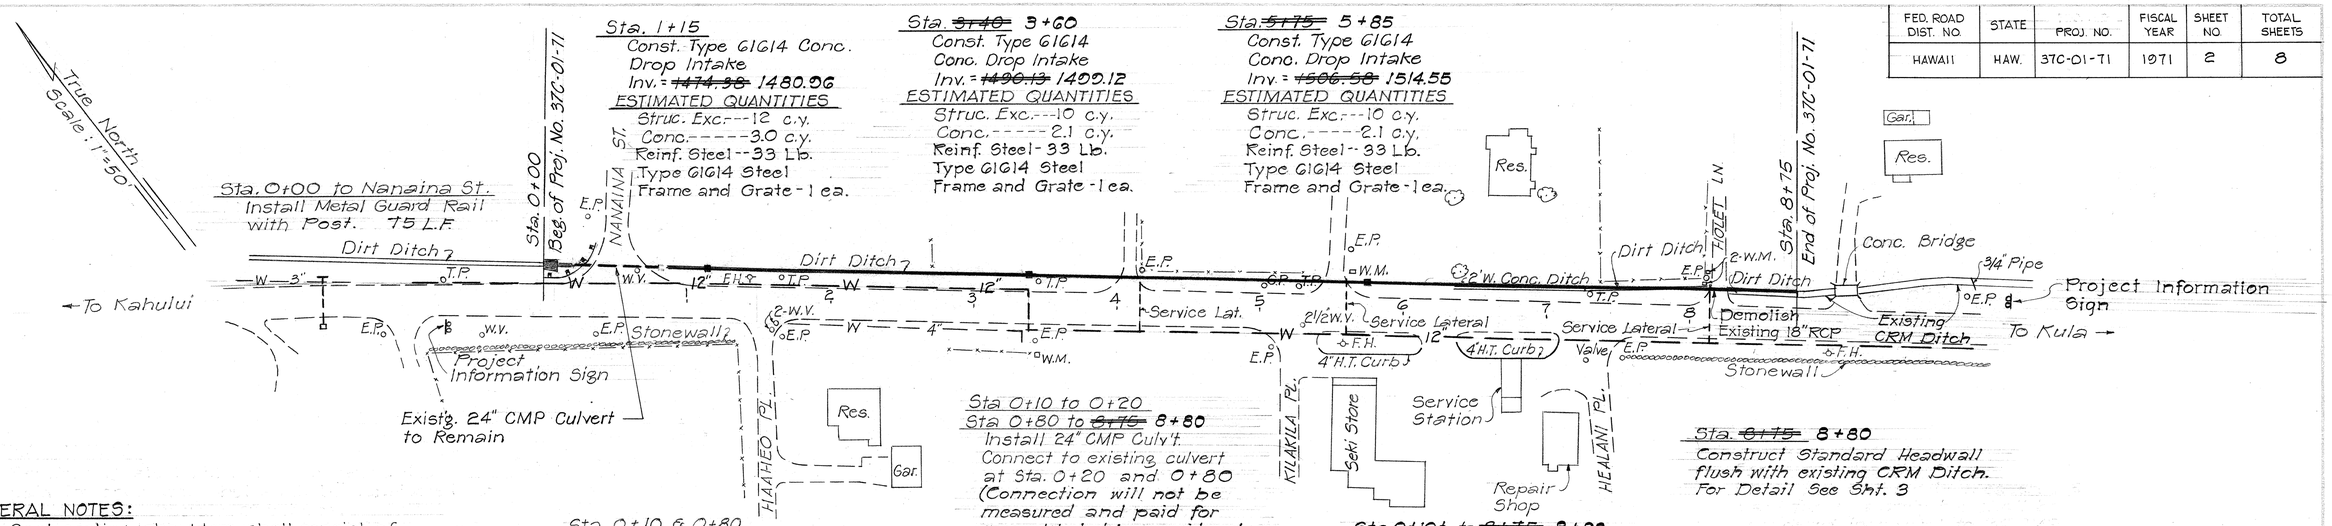

GENERAL NOTES:

1. Seal coating shoulders shall consist of excavating the existing shoulder to grade, laying of aggregate base and seal coating (Type 2). It will be measured and paid for by the square yard, said payment to be full compensation for all materials, labor, equipment, tools, and etc. needed to complete the work.
2. If the Contractor elects to do so, rock for GRP is available at the State Baseyard.
3. The Contractor shall verify the locations of all water mains and service laterals.
4. Pavement patching shall be incidental to 24" Culv't.
5. Telephone & Guy Poles to be relocated by others
6. Standard Headwall shall be of CRM or Class B Concrete at the Contractor's option.

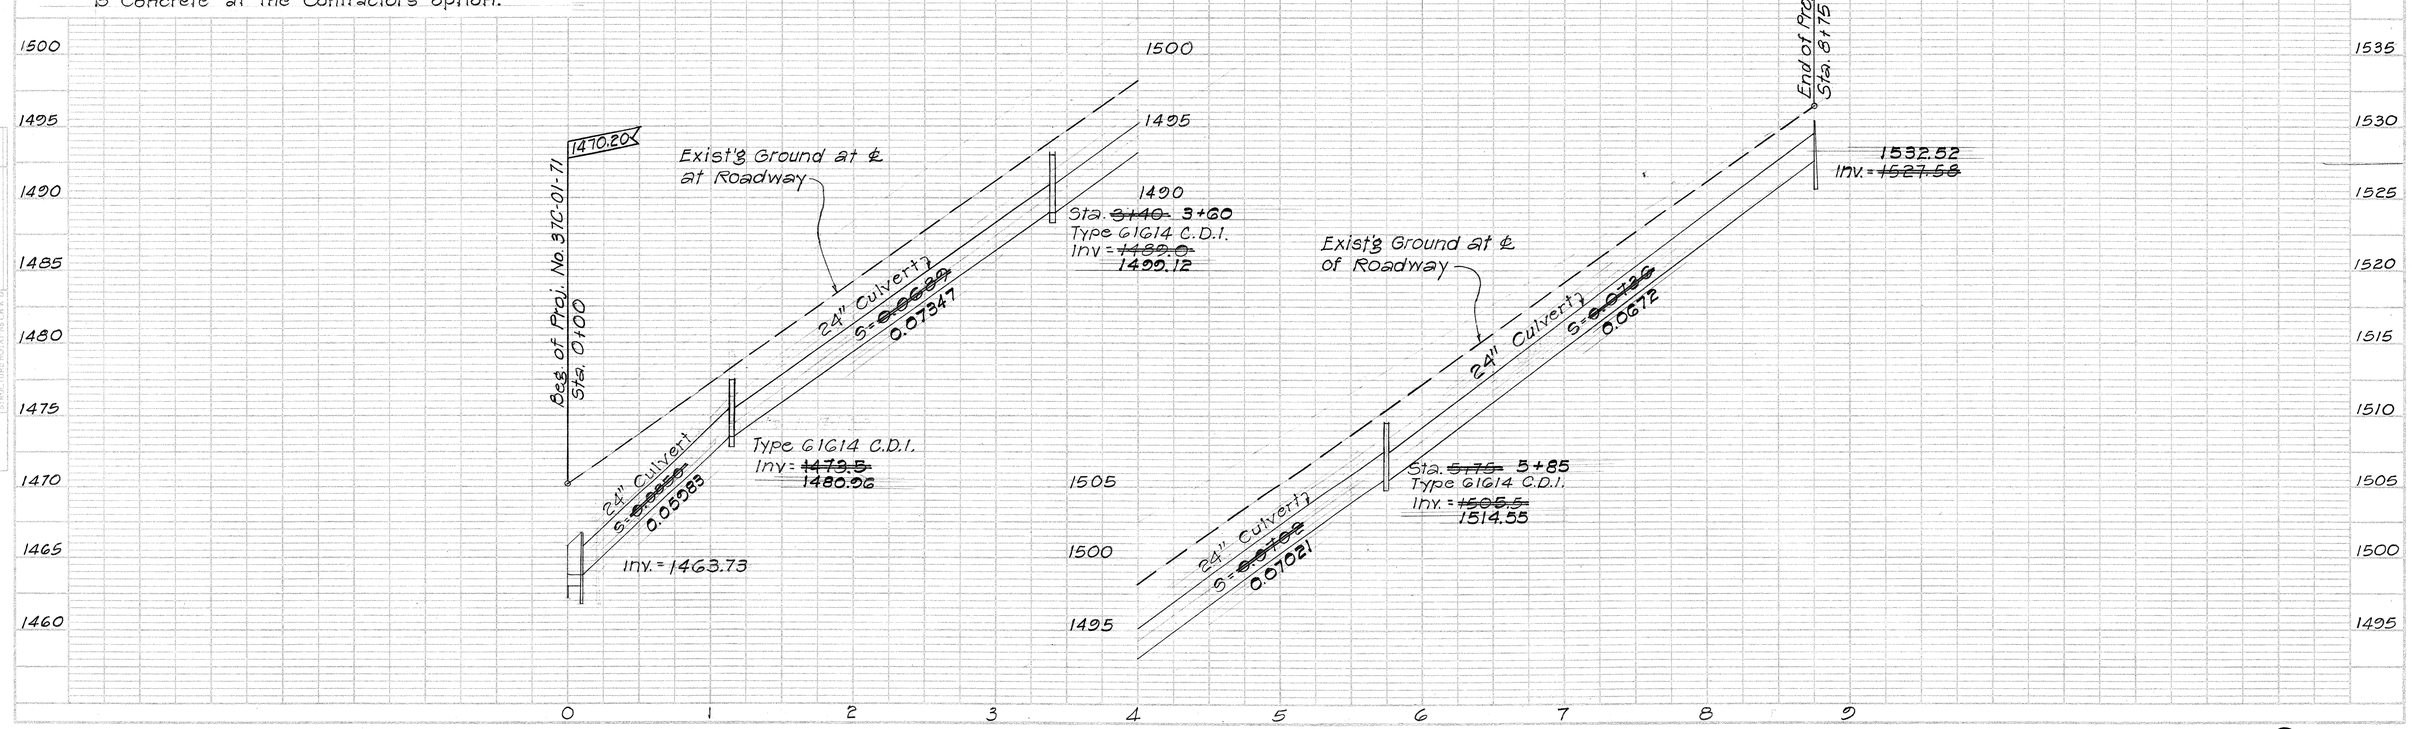

PLATE 1 PLAN-PROFILE - F.A.S.
CLEARPRINT PAPER CO., S. F. CAL.
NO. 1000D-1

2