INDEX TO DRAWINGS	
SHEET NO	DESCRIPTION
1	TITLE SHEET
2	PLAN & PROFILE
3-5	DRAINAGE DETAIL
6-8	STANDARD & TYPICAL DETAILS

FED. ROAD DIST. NO.	STATE	FED. AID PROJ. NO.	FISCAL YEAR	SHEET NO.	TOTAL SHEETS
HAWAII	HAW.	37C-01-71	1971	1	8

PROJ. NO. 37C-01-71

STATE OF HAWAII
DEPARTMENT OF TRANSPORTATION
HIGHWAYS DIVISION
HONOLULU, HAWAII

"AS BUILT" PLANS OF

DRAINAGE IMPROVEMENT ON HALEAKALA HIGHWAY

PROJECT NO. 37C-01-71

DISTRICT OF MAKAWAO
ISLAND OF MAUI

SCALES

PLAN		1 IN. =	FT.
PROFILE	HOR.	1 IN. =	FT.
	VER.	1 IN. =	FT.
X-SECTIONS	HOR.	1 IN. =	FT.
	VER.	1 IN. =	FT.

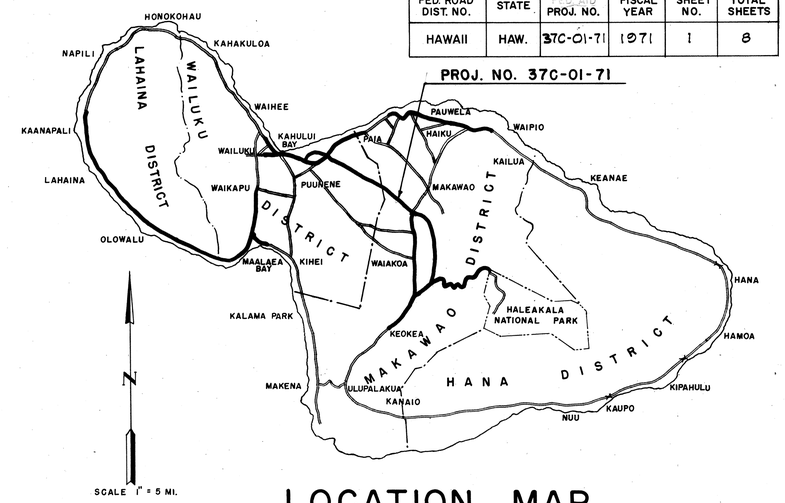

LOCATION MAP

FEDERAL AID PROJECTS PREVIOUSLY CONSTRUCTED OR UNDER CONSTRUCTION

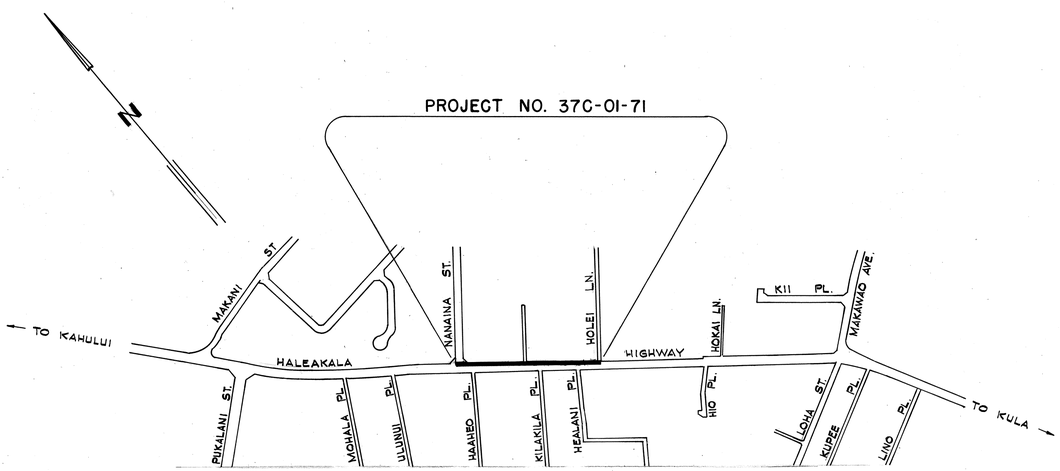

LAYOUT OF PROJECT
SCALE: 1" = 400'

NOTE:

ALL CHANGES MADE DURING CONSTRUCTION HAVE BEEN NOTED IN RED ON THESE TRACINGS AND CHECKED BY:

Kazuto Sato
PROJ. ENG'R

8/21/72
DATE

APPROVED: DATE 8/26/71

Munny Lee
For DIRECTOR OF TRANSPORTATION

DESIGNED BY: MAUI DISTRICT OFFICE
STATE HIGHWAYS DIVISION
DATE: DEC. 1970

P.S. & E. BY: Ronald F. Tsuzuki
PHONE: 548-2456
DATE: July, 1971