FED. ROAD DIST. NO.	STATE	PROJ. NO.	FISCAL YEAR	SHEET NO.	TOTAL SHEETS
HAWAII	HAW.	37D-01-75	1978	5	24

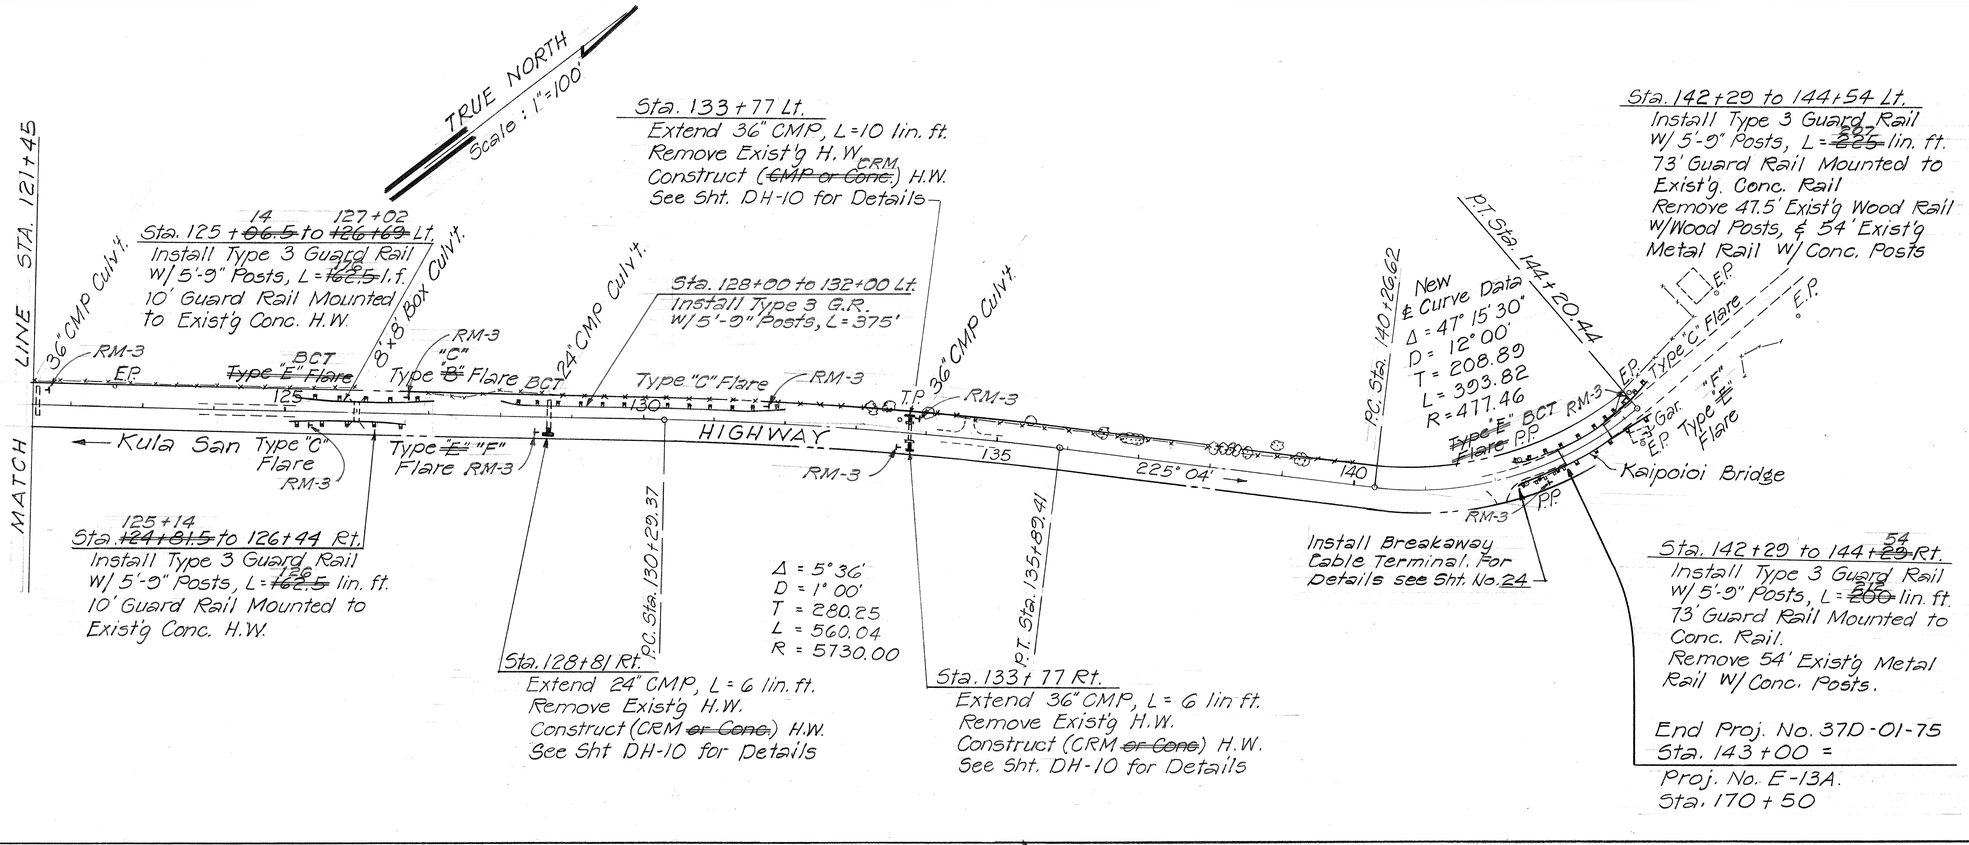

SUMMARY OF REGULATORY & WARNING SIGNS W/ POSTS

ITEM 621.51		
STATION	TYPE	QUAN.
1+50 Rt.	R2-1(30)	1
3+00 Rt.	R4-1	1
5+00 Rt.	W1-5(L)	1
15+50 Rt.	W2-2	1
23+00 Lt.	W2-2	1
41+80 Lt./Rt.	R4-1/R4-2	1/1
43+80 Lt.	W1-5(R)	1
53+20 Rt.	W1-5(L)	1
55+20 Rt./Lt.	R4-1/R4-2	1/1
82+50 Lt.	R4-1	1
84+50 Lt.	W1-5(L)	1
90+00 Rt./Lt.	R4-1/R4-2	1/1
98+00 Lt./Rt.	R4-1/R4-2	1/1
105+50 Rt.	W1-2(R)	1
106+50 Rt.	W2-2	1
107+50 Rt./Lt.	R4-1/R4-2	1/1
112+50 Lt.	W2-2	1
115+75 Lt./Rt.	R4-1/R4-2	1/1
117+75 Lt.	W1-2(L)	1
131+00 Rt./Lt.	R4-1/R4-2	1/1
138+00 Rt.	W1-2(L)	1
143+75 Rt.	W2-2	1

ITEM 621.55 (CONSTRUCTION)			
STATION	TYPE	DESCRIPTION	QUAN.
0+00 Rt. 145+00 Lt.	CG-20-1(3)	ROAD CONSTRUCTION NEXT 3 MILES (60"x36")	2
0+00 Lt. 145+00 Rt.	CG-20-2	END CONSTRUCTION (60"x 24")	2

ITEM 621.41 - RM 3 REFLECTOR MARKER WITH POST	
AT 38 FLARES	38
AT STA. 55+60 Lt.	1
TOTAL	39

SUMMARY OF PAVEMENT MARKER

STATION	DESCRIPTION	ITEM 629.40 TYPE D - EACH	ITEM 629.90 TYPE J - EACH
0+00 to 41+80	DOUBLE STRIPE	210	
41+80 to 55+20	PASS	34	136
55+20 to 82+50	DOUBLE STRIPE	137	
82+50 to 90+00	PASS	19	76
90+00 to 98+00	DOUBLE STRIPE	40	
98+00 to 107+50	PASS	24	96
107+50 to 115+75	DOUBLE STRIPE	42	
115+75 to 131+00	PASS	39	156
131+00 to 144+20	DOUBLE STRIPE	66	
144+20 TO KEKAULIKE AVE	DOUBLE STRIPE	20	
	TOTAL	631	464

ORIGINAL PLAN	SURVEY PLOTTED BY	DATE
	DRAWN BY	
	TRACED BY	
NOTE BOOK	DESIGNED BY	
	QUANTITIES BY	
No.	CHECKED BY	

STATE OF HAWAII
DEPARTMENT OF TRANSPORTATION
HIGHWAYS DIVISION

PLAN - SUMMARY OF SIGN & PAV'T. MARKER

KULA HIGHWAY

PROJ. No 37D-01-75

SCALE : AS SHOWN MAY 1975

SHEET No. 1 OF 1 SHEETS