INDEX TO DRAWINGS	
SHEET NO.	DESCRIPTION
1	TITLE SHEET
2	TYP. SECTIONS, GEN. NOTES, SUMMARY OF PAV'T. MARKING & STRIPING
3-5	ROADWAY PLANS
6-7	STANDARD DETAILS

FED. ROAD DIST. NO.	STATE	PROJ. NO.	FISCAL YEAR	SHEET NO.	TOTAL SHEETS
HAWAII	HAW.	37CD-01-80M	1980	1	7

37

STATE OF HAWAII

DEPARTMENT OF TRANSPORTATION
HIGHWAYS DIVISION

"AS - BUILT"

PLANS FOR
RESURFACING PORTIONS OF

HALEAKALA HIGHWAY
(Hana Highway towards Pukalani)
AND
KULA HIGHWAY
(Haleakala Highway towards Kalialinui Bridge)

PROJECT NO. 37CD-01-80M

DISTRICTS OF
WAILUKU AND MAKAWAO
ISLAND OF MAUI

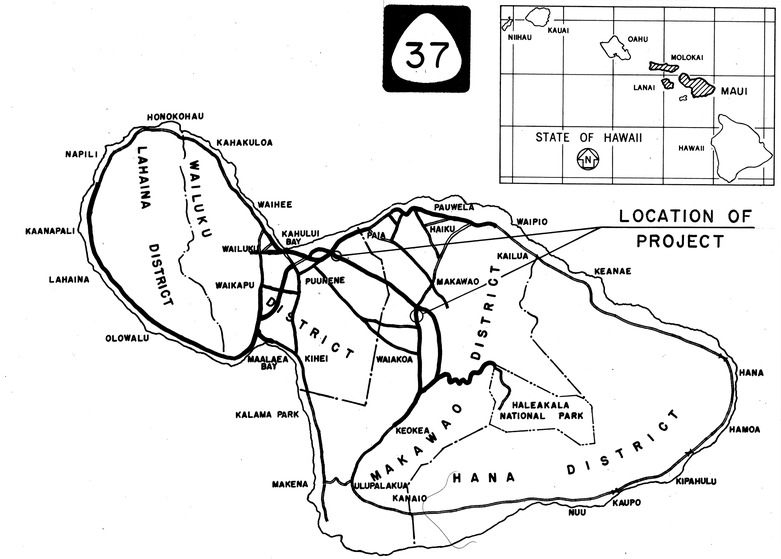

N

5 0 5 10
SCALE IN MILES

FEDERAL AID PROJECTS PREVIOUSLY CONSTRUCTED OR UNDER CONSTRUCTION

ALL CHANGES MADE DURING CONSTRUCTION HAVE BEEN NOTED IN RED ON THESE TRACINGS AND CHECKED BY

George N. Kaya — RESIDENT ENGINEER
10-27-80 — DATE

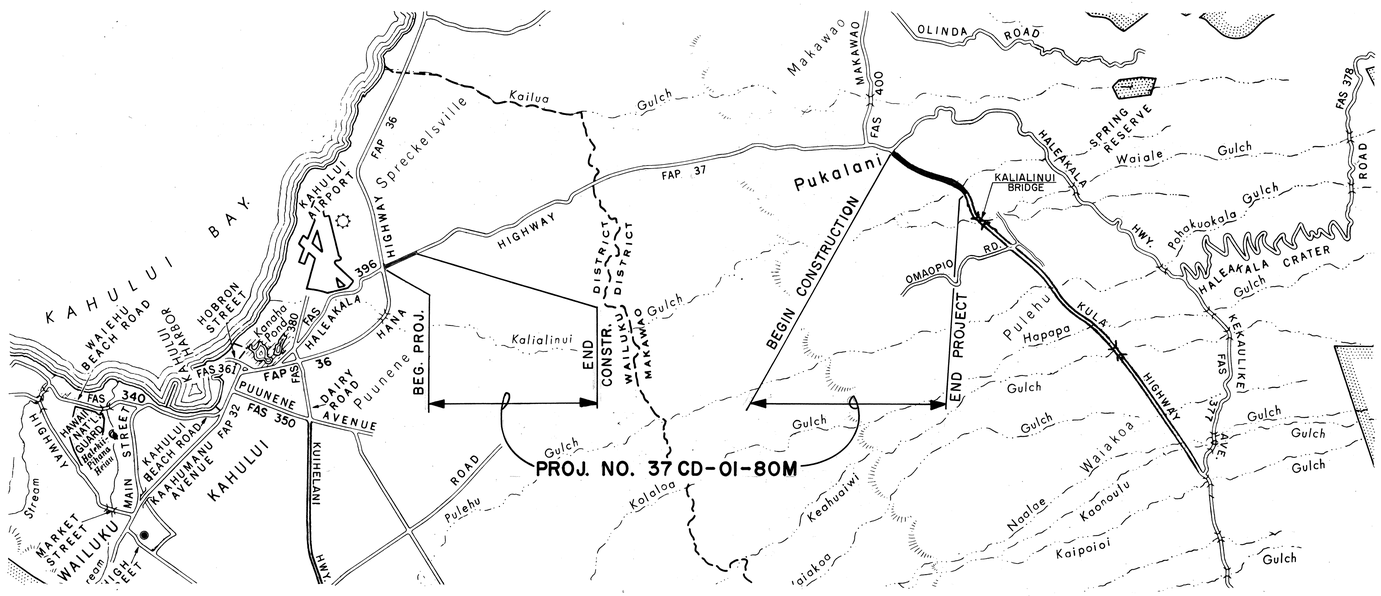

0 1 2 3 4
SCALE IN MILES

LAYOUT PLAN

LENGTH OF PROJECT . . . 0.58 MILES (HALEAKALA HWY.)
LENGTH OF PROJECT . . . 1.23 MILES (KULA HWY.)

DEPARTMENT OF TRANSPORTATION STATE OF HAWAII	
APPROVED: Ryokichi Higashionna	May 5, 1980
DIR. OF TRANSPORTATION	DATE

Mike Miura	Mike Miura	548-7490	May, 1980
DESIGNED BY	P. S. & E. BY	PHONE	DATE