FED. ROAD DIST. NO.	STATE	PROJ. NO.	FISCAL YEAR	SHEET NO.	TOTAL SHEETS
HAWAII	HAW.	37C-02-82	1984	13	29

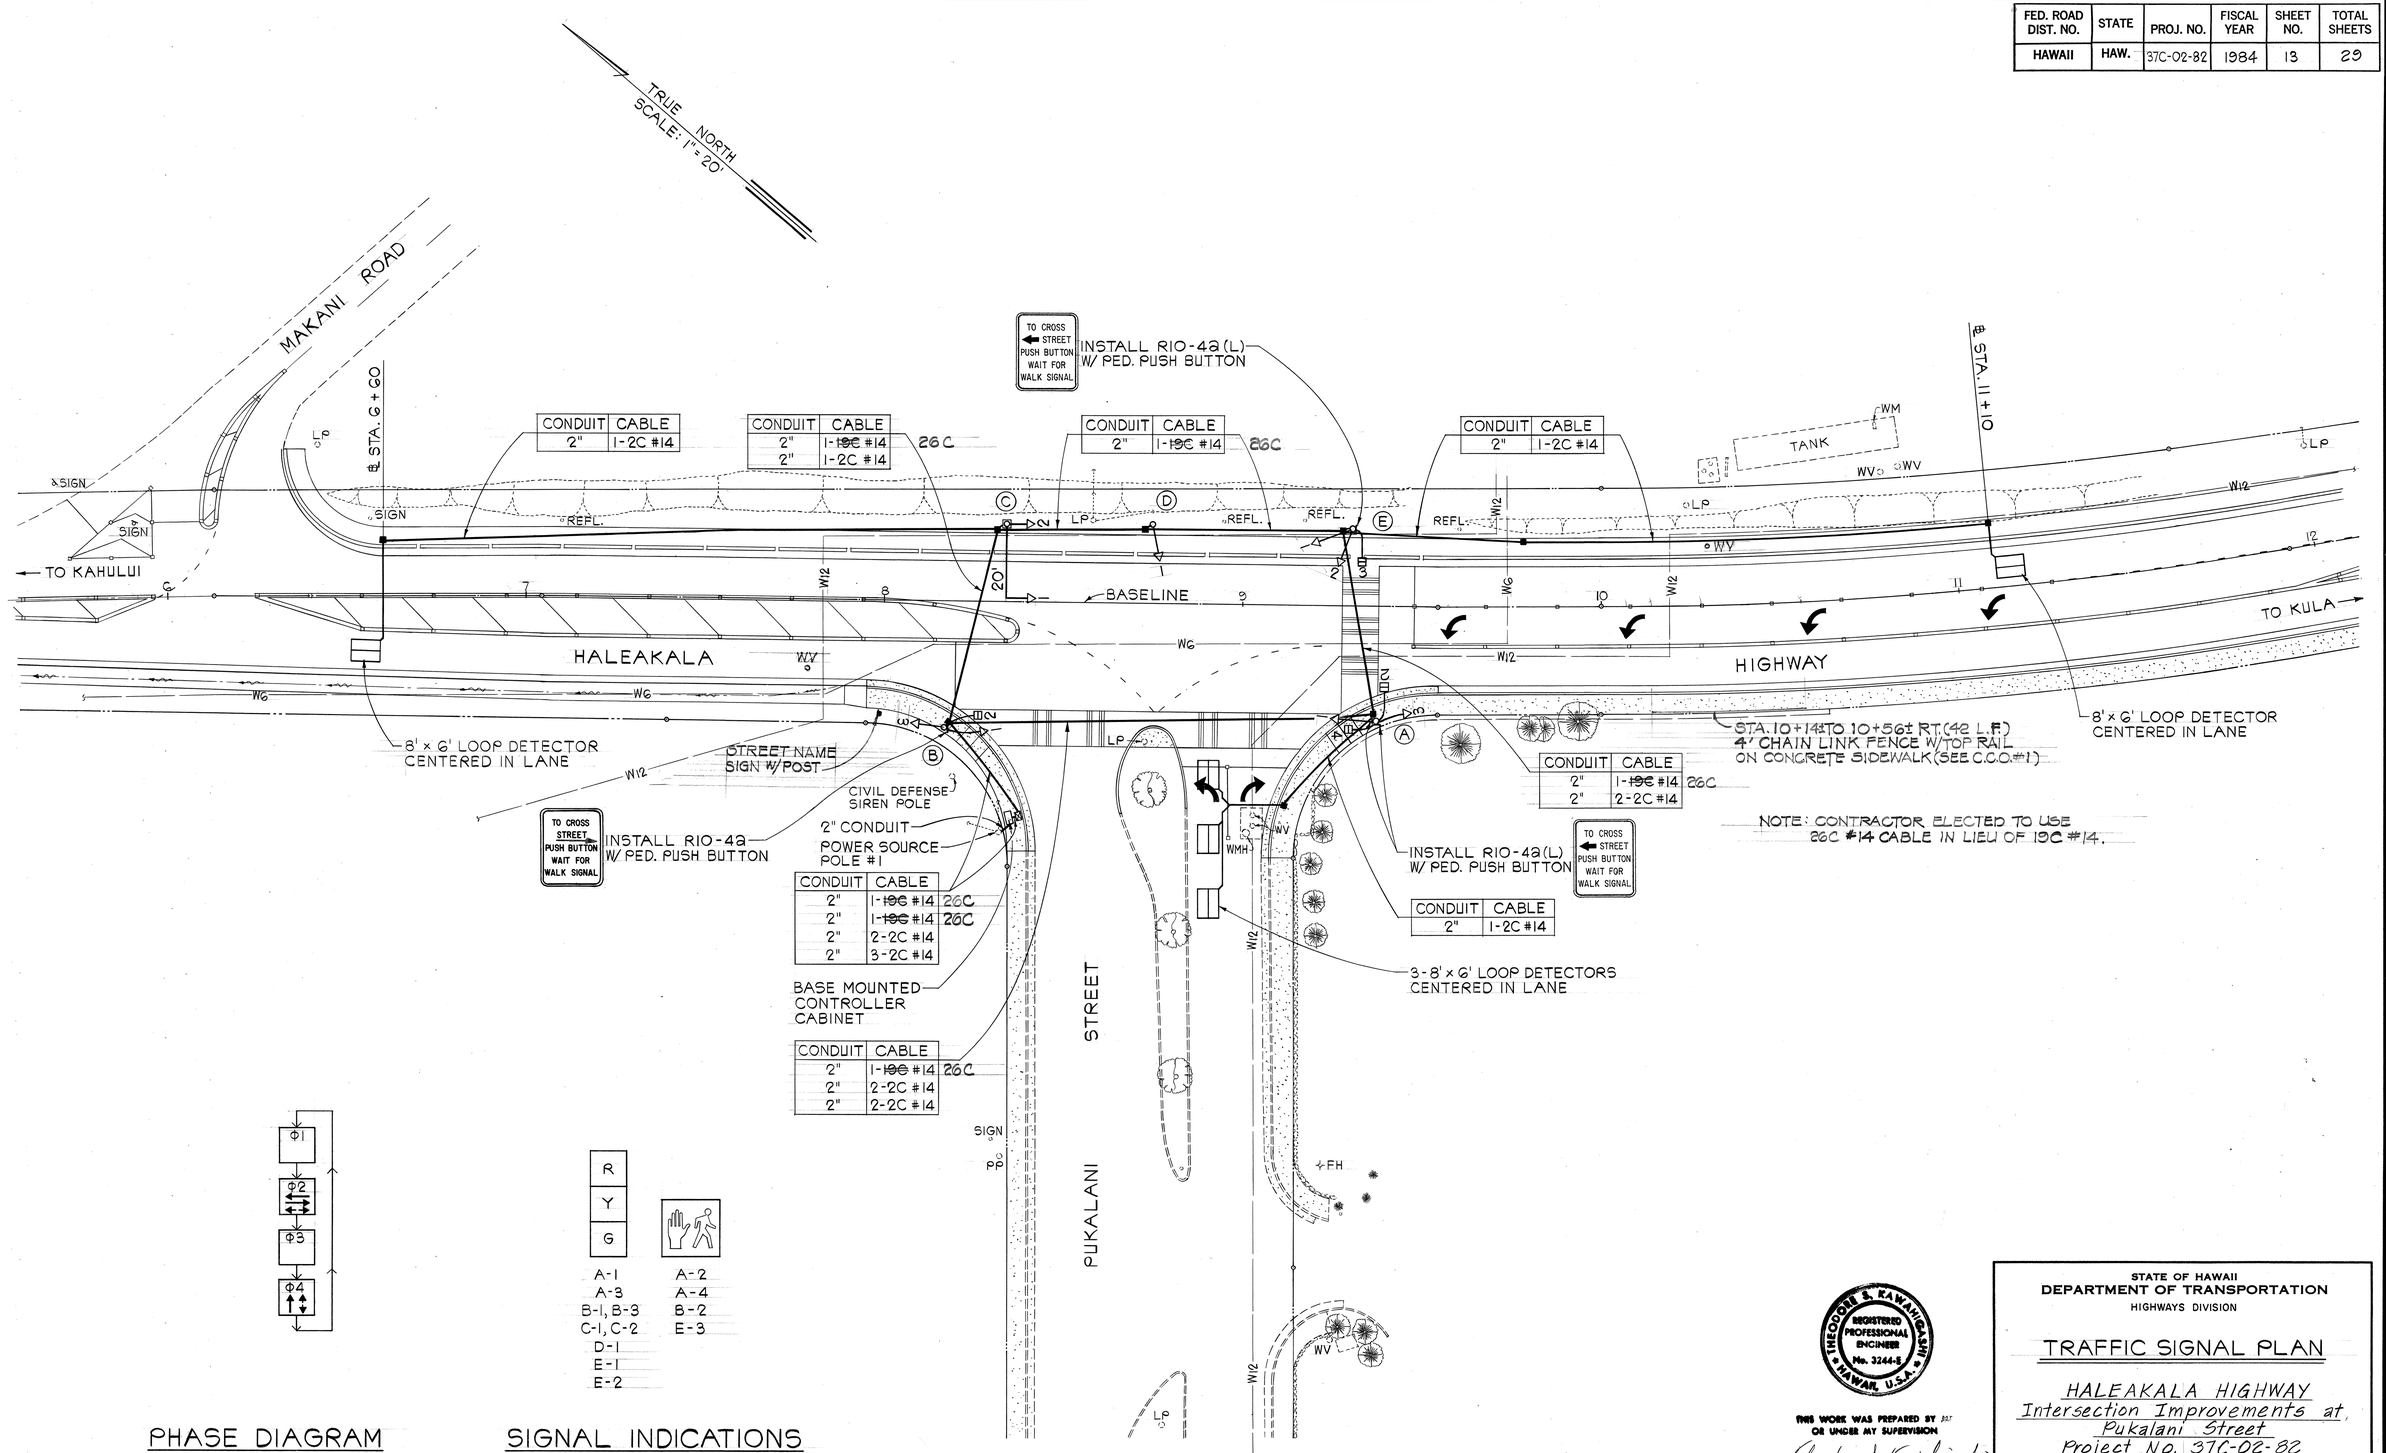

PHASE DIAGRAM

SIGNAL INDICATIONS

ORIGINAL PLAN		DATE
	SURVEY PLOTTED BY	
	DRAWN BY	
	TRACED BY	
NOTE BOOK	DESIGNED BY	
No.	QUANTITIES BY	
	CHECKED BY	

THEODORE S. KAWAHIGASHI REGISTERED PROFESSIONAL ENGINEER No. 3244-E HAWAII, U.S.A.

THIS WORK WAS PREPARED BY ME OR UNDER MY SUPERVISION

Theodore S. Kawahigashi
Signature

STATE OF HAWAII
DEPARTMENT OF TRANSPORTATION
HIGHWAYS DIVISION

TRAFFIC SIGNAL PLAN

HALEAKALA HIGHWAY
Intersection Improvements at Pukalani Street
Project No. 37C-02-82

SCALE: AS SHOWN DATE: 1-15-82

SHEET No. 1 OF 1 SHEETS