
FED. ROAD DIST. NO.	STATE	PROJ. NO.	FISCAL YEAR	SHEET NO.	TOTAL SHEETS
HAWAII	HAW.	37D-01-90	1990	34	50

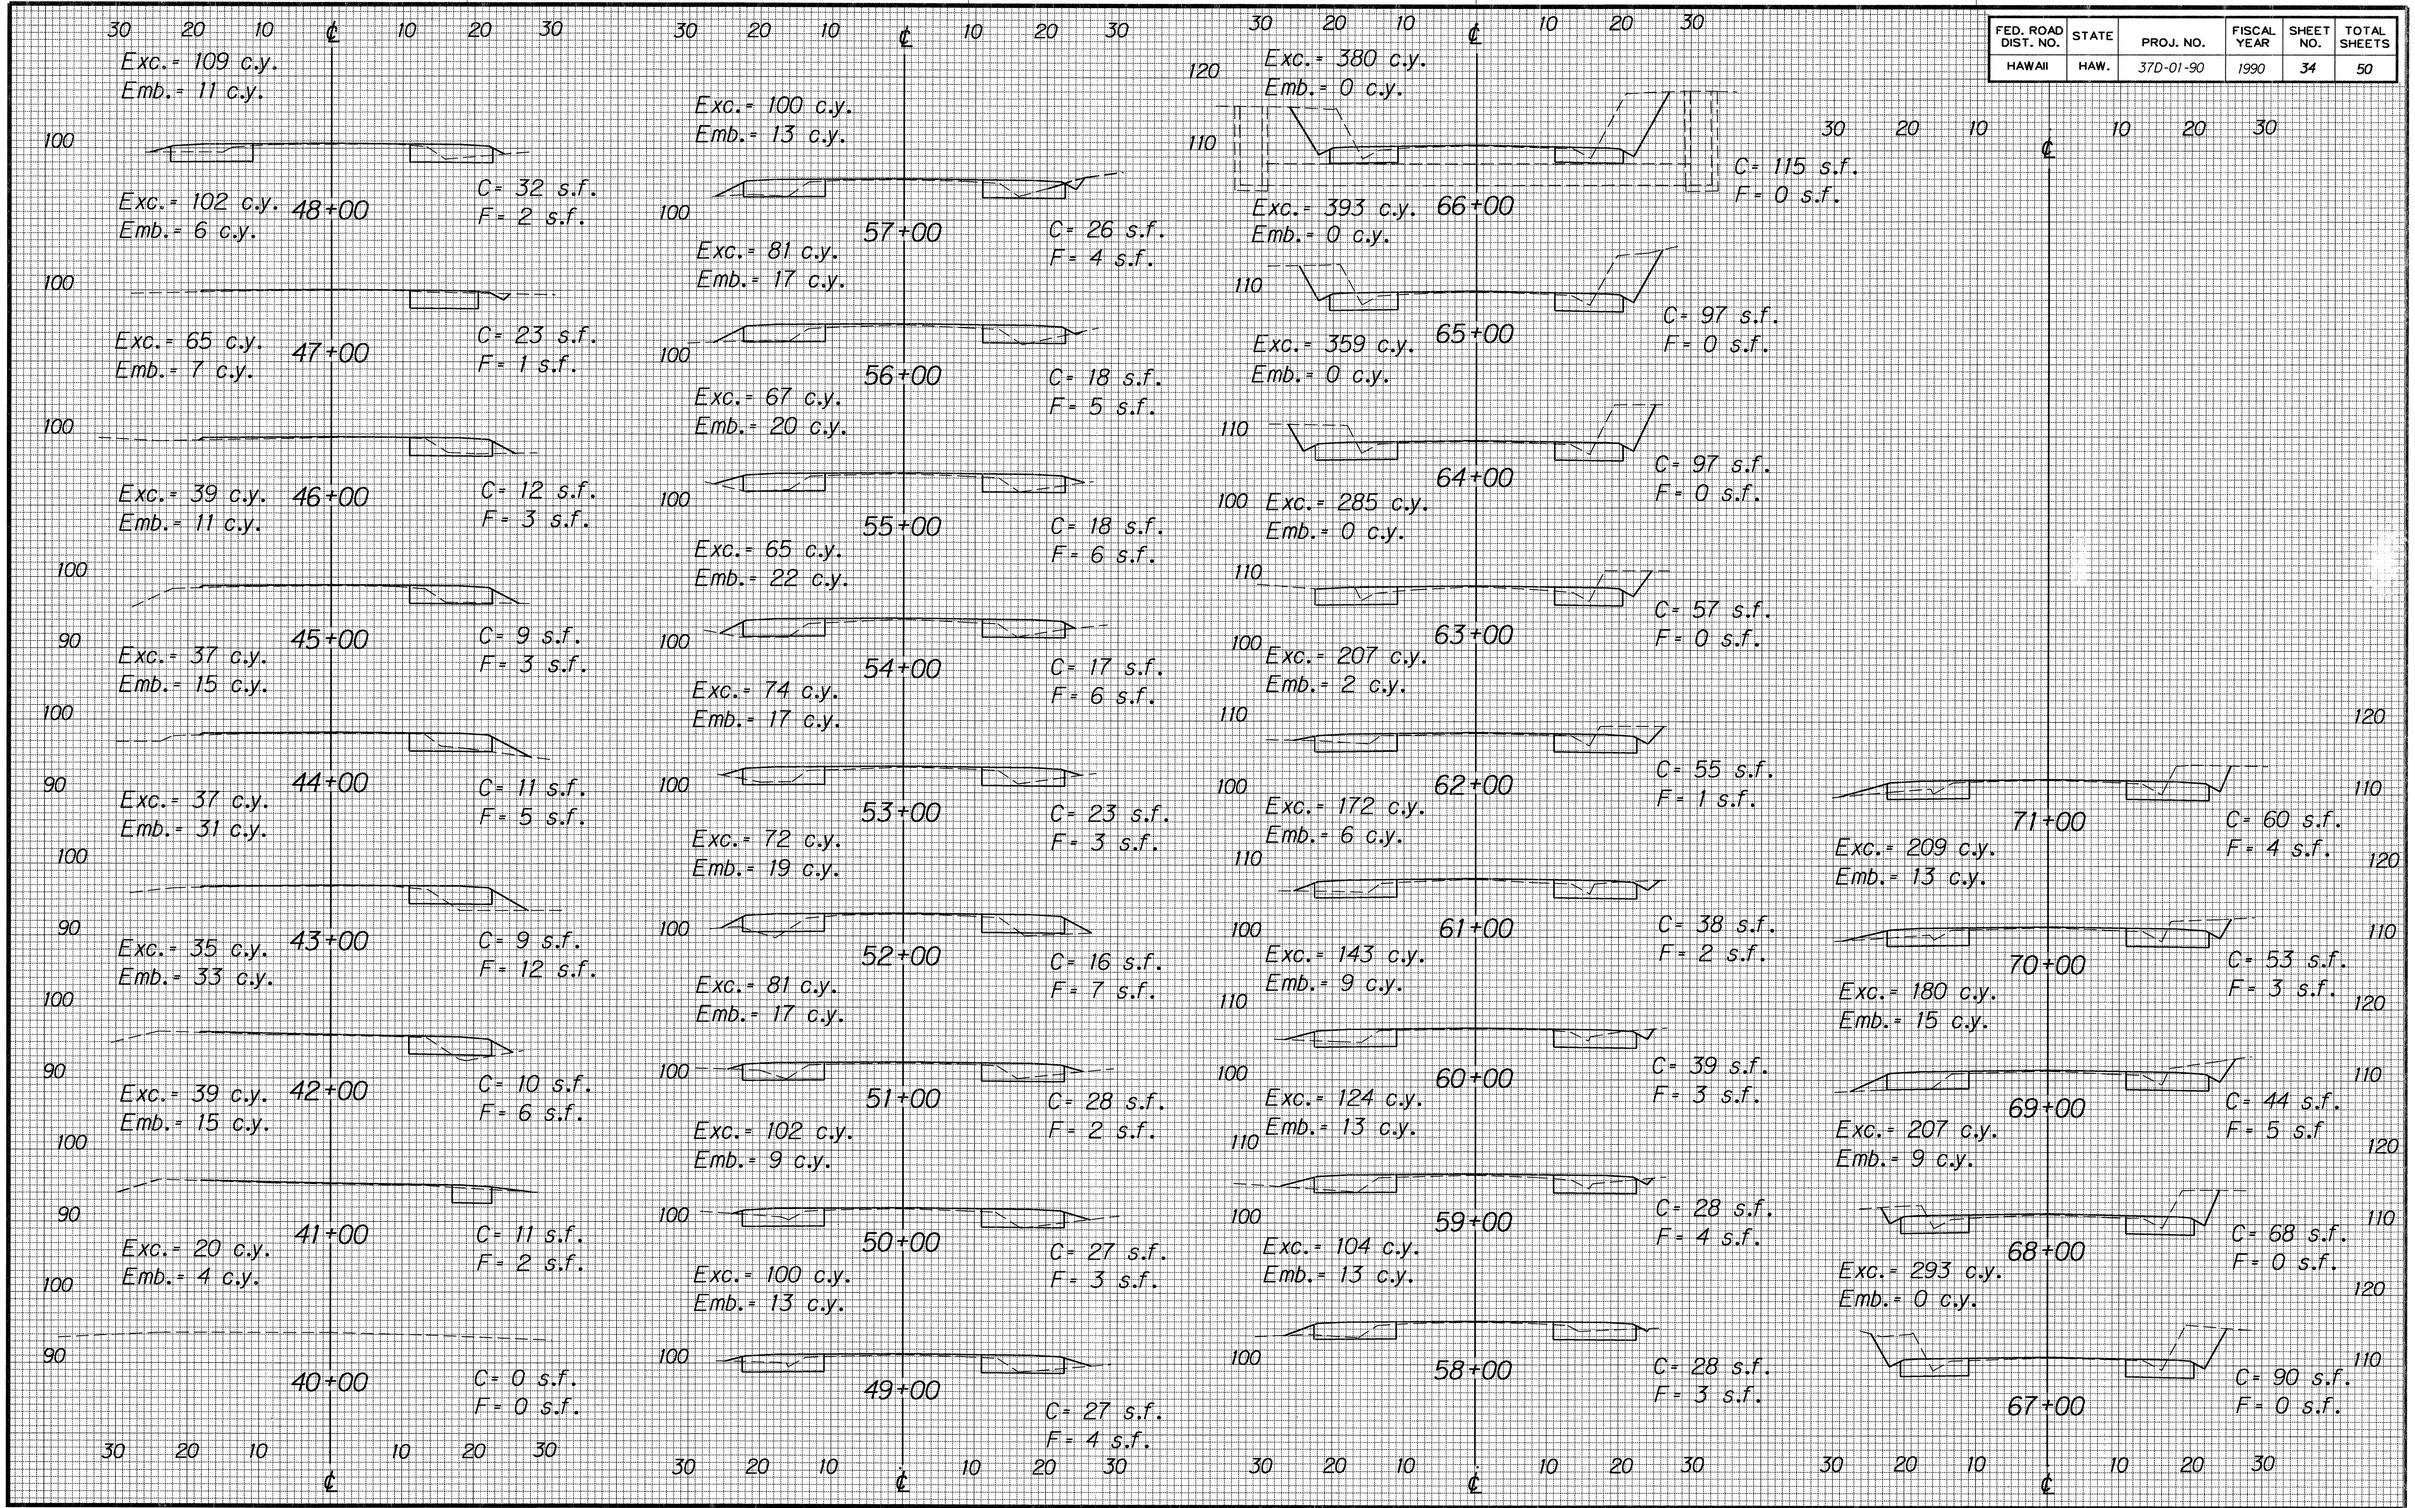


ORIGINAL PLAN

NOTE BOOK No.


SURVEY PLOTTED BY DATE
DRAWN BY
TRACED BY
DESIGNED BY
QUANTITIES BY
CHECKED BY

FED. ROAD DIST. NO.	STATE	PROJ. NO.	FISCAL YEAR	SHEET NO.	TOTAL SHEETS
HAWAII	HAW.	37D-01-90	1990	35	50

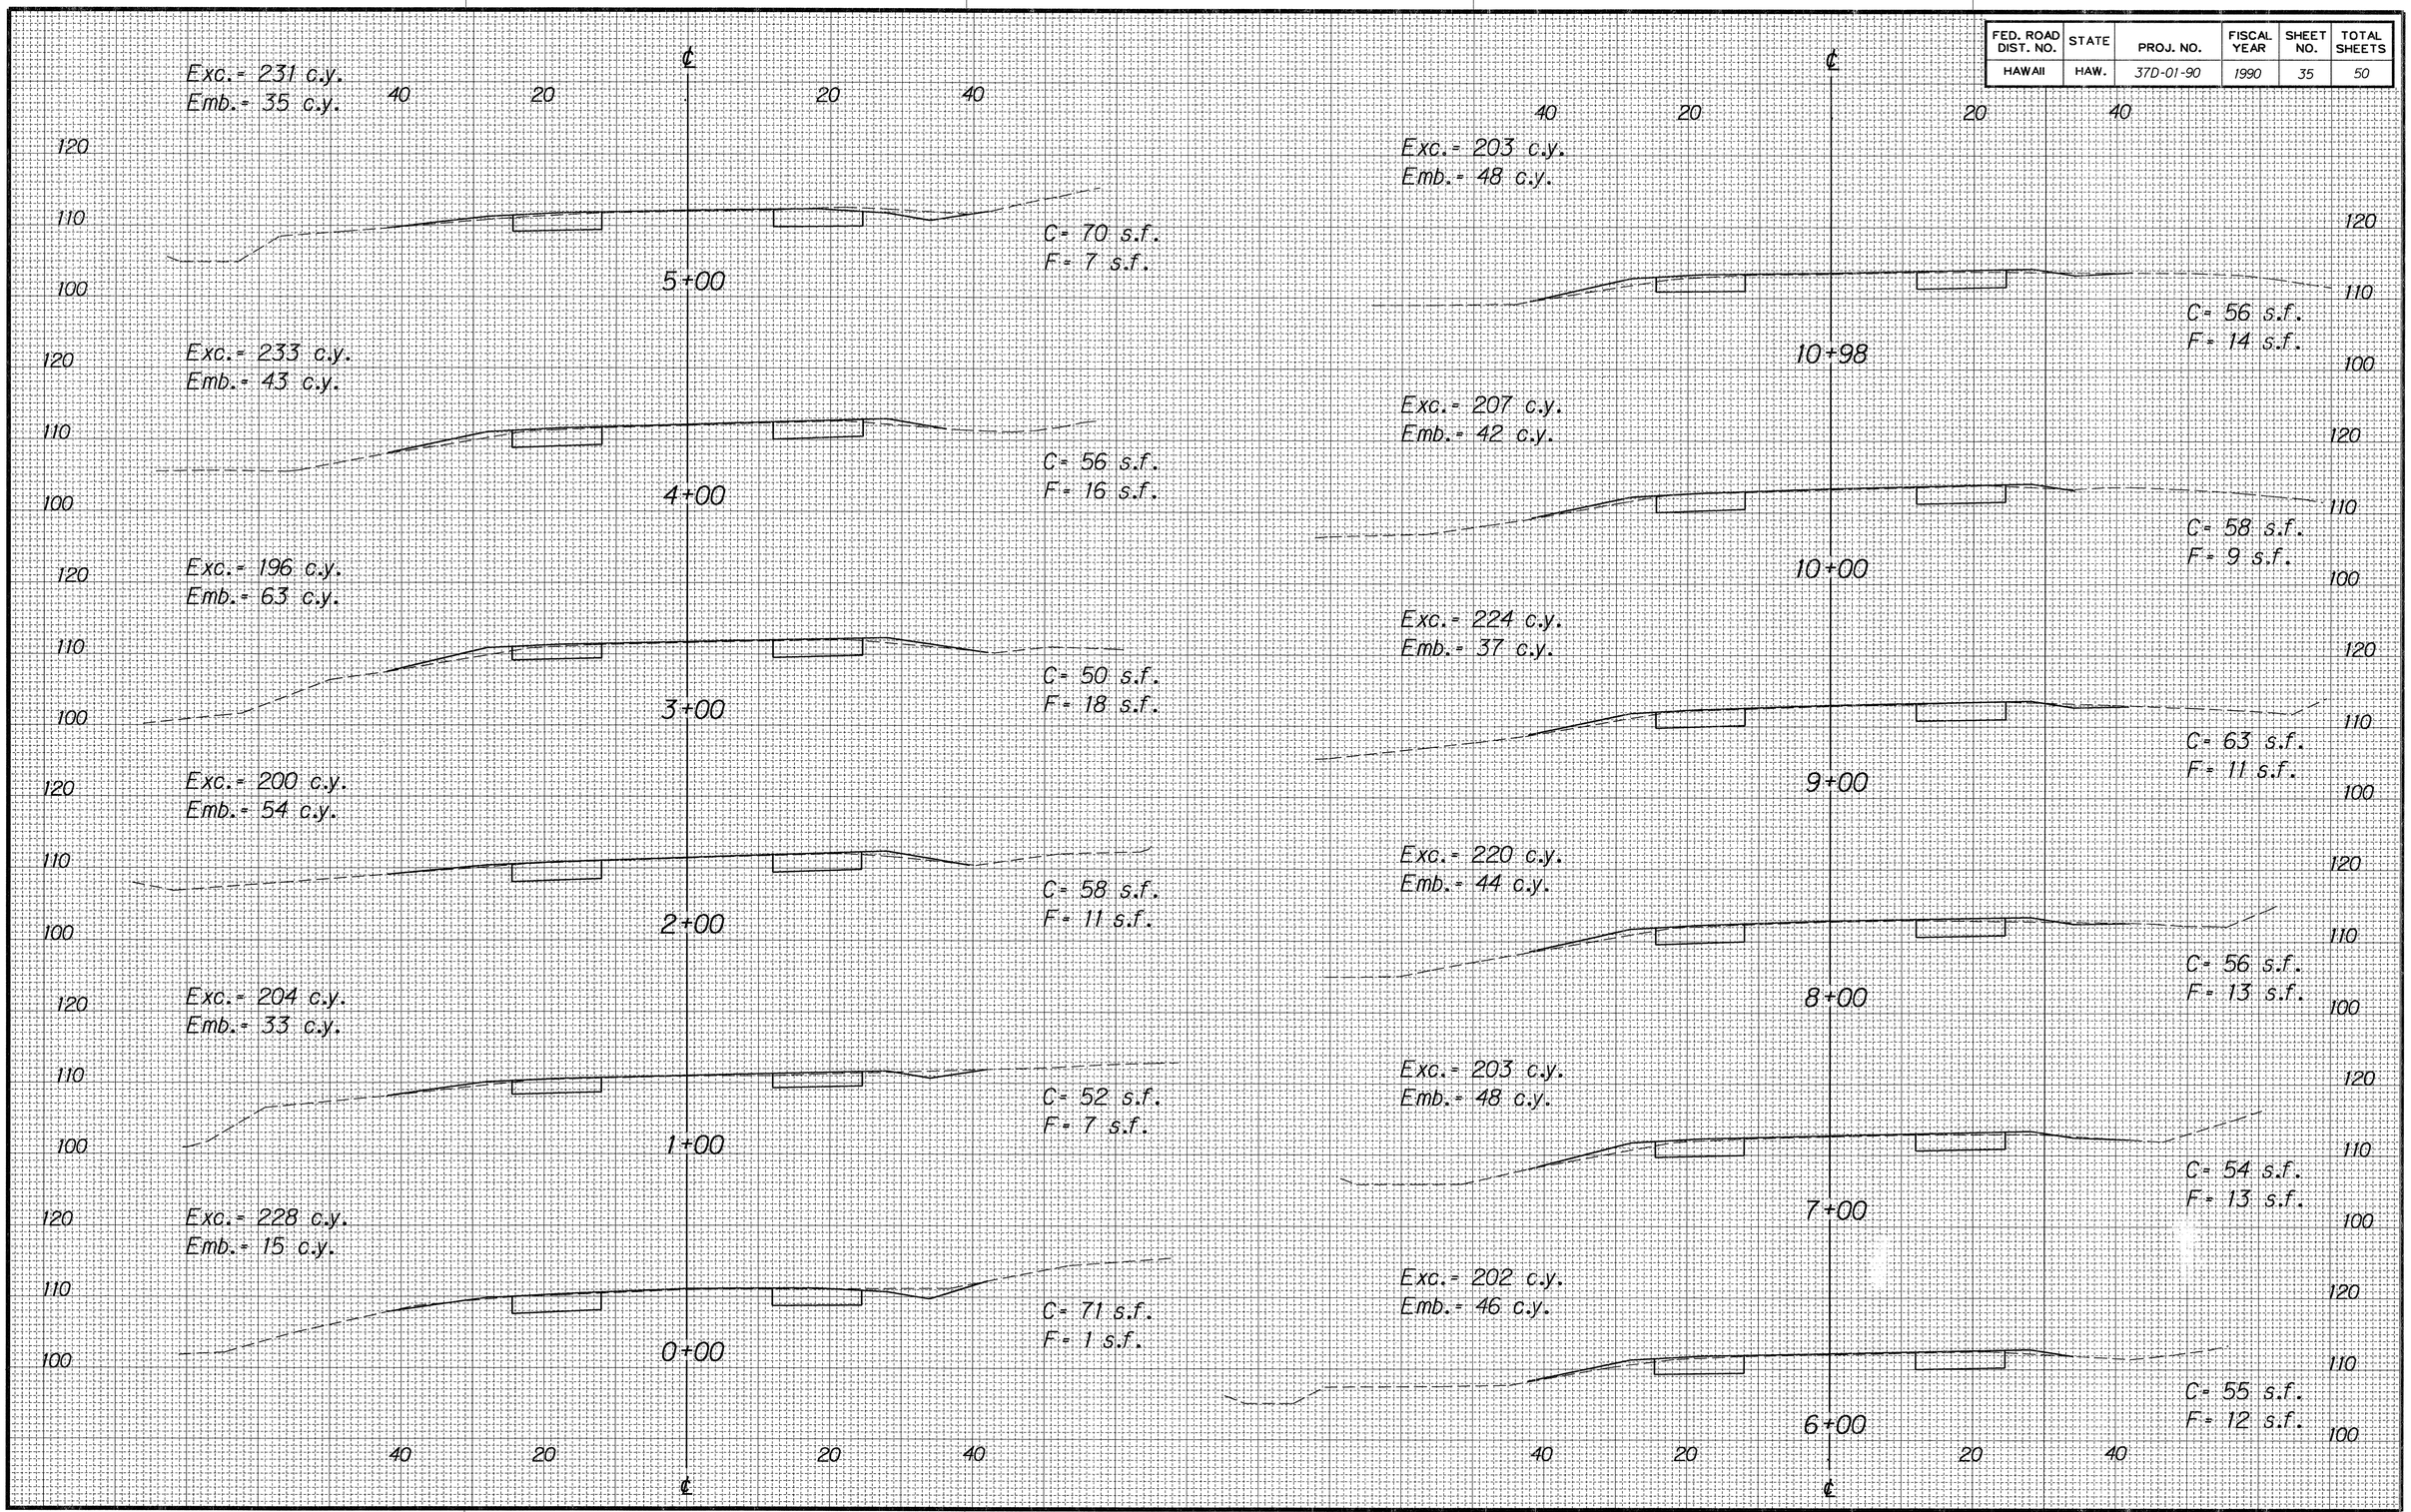

ORIGINAL PLAN	SURVEY PLOTTED BY	DATE
	DRAWN BY	
	TRACED BY	
NOTE BOOK	DESIGNED BY	
	QUANTITIES BY	
No.	CHECKED BY	

FED. ROAD DIST. NO.	STATE	PROJ. NO.	FISCAL YEAR	SHEET NO.	TOTAL SHEETS
HAWAII	HAW.	37D-01-90	1990	36	50

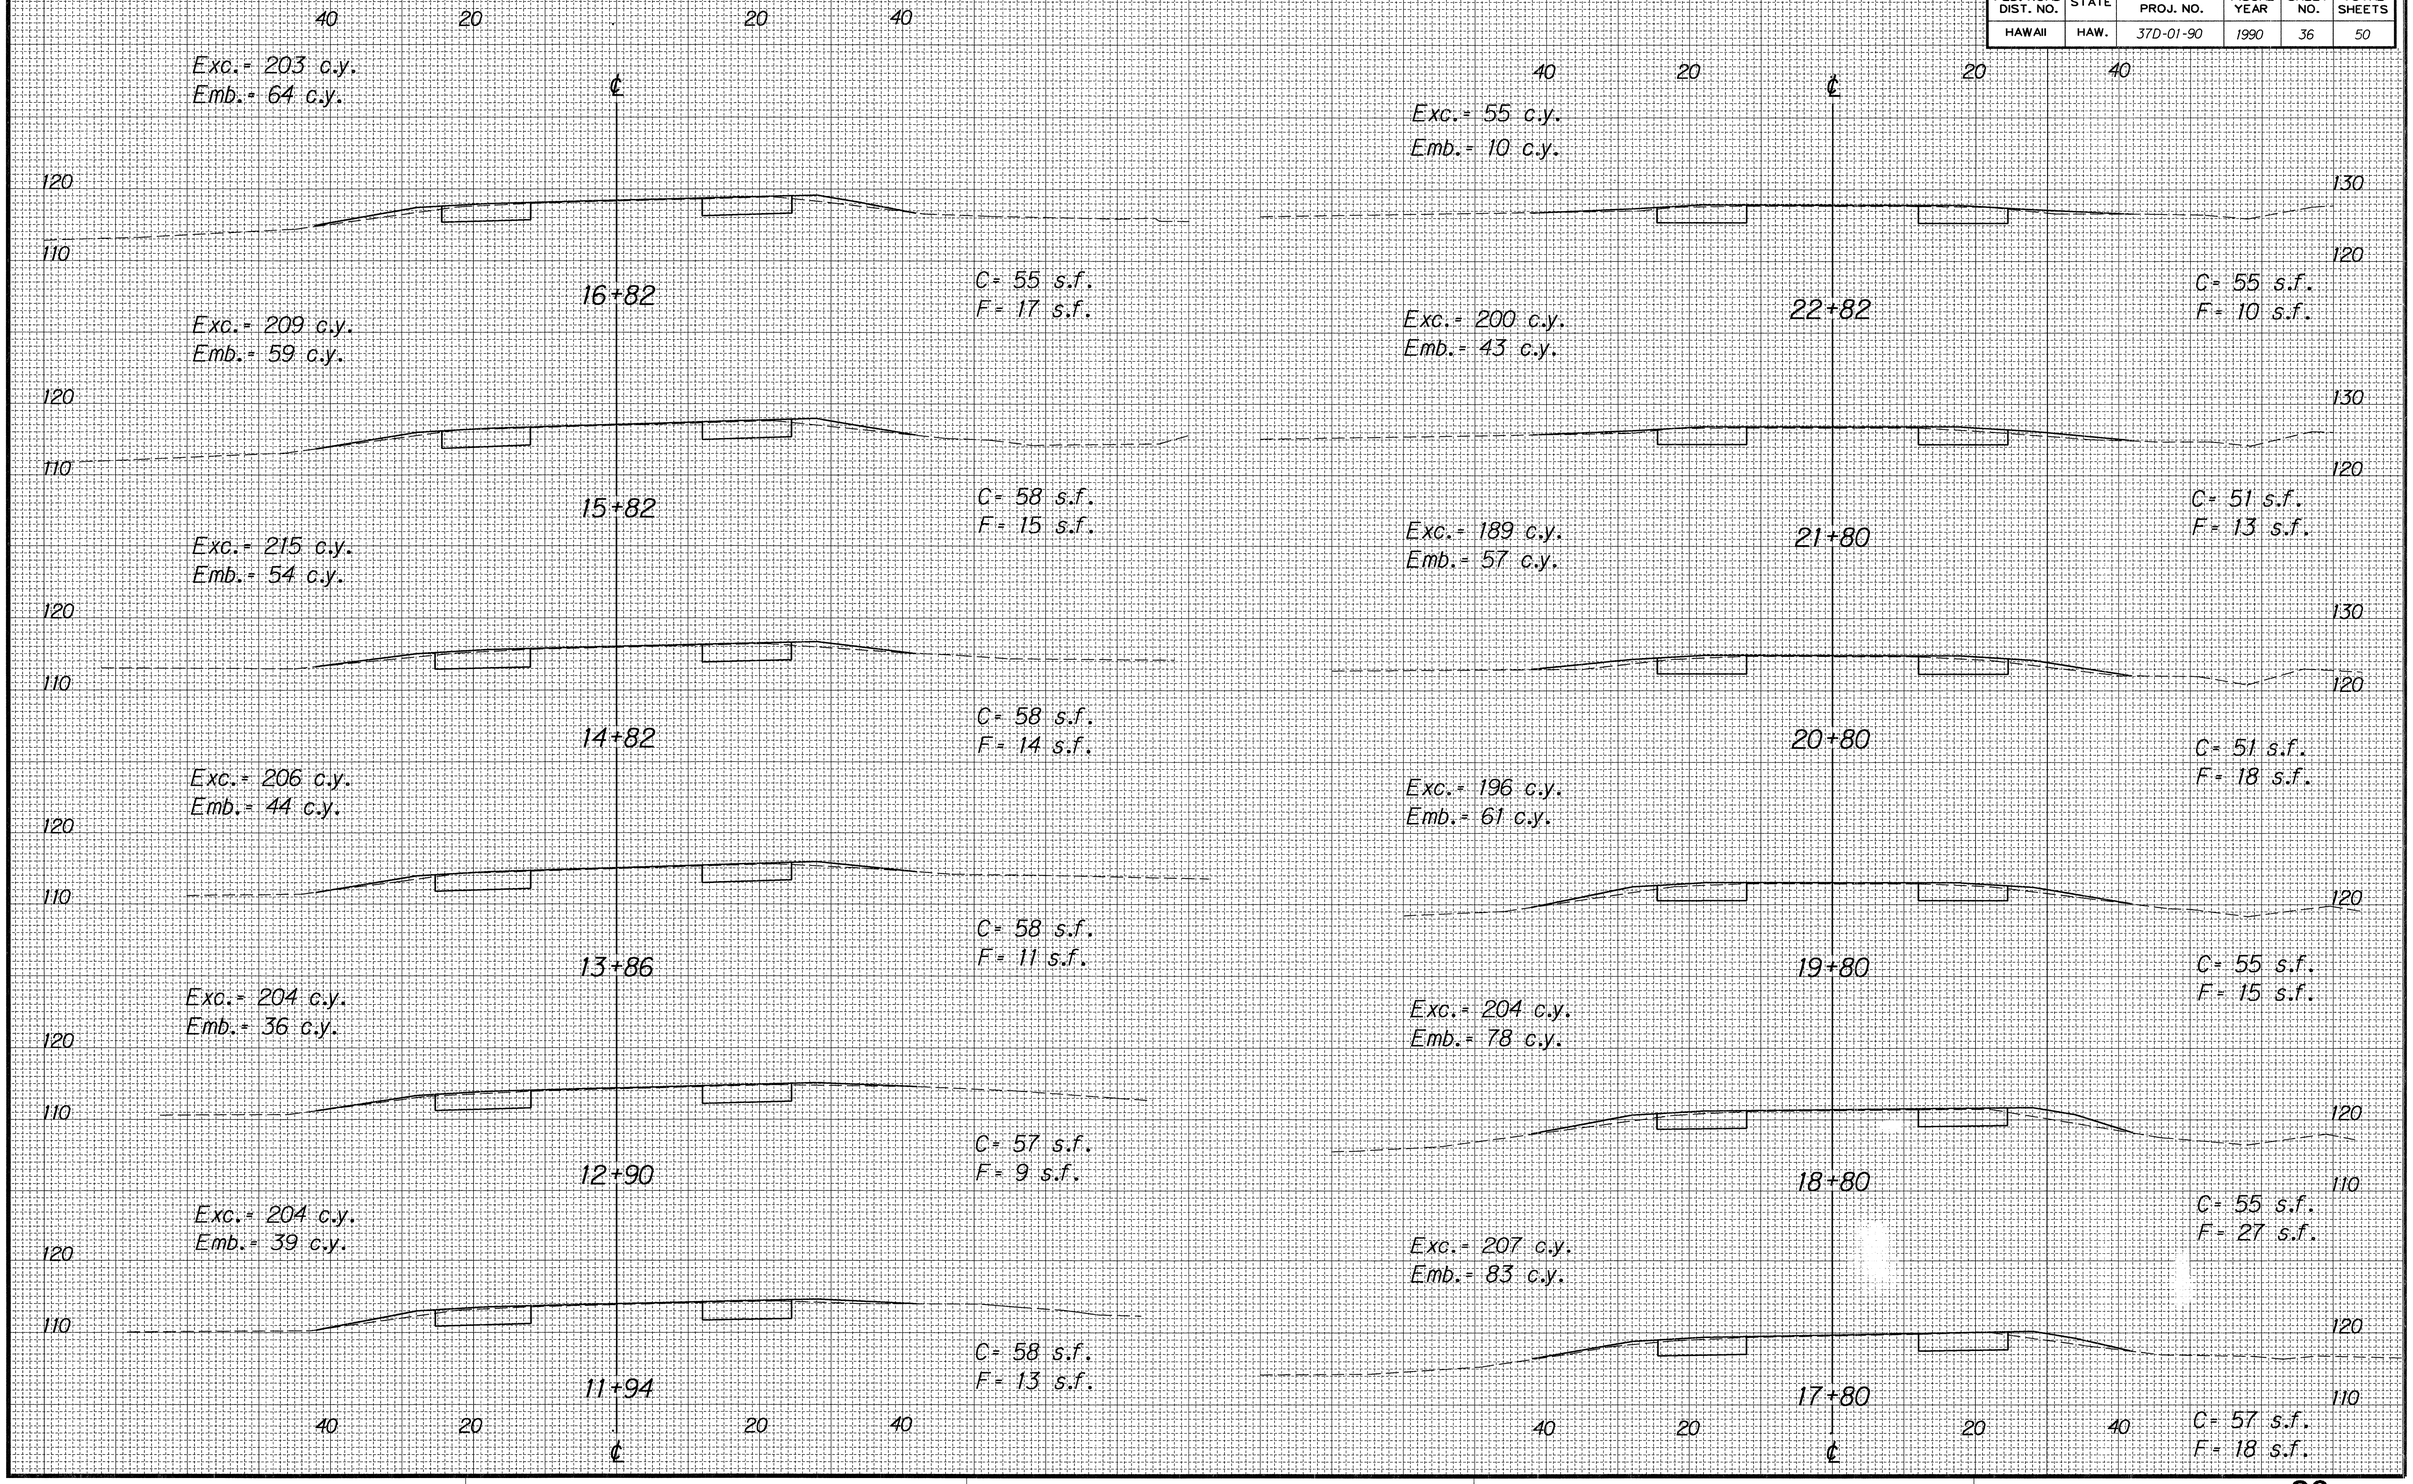


ORIGINAL PLAN

NOTE BOOK _____ No. _____

SURVEY PLOTTED BY _____ DATE _____
DRAWN BY _____
TRACED BY _____
DESIGN BY _____
QUANTITIES BY _____
CHECKED BY _____

FED. ROAD DIST. NO.	STATE	PROJ. NO.	FISCAL YEAR	SHEET NO.	TOTAL SHEETS
HAWAII	HAW.	37D-01-90	1990	37	50

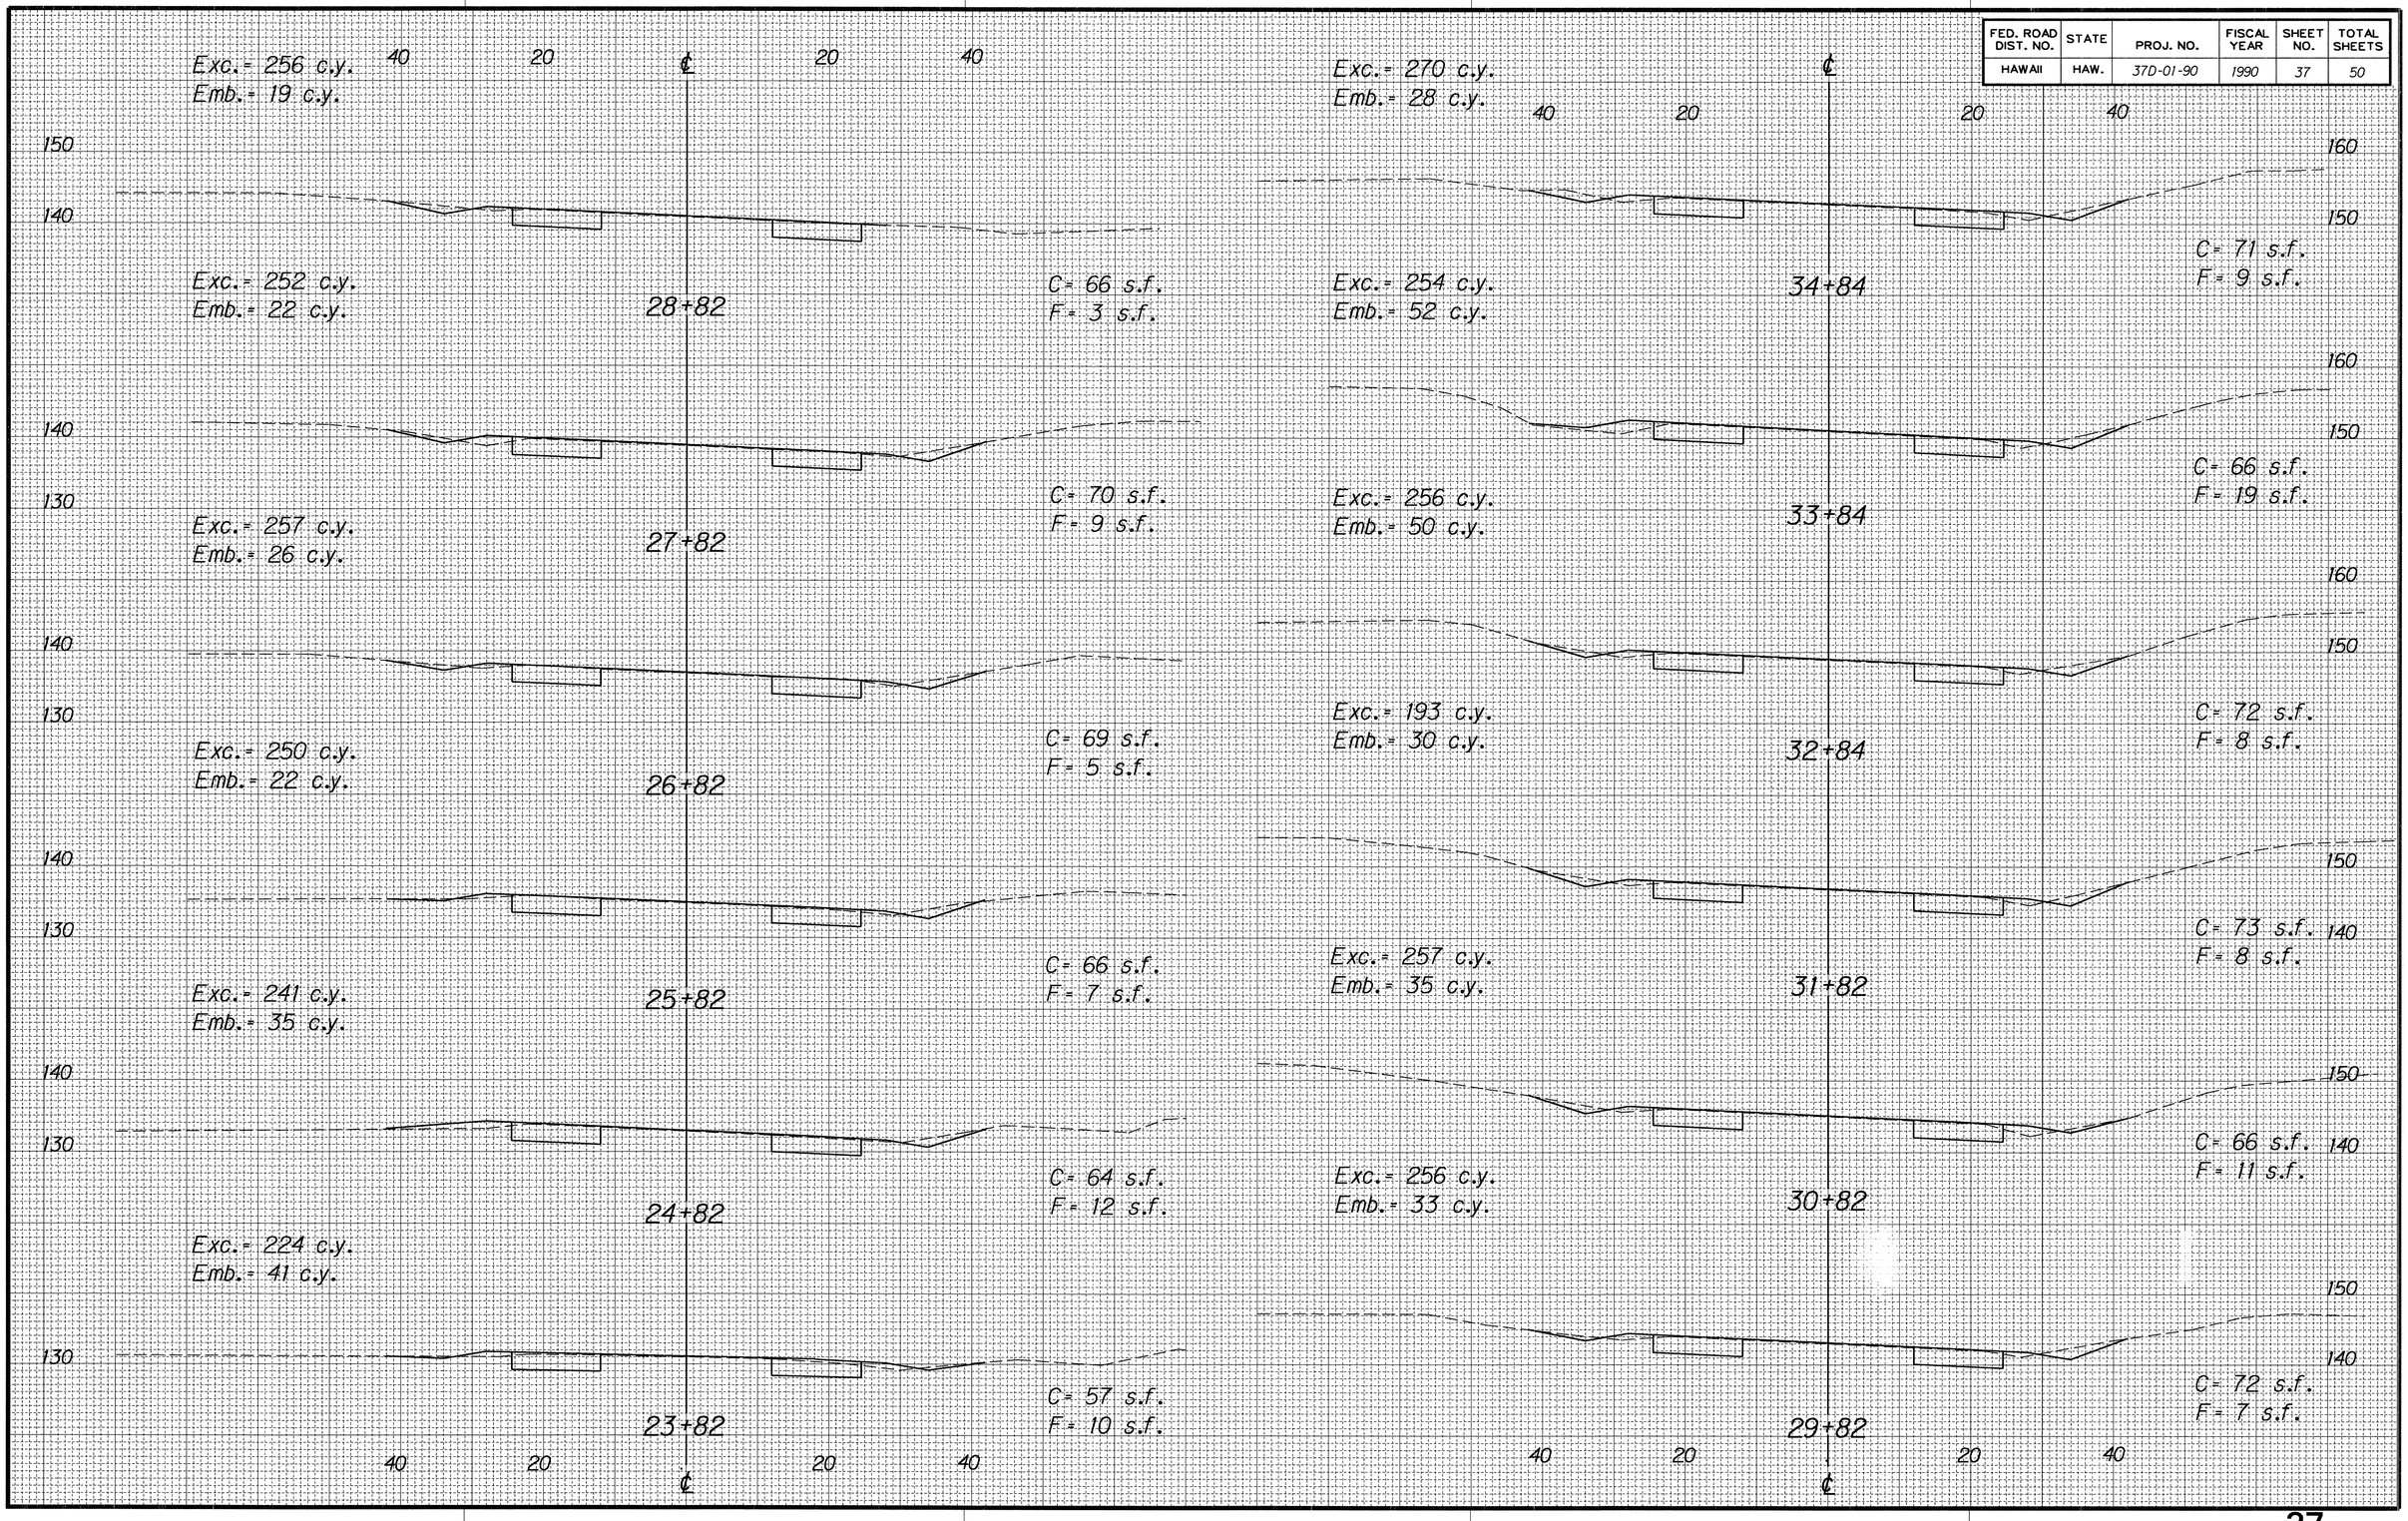


ORIGINAL PLAN

NOTE BOOK _____ No. _____


SURVEY PLOTTED BY _____ DATE _____
DRAWN BY _____
TRACED BY _____
DESIGNED BY _____
QUANTITIES BY _____
CHECKED BY _____

FED. ROAD DIST. NO.	STATE	PROJ. NO.	FISCAL YEAR	SHEET NO.	TOTAL SHEETS
HAWAII	HAW.	37D-01-90	1990	38	50

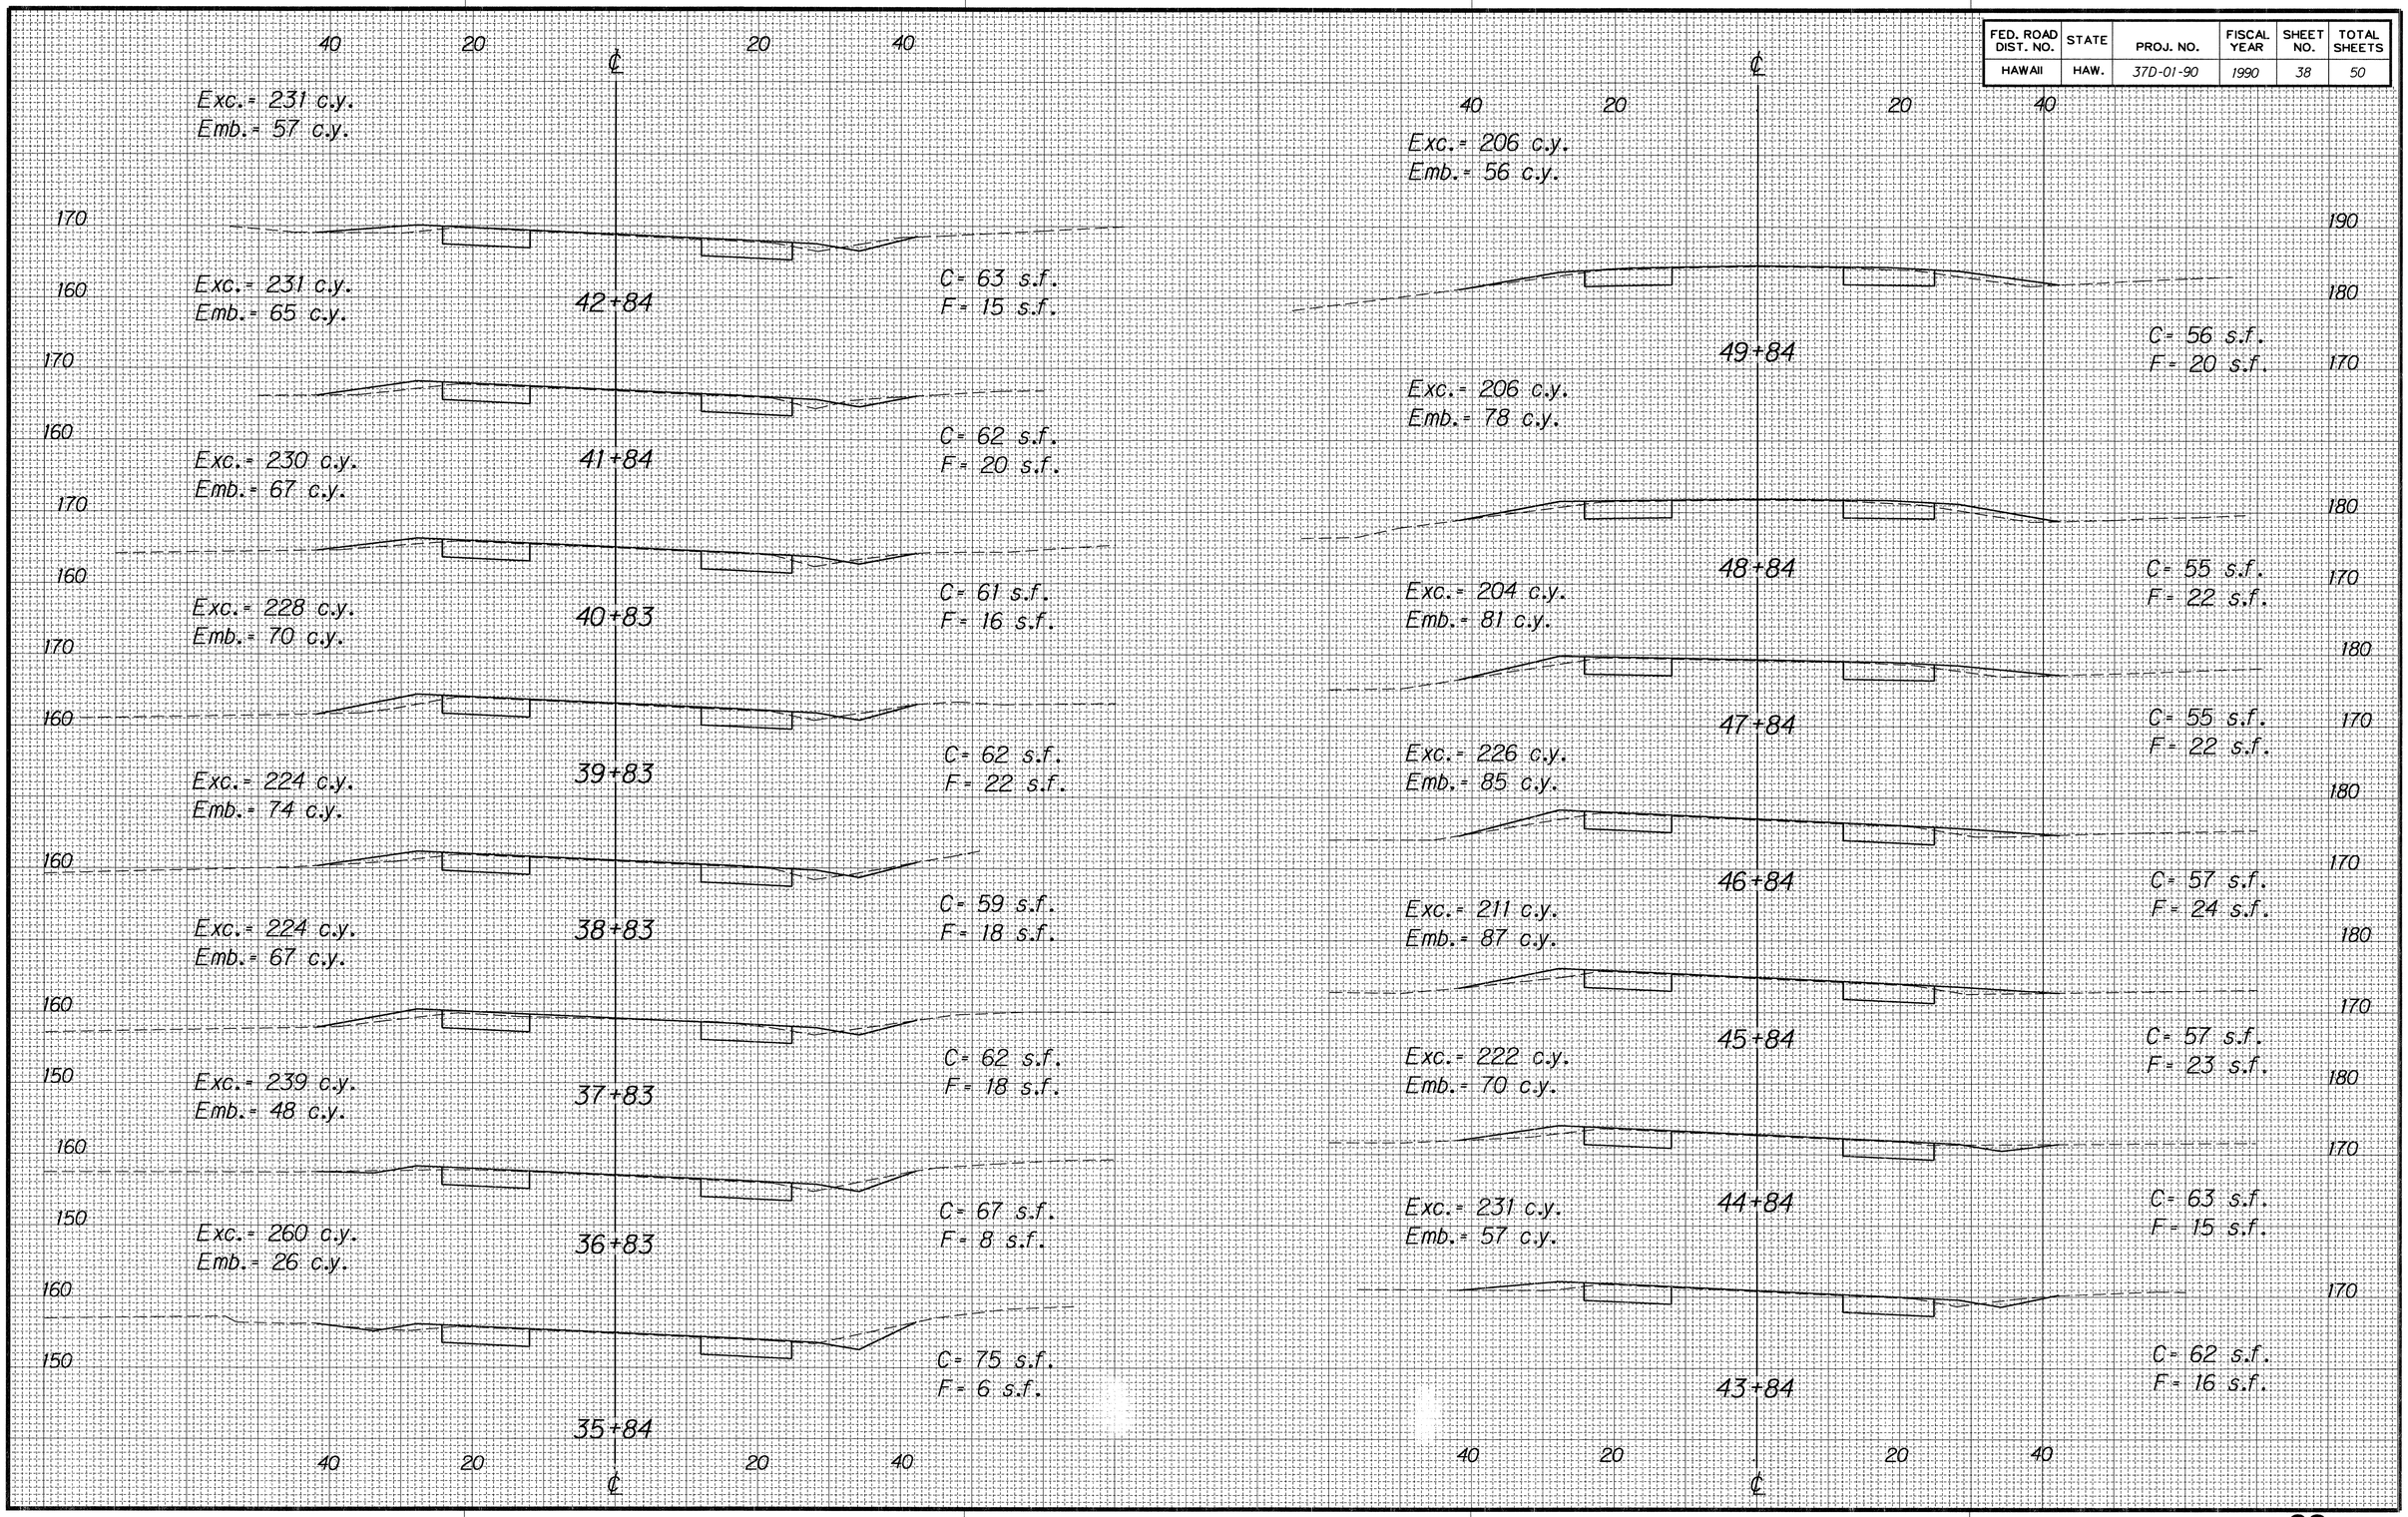


ORIGINAL PLAN	SURVEY PLOTTED BY	DATE
	DRAWN BY	
	TRACED BY	
NOTE BOOK	DESIGNED BY	
No.	QUANTITIES BY	
	CHECKED BY	

FED. ROAD DIST. NO.	STATE	PROJ. NO.	FISCAL YEAR	SHEET NO.	TOTAL SHEETS
HAWAII	HAW.	37D-01-90	1990	39	50

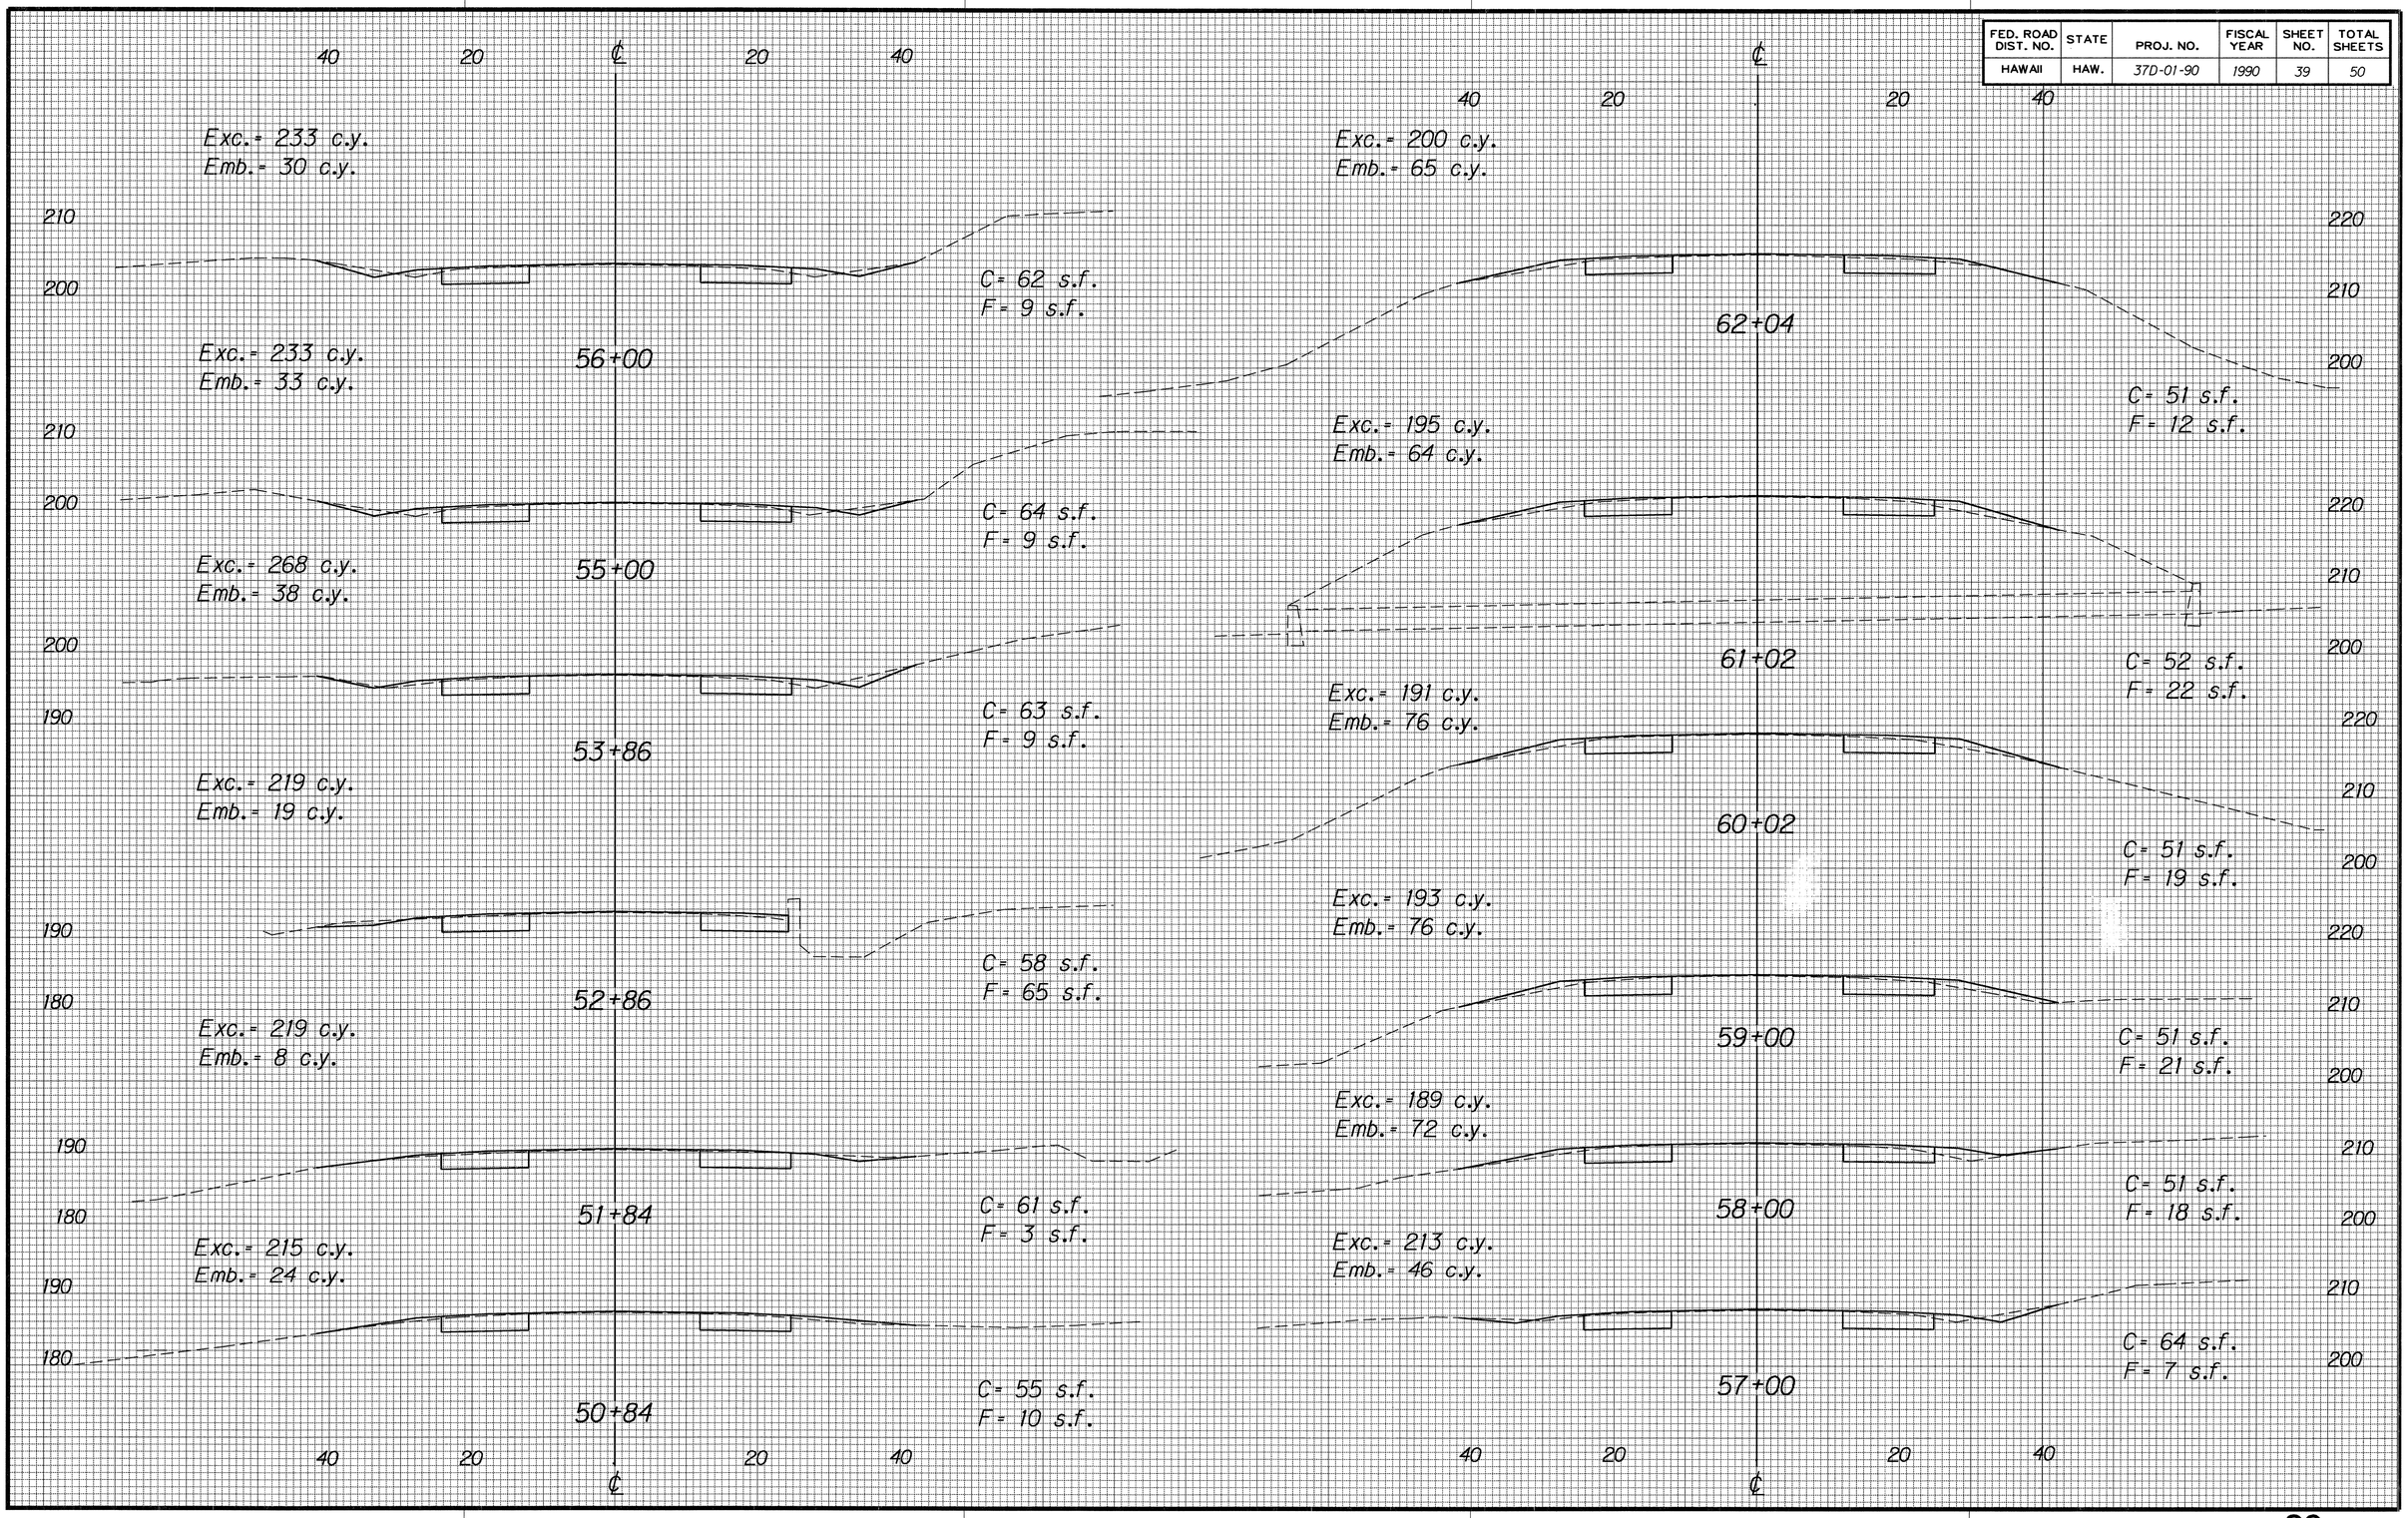


ORIGINAL PLAN	SURVEY PLOTTED BY	DATE
	DRAWN BY	
	TRACED BY	
NOTE BOOK	DESIGNED BY	
	QUANTITIES BY	
No.	CHECKED BY	

FED. ROAD DIST. NO.	STATE	PROJ. NO.	FISCAL YEAR	SHEET NO.	TOTAL SHEETS
HAWAII	HAW.	37D-01-90	1990	40	50

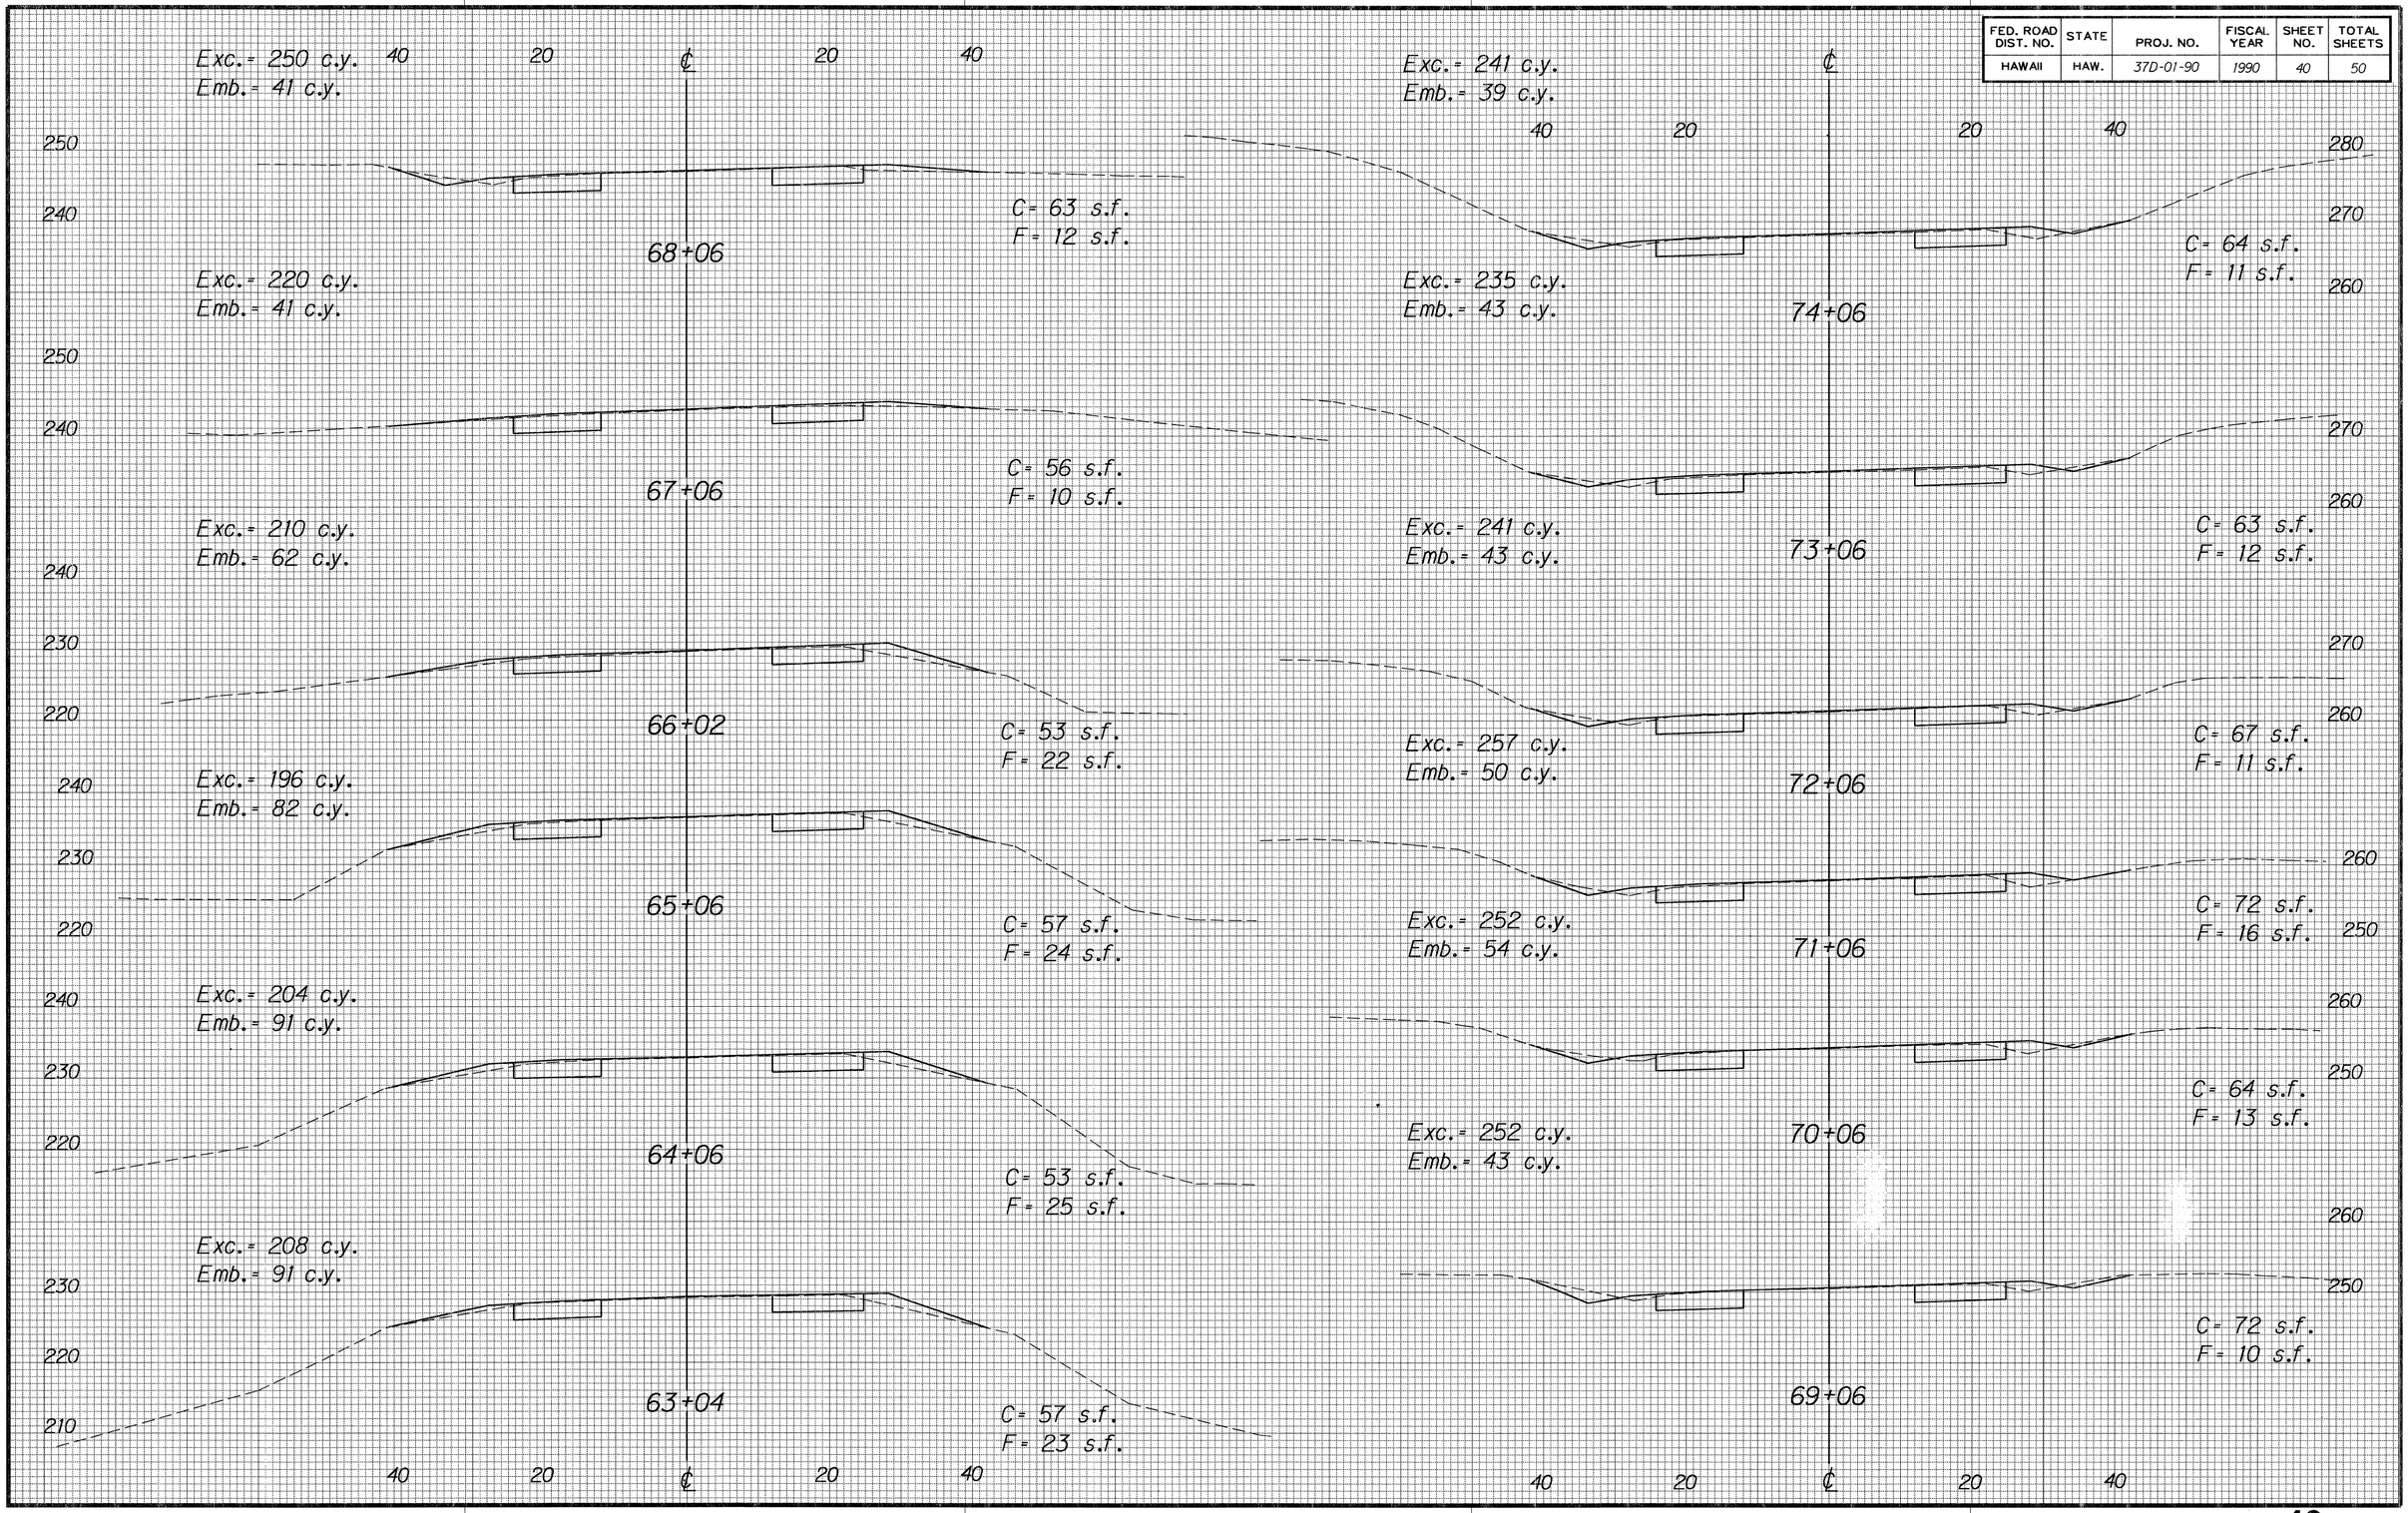

ORIGINAL PLAN	SURVEY PLOTTED BY	DATE
	DRAWN BY	
	TRACED BY	
NOTE BOOK	DESIGNED BY	
No.	QUANTITIES BY	
	CHECKED BY	


FED. ROAD DIST. NO.	STATE	PROJ. NO.	FISCAL YEAR	SHEET NO.	TOTAL SHEETS
HAWAII	HAW.	37D-01-90	1990	41	50

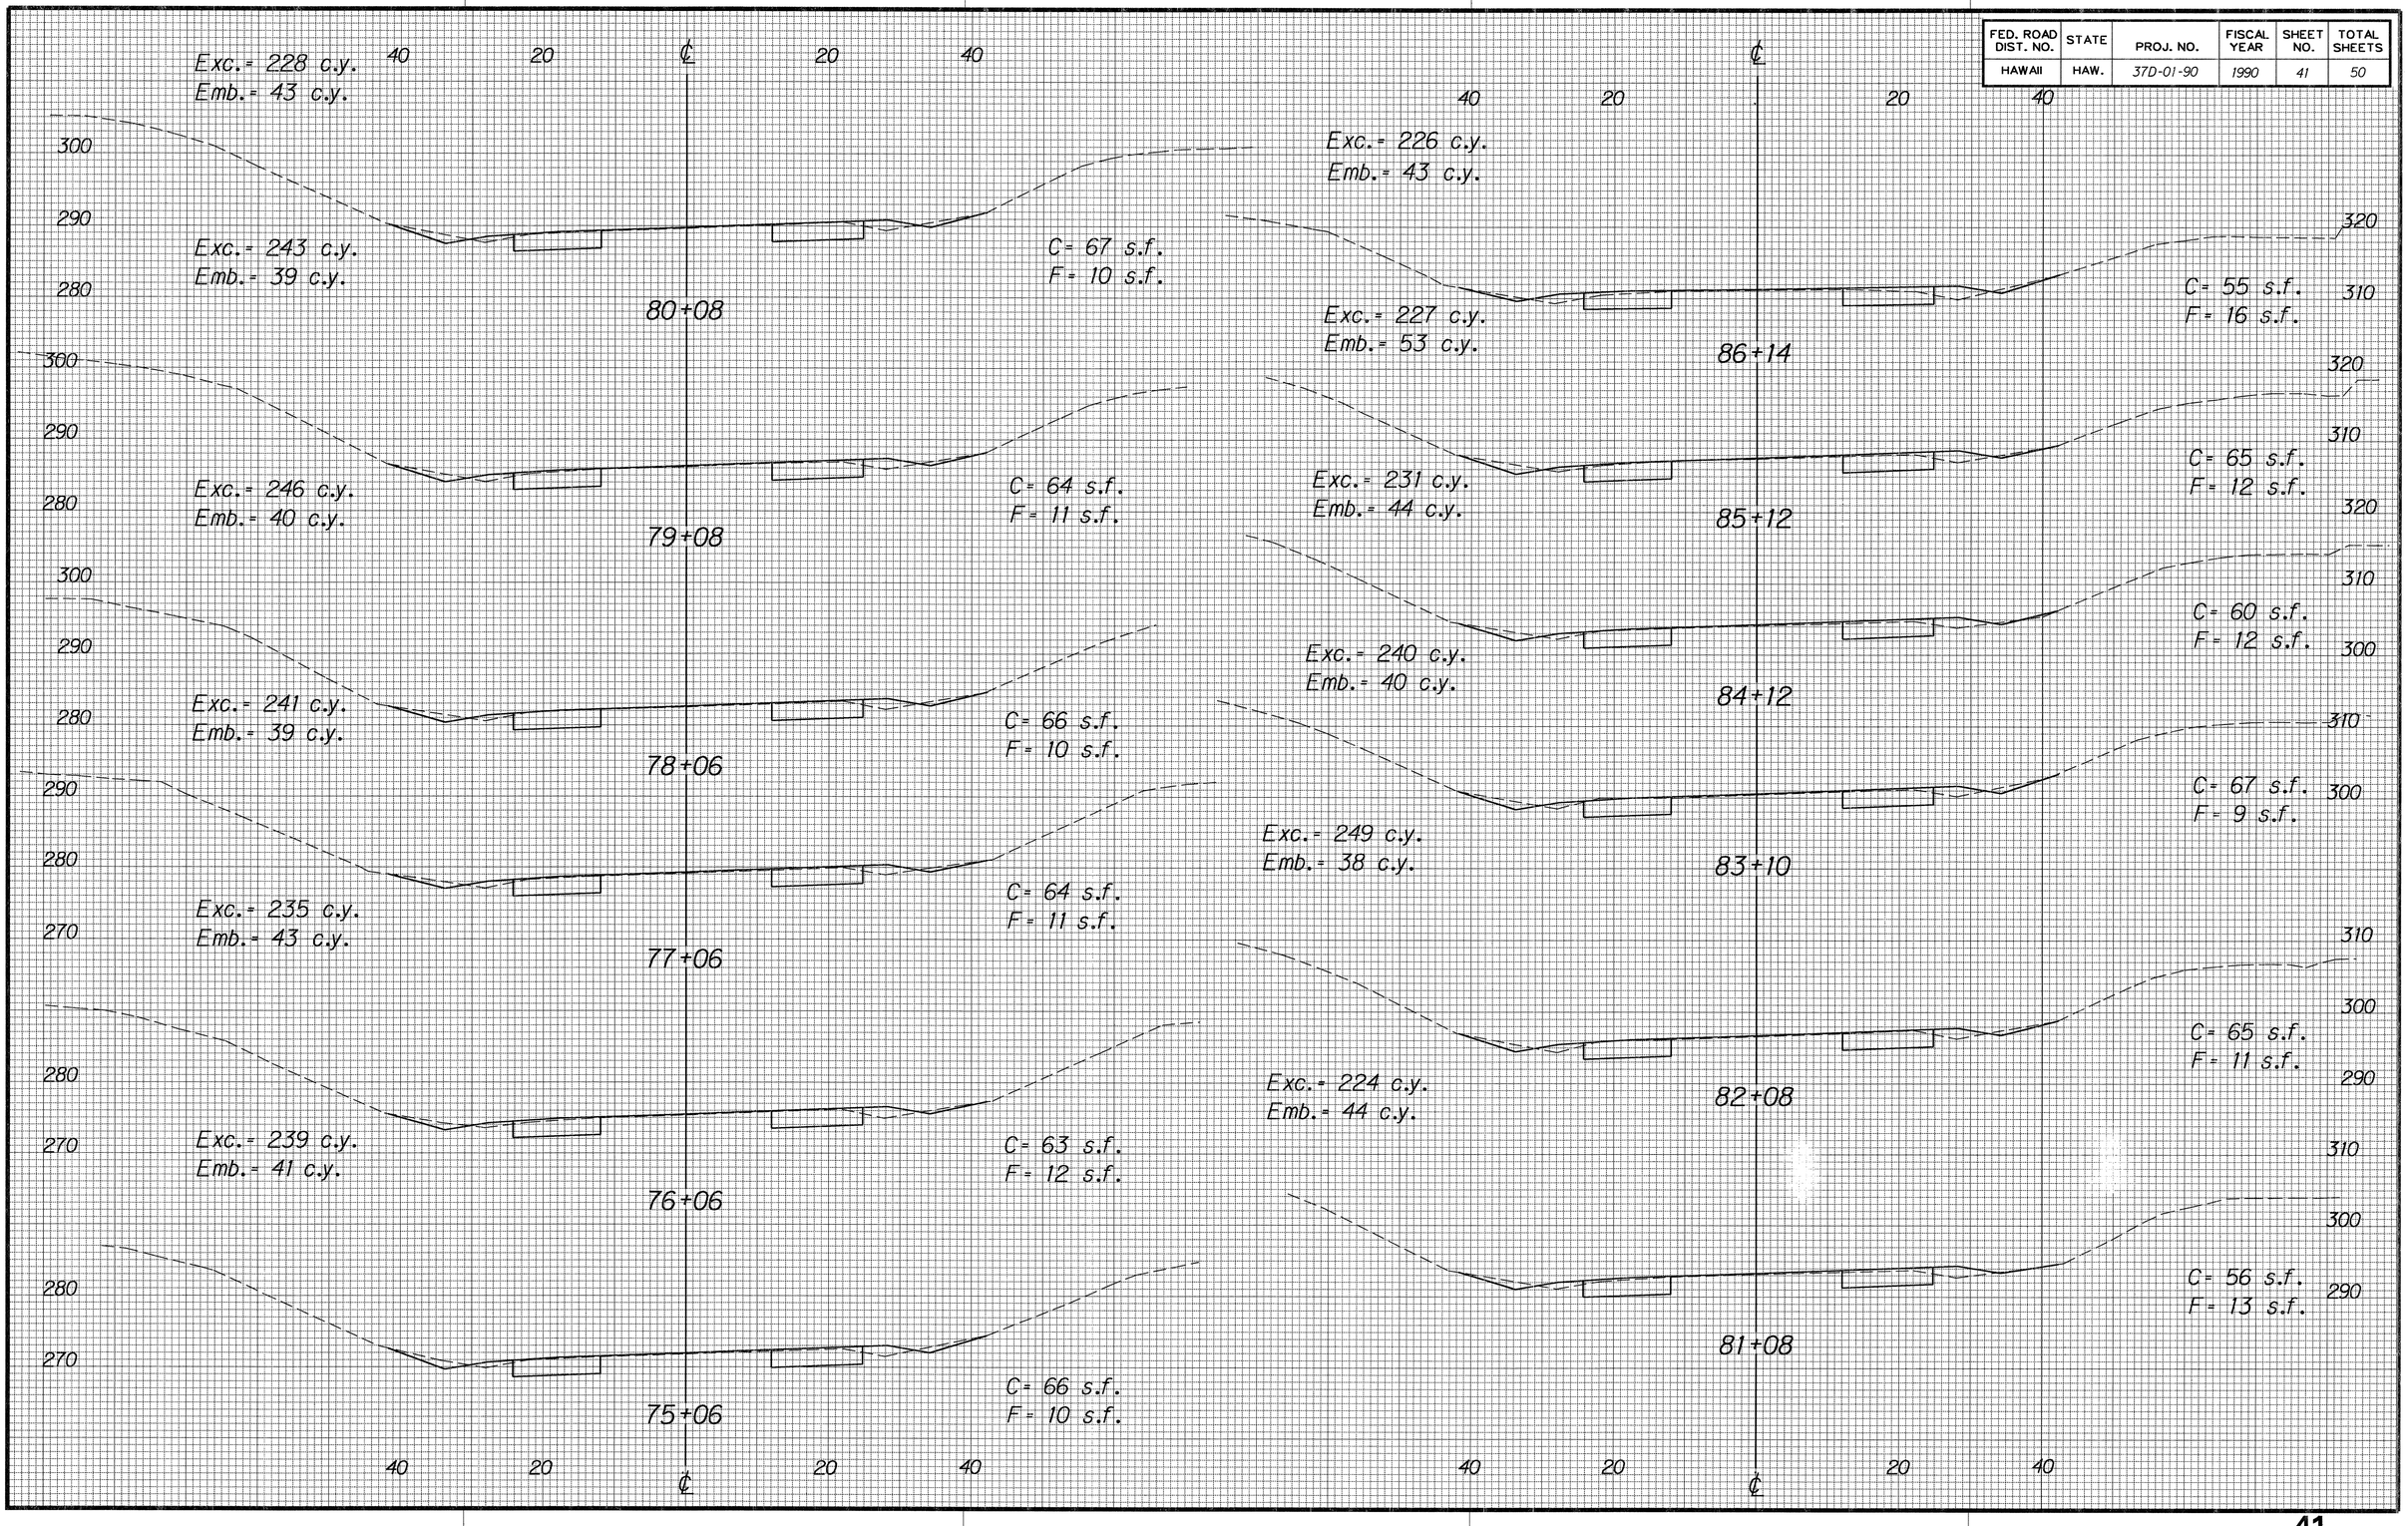

ORIGINAL PLAN


SURVEY PLOTTED BY ____ DATE
DRAWN BY ____ . . . .
TRACED BY ____ . . . .
DESIGNED BY ____ . . . .
NOTE BOOK ____ QUANTITIES BY ____
No. ____ CHECKED BY ____

FED. ROAD DIST. NO.	STATE	PROJ. NO.	FISCAL YEAR	SHEET NO.	TOTAL SHEETS
HAWAII	HAW.	37D-01-90	1990	42	50

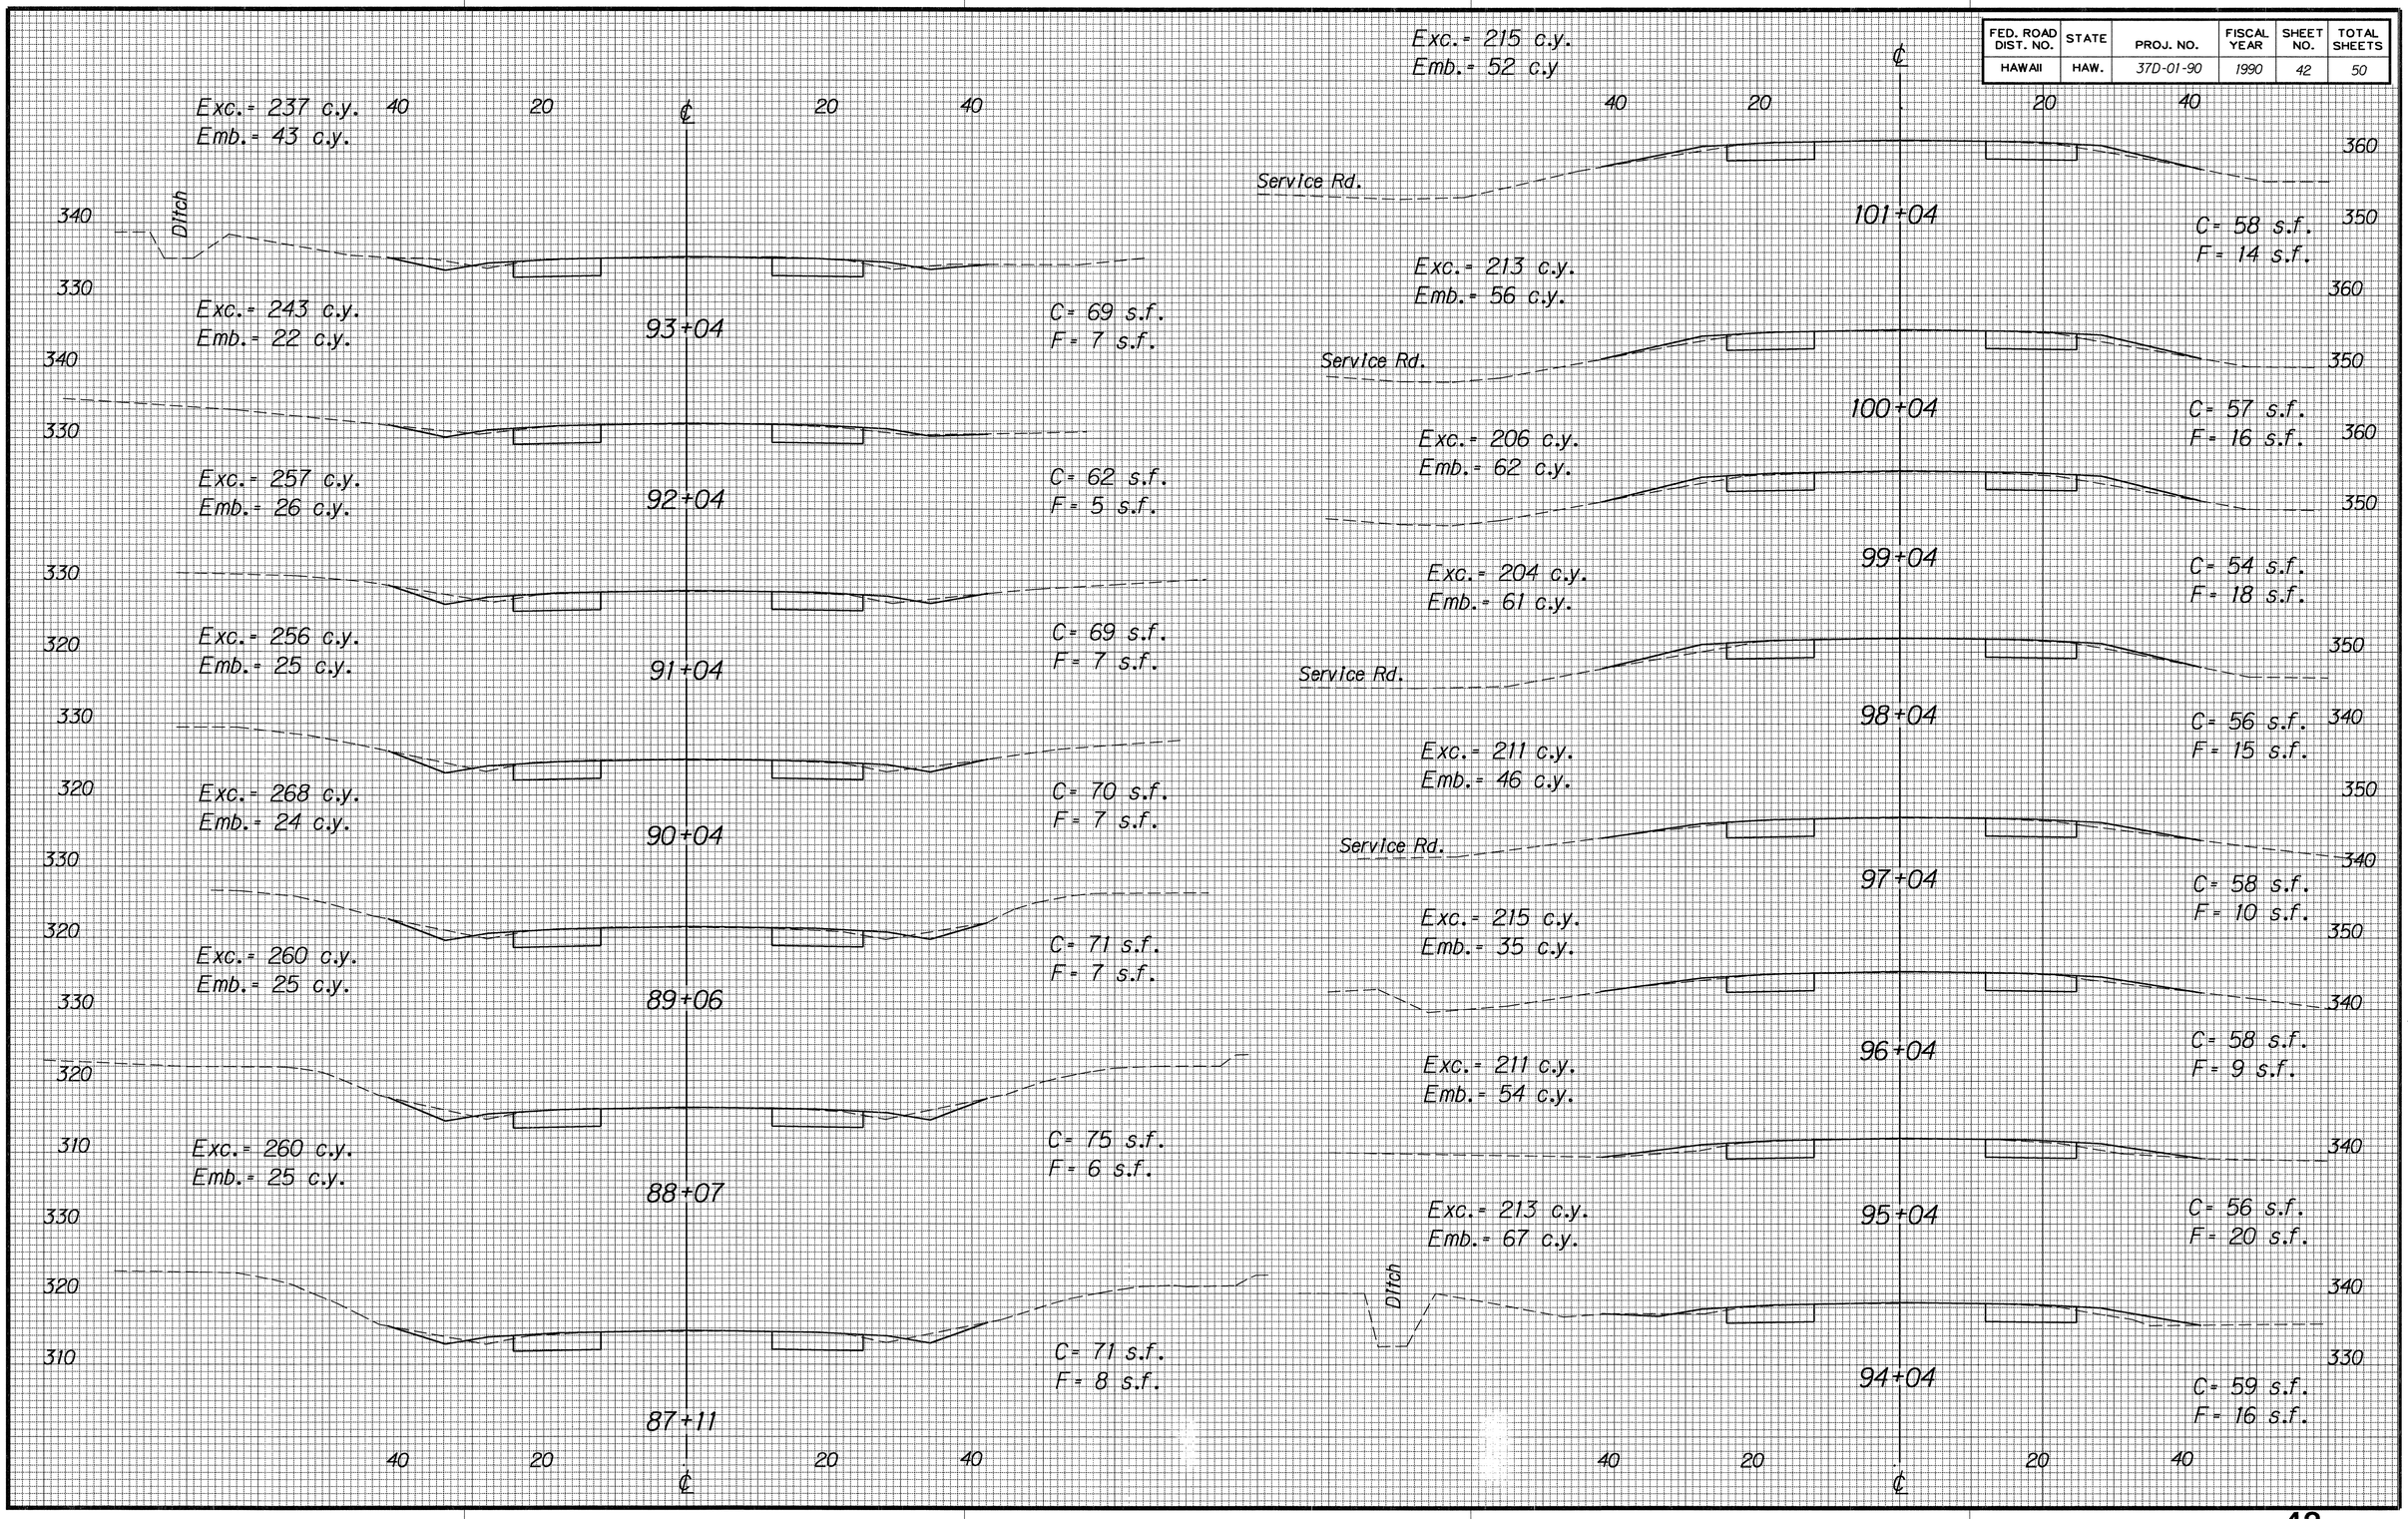

ORIGINAL PLAN	SURVEY PLOTTED BY	DATE
	DRAWN BY	
	TRACED BY	
NOTE BOOK	DESIGNED BY	
	QUANTITIES BY	
No.	CHECKED BY	


FED. ROAD DIST. NO.	STATE	PROJ. NO.	FISCAL YEAR	SHEET NO.	TOTAL SHEETS
HAWAII	HAW.	37D-01-90	1990	43	50

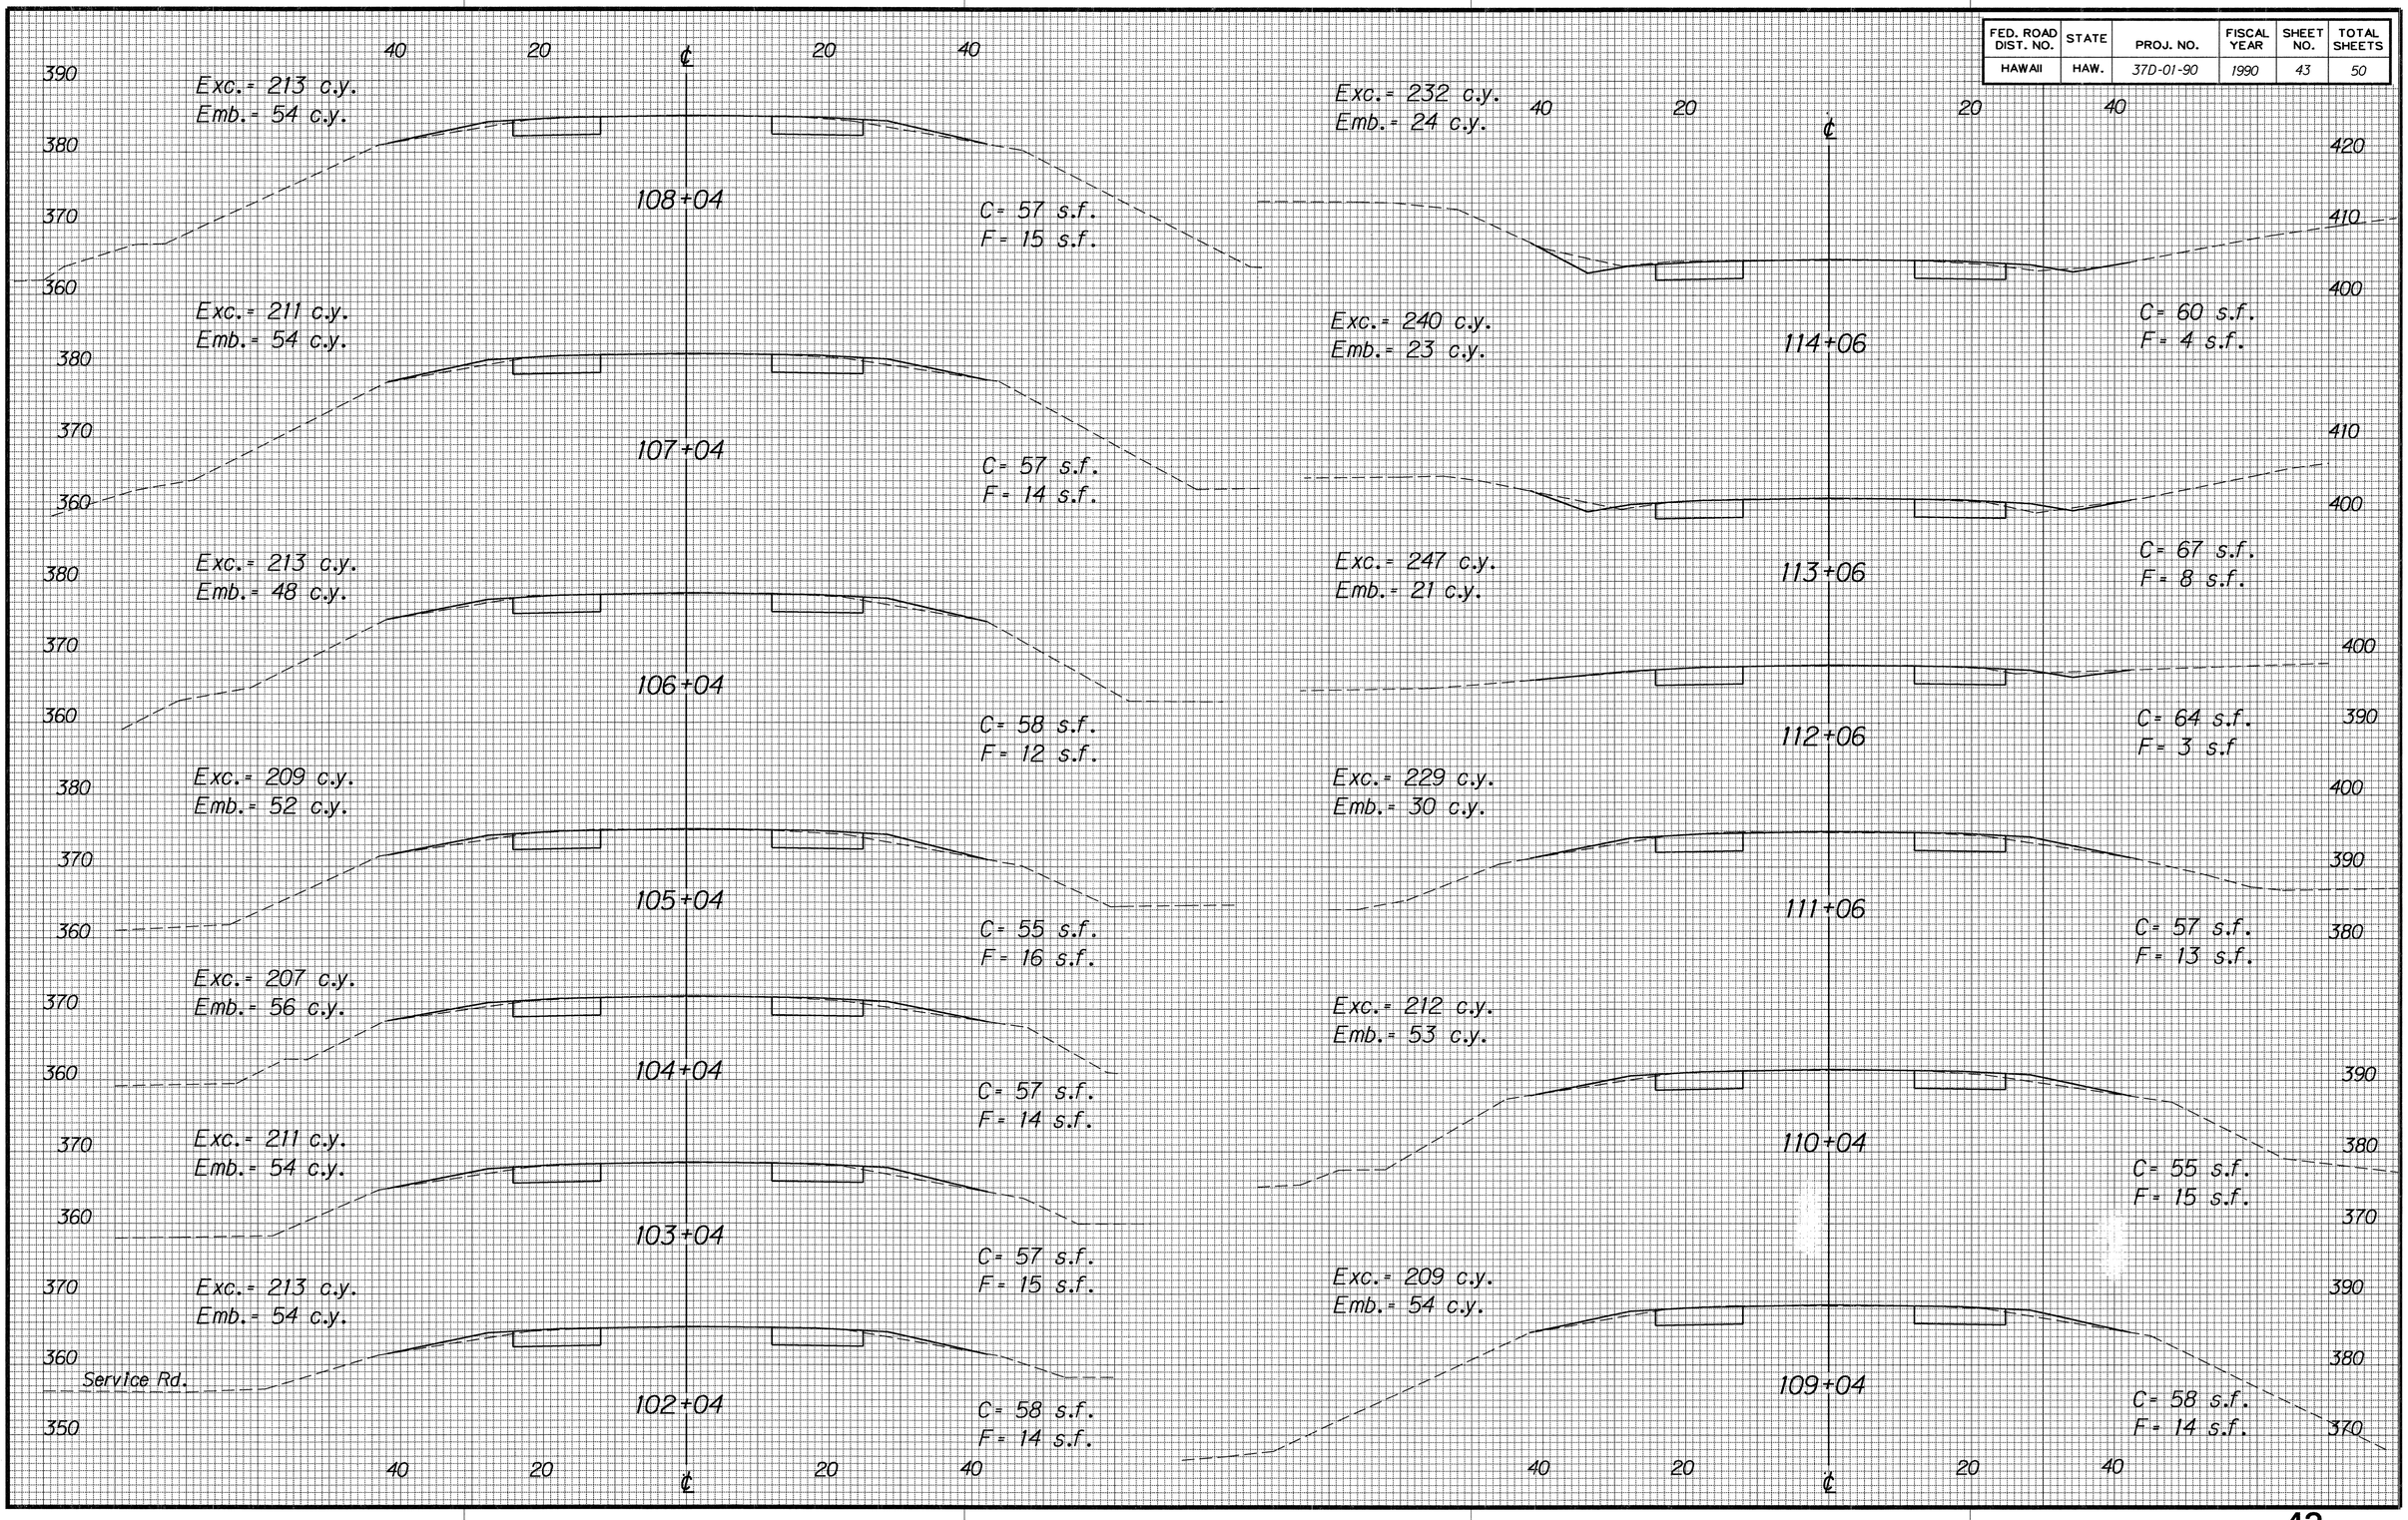

ORIGINAL PLAN

SURVEY PLOTTED BY _____ DATE
DRAWN BY _____ . . . .
TRACED BY _____ . . . .
NOTE BOOK _____ DIGITIZED BY _____ . . . .
QUANTITIES BY _____ . . . .
No. _____ CHECKED BY _____ . . . .


FED. ROAD DIST. NO.	STATE	PROJ. NO.	FISCAL YEAR	SHEET NO.	TOTAL SHEETS
HAWAII	HAW.	37D-01-90	1990	44	50

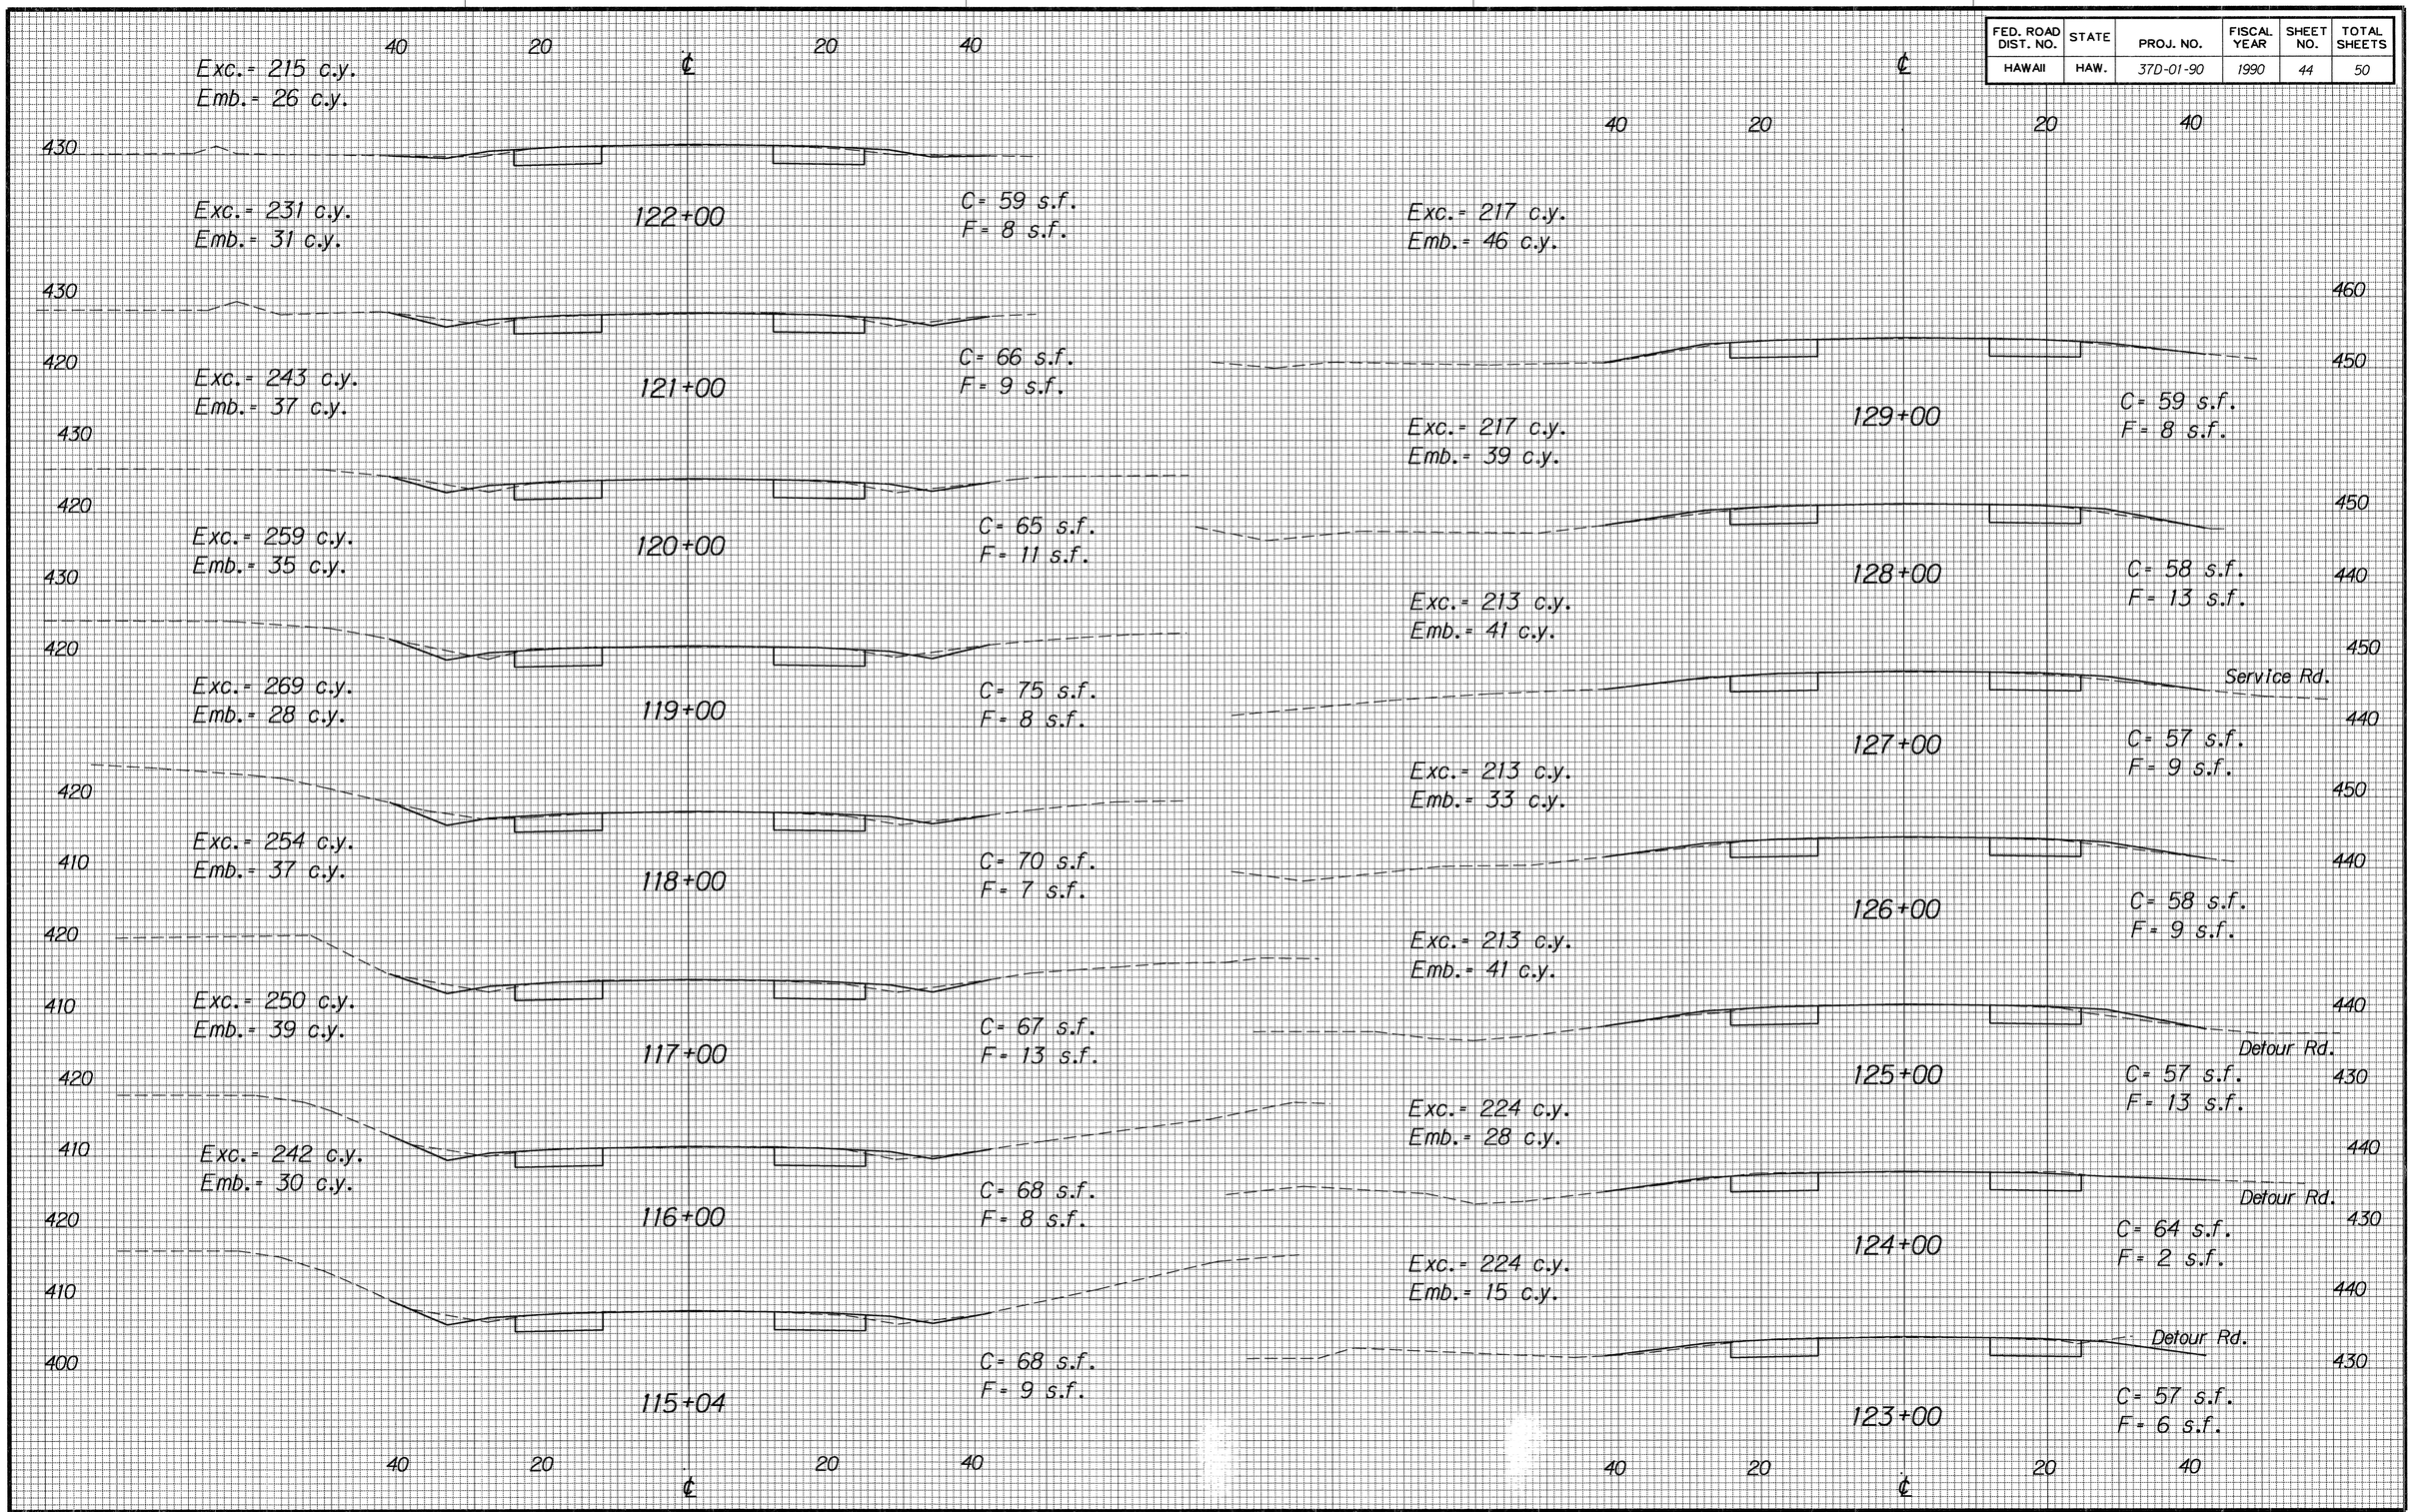

ORIGINAL PLAN


SURVEY PLOTTED BY _____ DATE
DRAWN BY _____ . . . . .
TRACED BY _____
NOTE BOOK _____ DESIGNED BY _____
N- _____ QUANTITIES BY _____
CHECKED BY _____

FED. ROAD DIST. NO.	STATE	PROJ. NO.	FISCAL YEAR	SHEET NO.	TOTAL SHEETS
HAWAII	HAW.	37D-01-90	1990	45	50

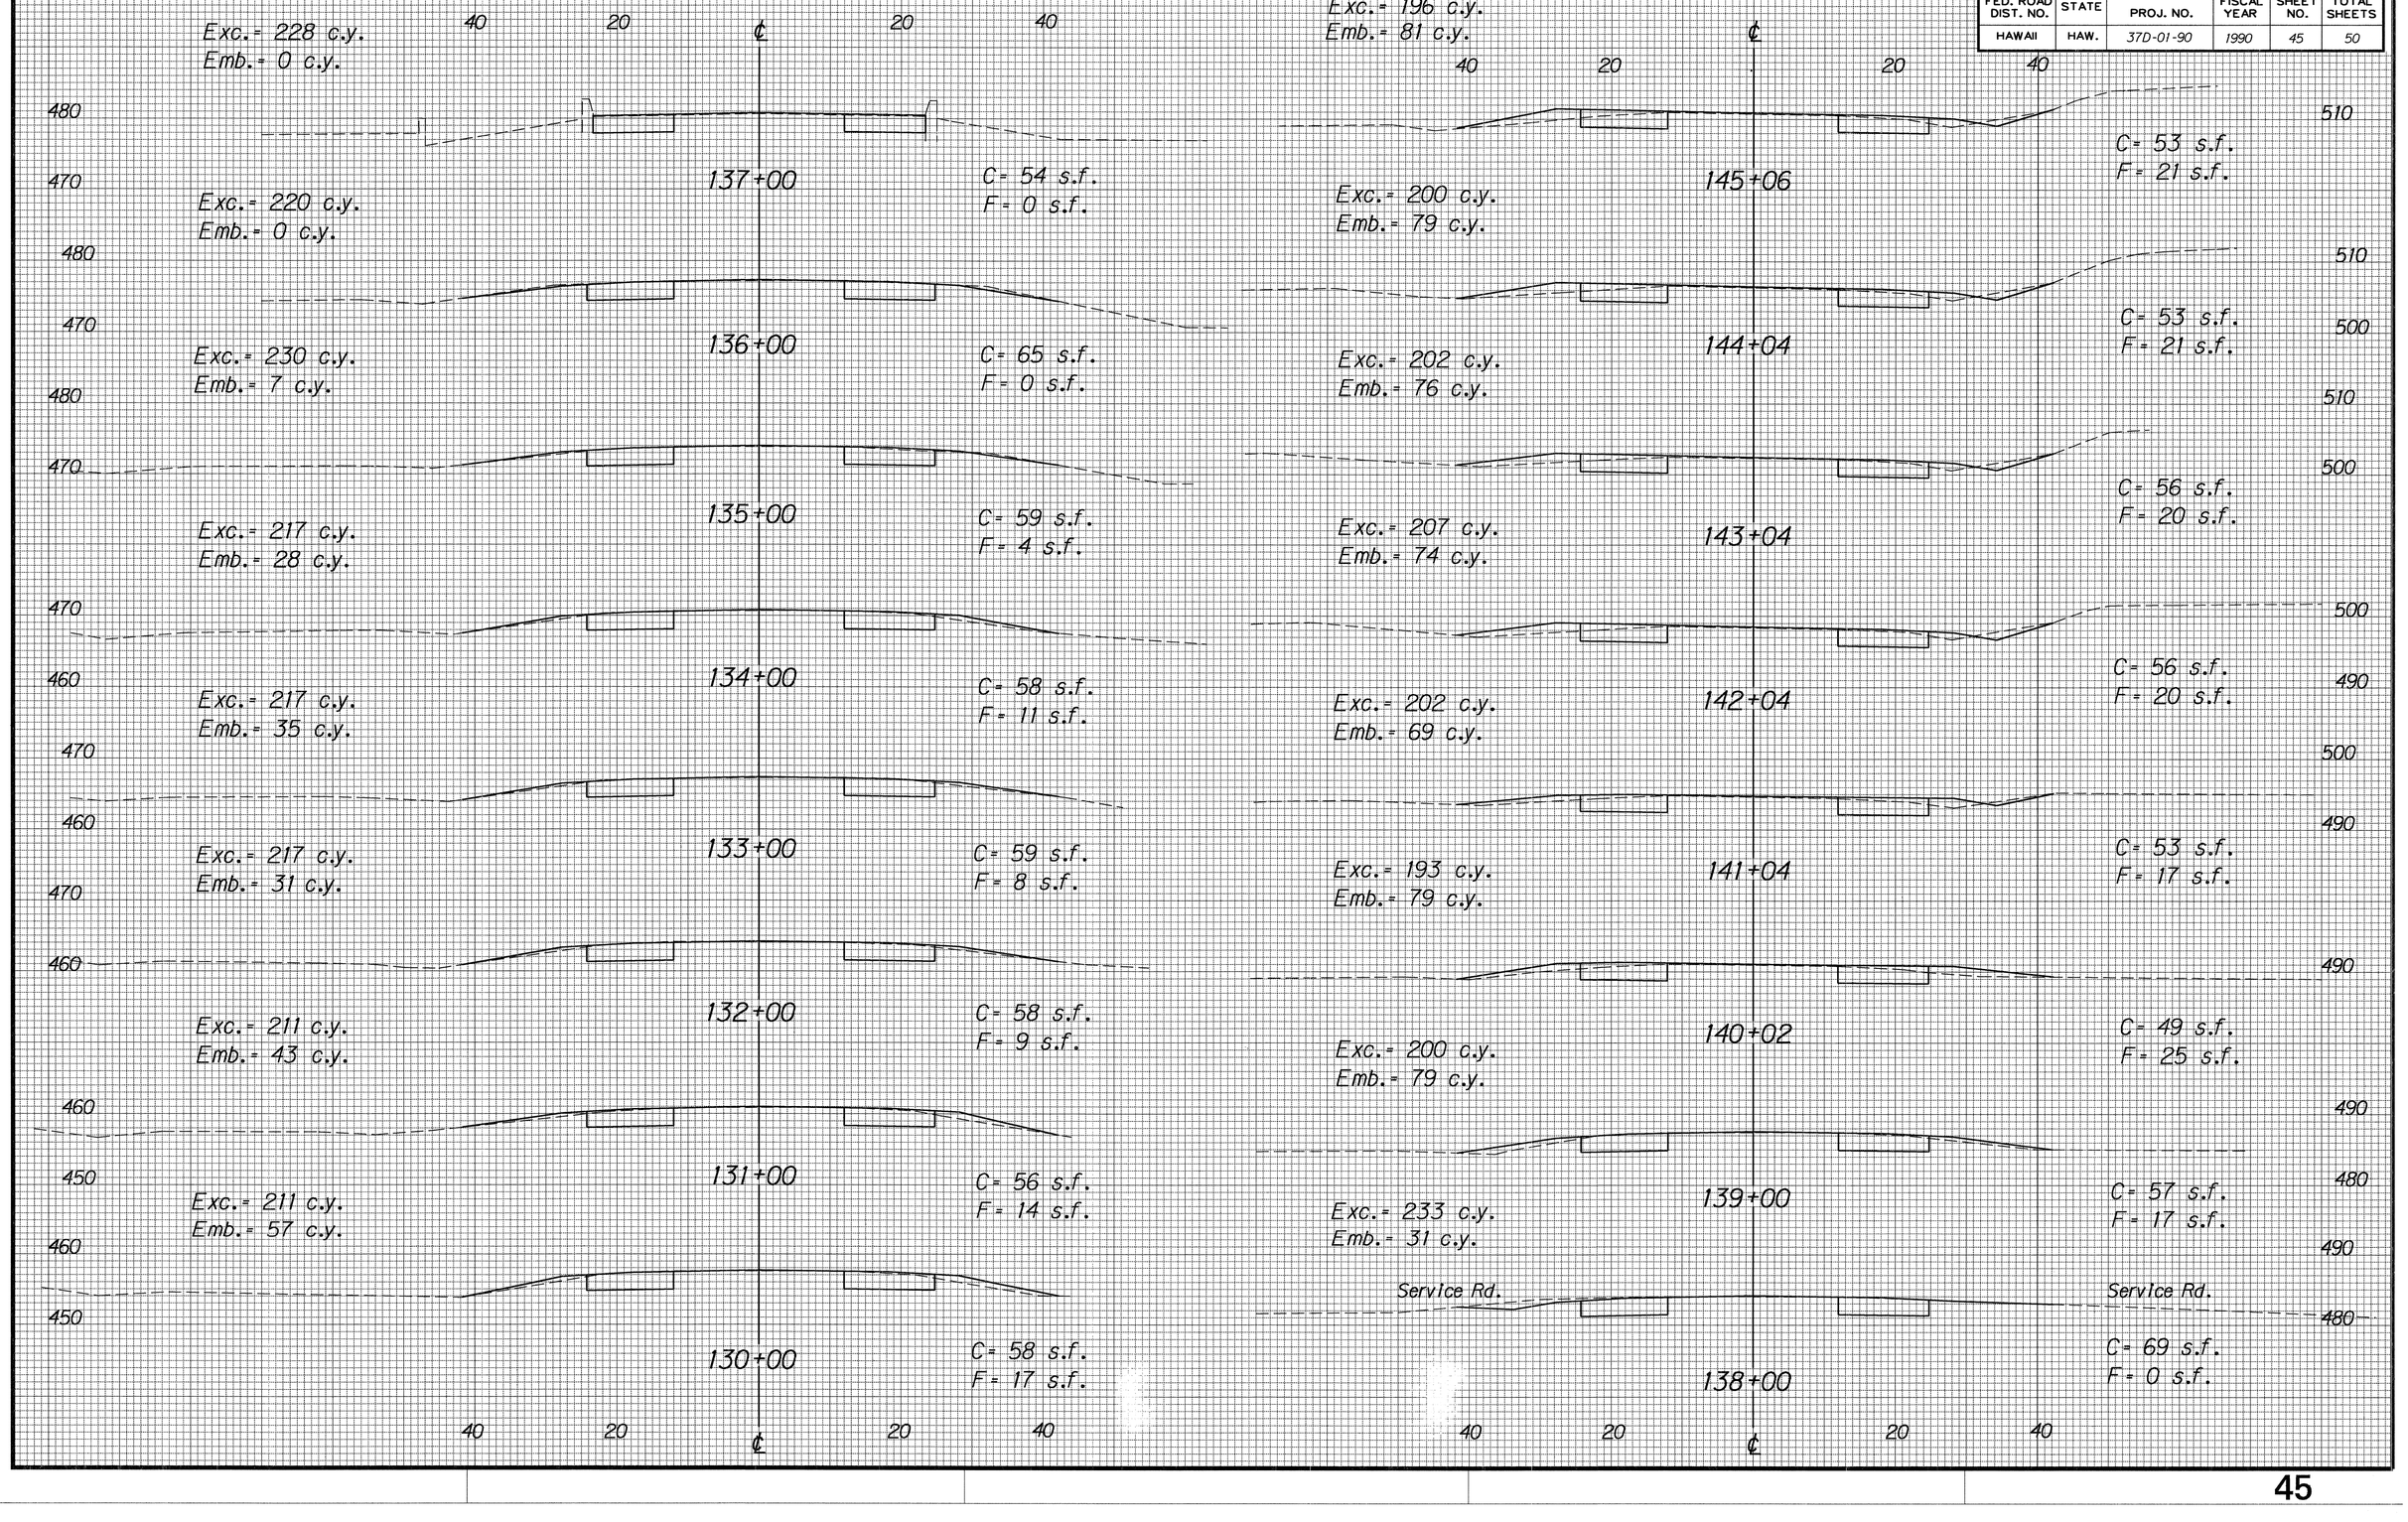


ORIGINAL PLAN
SURVEY PLOTTED BY
DRAWN BY
TRACED BY
DESIGNED BY
NOTE BOOK
QUANTITIES BY
CHECKED BY
DATE
No.

FED. ROAD DIST. NO.	STATE	PROJ. NO.	FISCAL YEAR	SHEET NO.	TOTAL SHEETS
HAWAII	HAW.	37D-01-90	1990	46	50

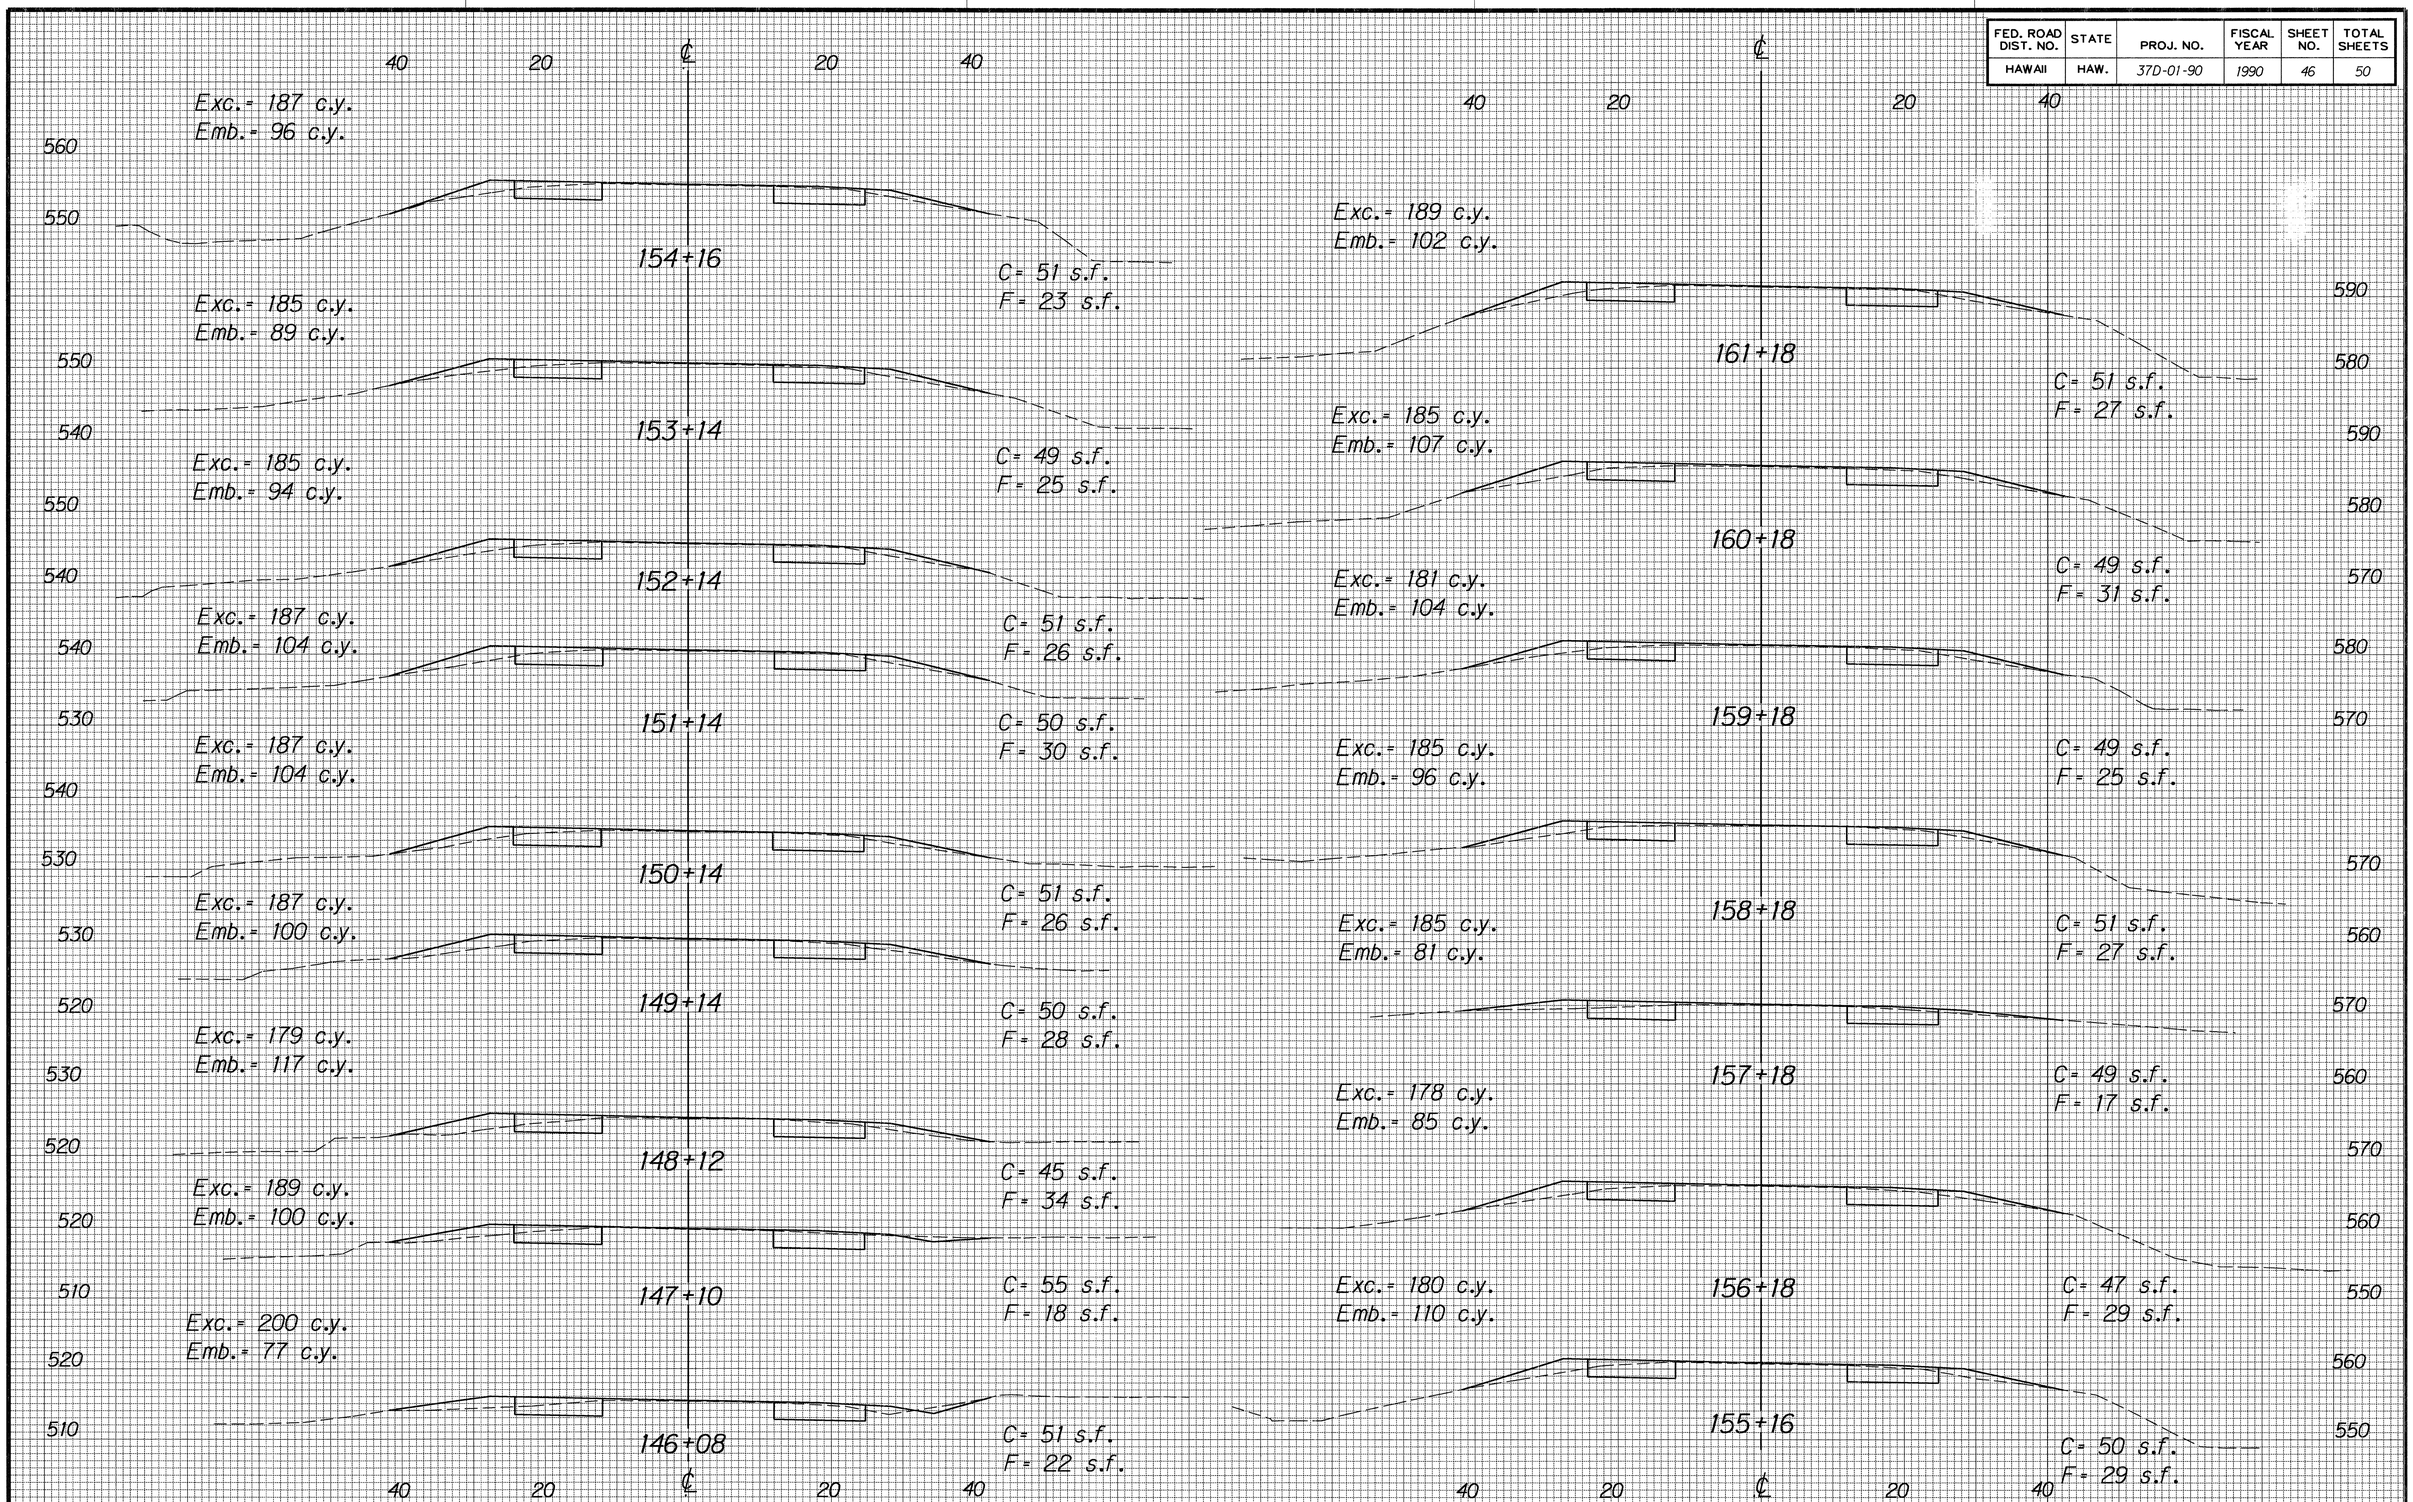

SURVEY PLOTTED BY _____ DATE _____
DRAWN BY _____
TRACED BY _____
CHECKED BY _____
QUANTITIES BY _____
CHECKED BY _____
ORIGINAL PLAN
NOTE BOOK _____ No. _____

FED. ROAD DIST. NO.	STATE	PROJ. NO.	FISCAL YEAR	SHEET NO.	TOTAL SHEETS
HAWAII	HAW.	37D-01-90	1990	47	50

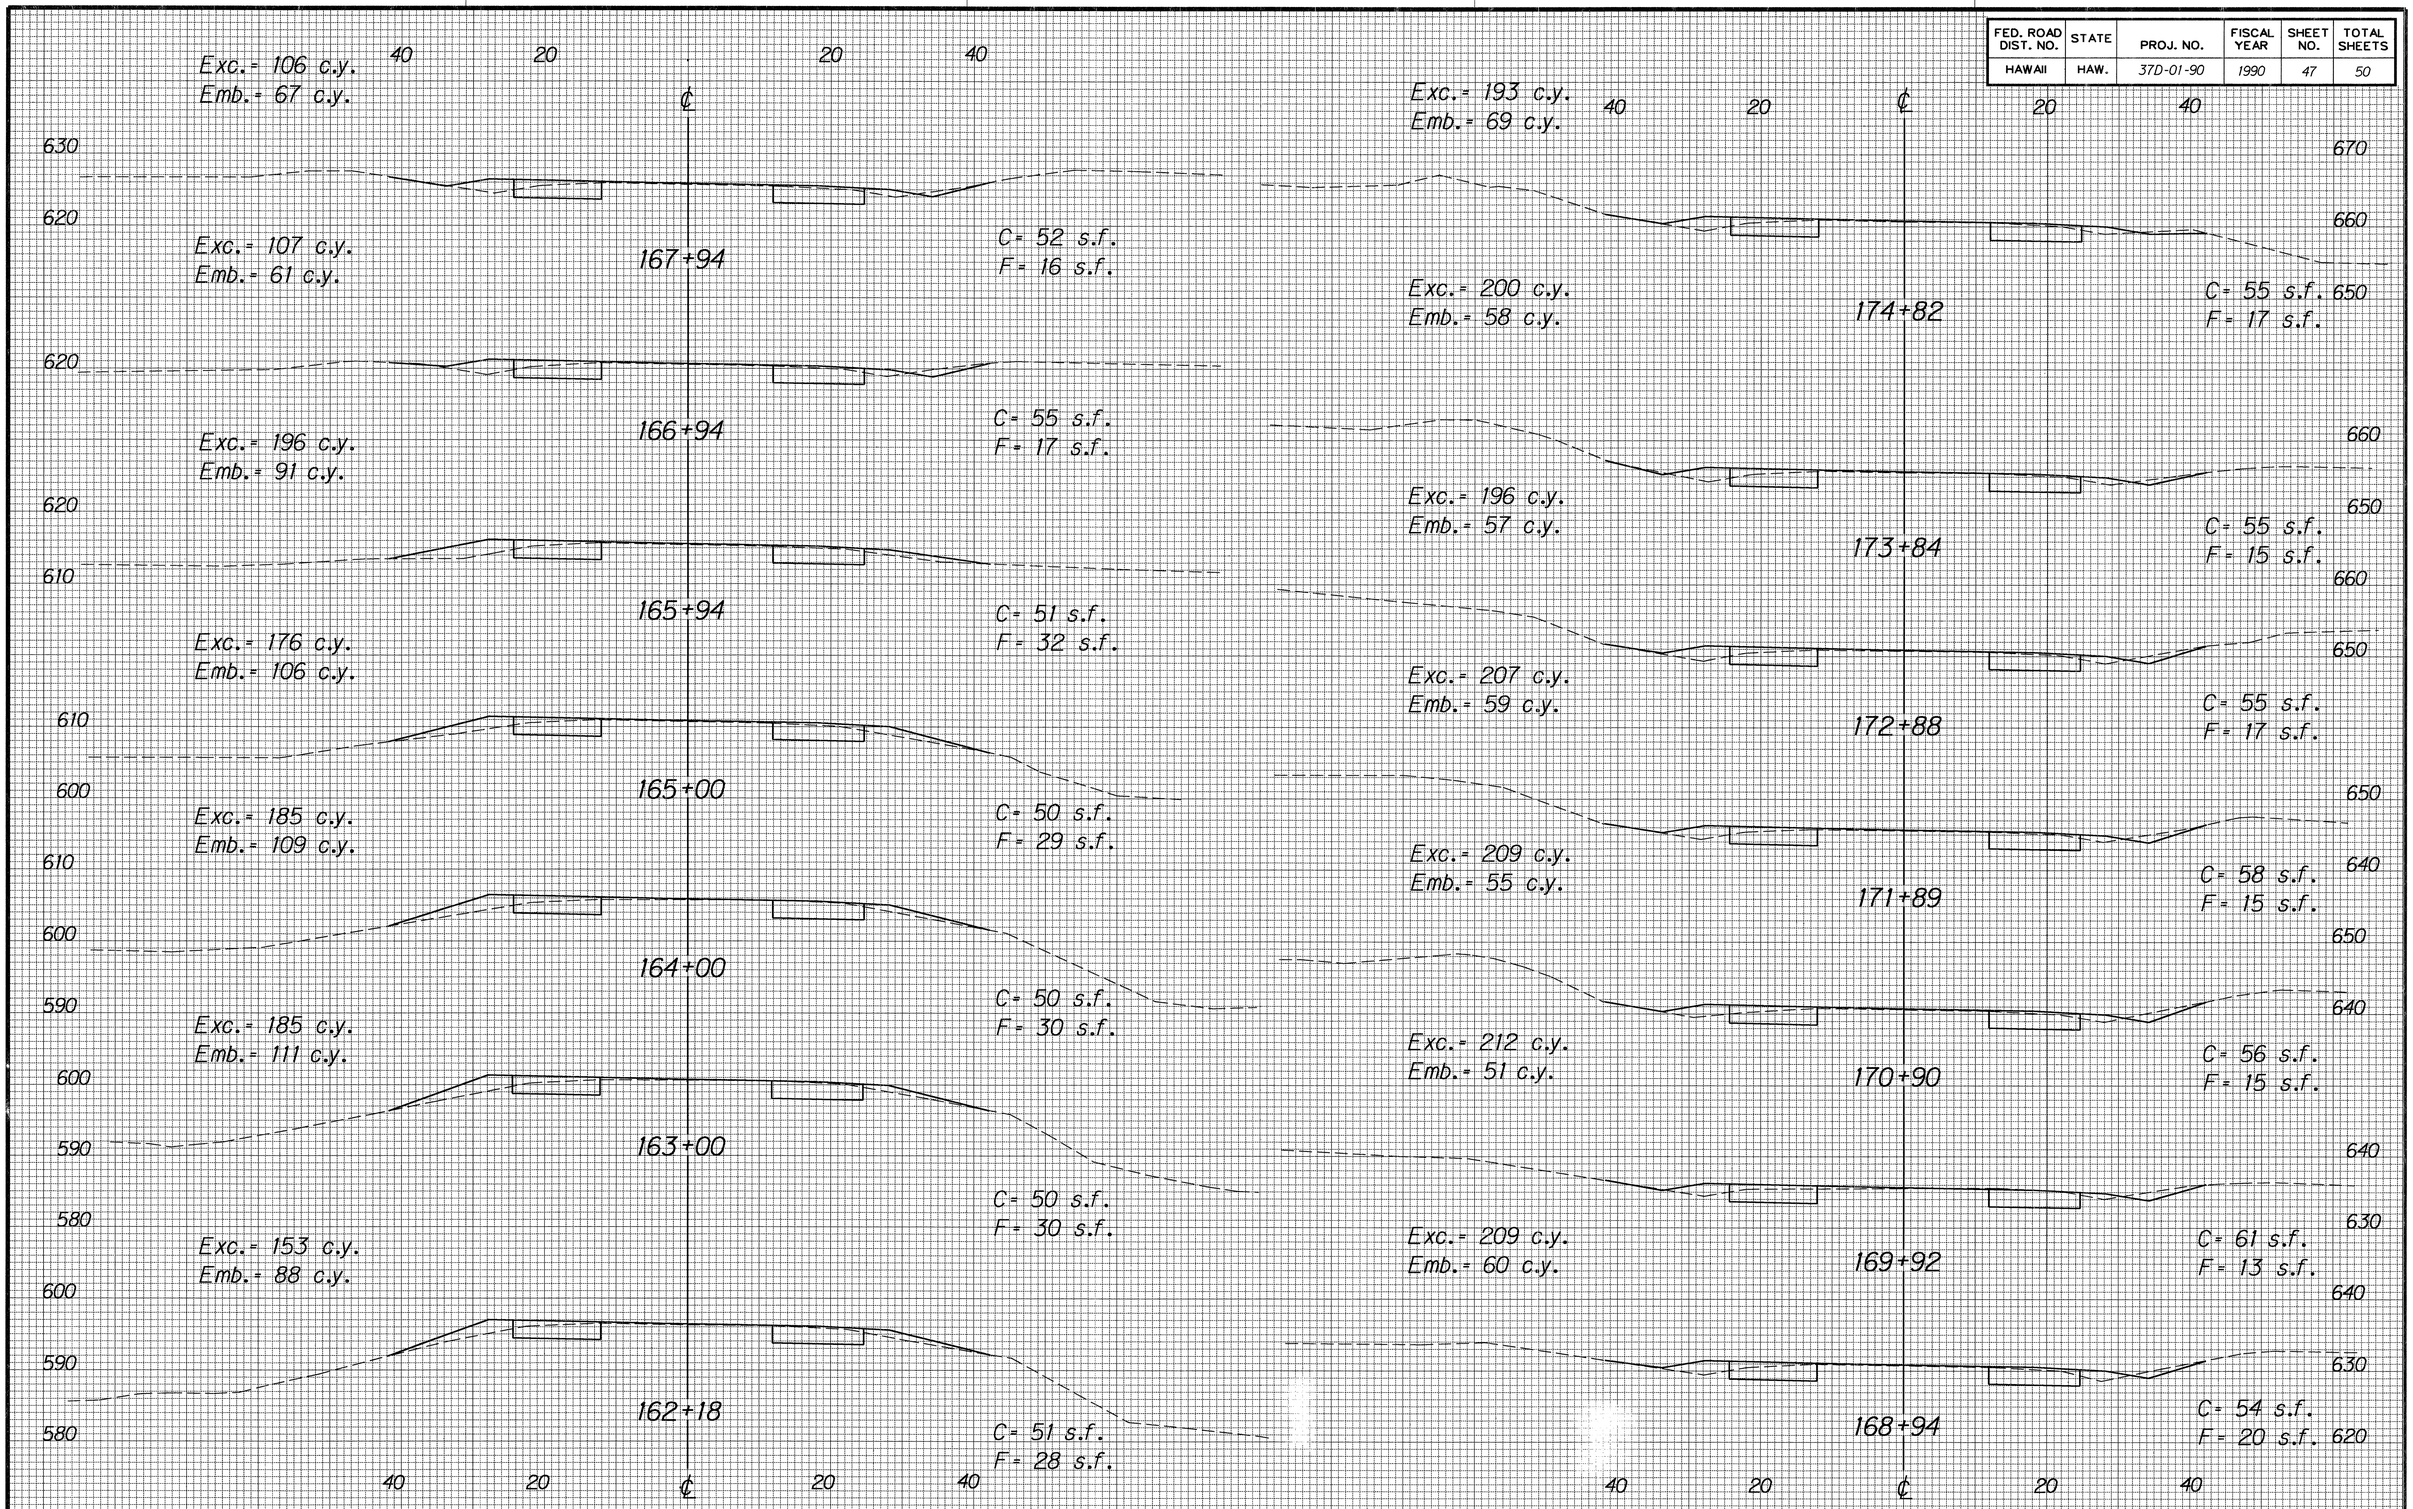

ORIGINAL PLAN
SURVEY PLOTTED BY
DRAWN BY
TRACED BY
NOTE BOOK
DESIGNED BY
QUANTITIES BY
CHECKED BY
DATE
No.

FED. ROAD DIST. NO.	STATE	PROJ. NO.	FISCAL YEAR	SHEET NO.	TOTAL SHEETS
HAWAII	HAW.	37D-01-90	1990	48	50

40 20 ℄ 20 40

Exc.= 198 c.y.
Emb.= 43 c.y.

700
690

Exc.= 189 c.y.
Emb.= 63 c.y.

182+26

C= 51 s.f.
F= 17 s.f.

700
690

Exc.= 189 c.y.
Emb.= 82 c.y.

181+26

C= 51 s.f.
F= 17 s.f.

690
680

Exc.= 183 c.y.
Emb.= 107 c.y.

180+25

C= 50 s.f.
F= 27 s.f.

690
680

Exc.= 271 c.y.
Emb.= 159 c.y.

179+24

C= 48 s.f.
F= 30 s.f.

680
670

Exc.= 183 c.y.
Emb.= 80 c.y.

177+76

C= 51 s.f.
F= 28 s.f.

680
670

Exc.= 183 c.y.
Emb.= 67 c.y.

176+80

C= 52 s.f.
F= 17 s.f.

670
660

175+82

C= 49 s.f.
F= 20 s.f.

40 20 ℄ 20 40

Exc.= 189 c.y.
Emb.= 76 c.y.

750
740

Exc.= 207 c.y.
Emb.= 62 c.y.

189+28

C= 52 s.f.
F= 21 s.f.

740
730

Exc.= 222 c.y.
Emb.= 50 c.y.

188+29

C= 61 s.f.
F= 13 s.f.

740
730

Exc.= 261 c.y.
Emb.= 30 c.y.

187+30

C= 60 s.f.
F= 14 s.f.

730
720

Exc.= 288 c.y.
Emb.= 9 c.y.

186+29

C= 80 s.f.
F= 2 s.f.

720
710

Exc.= 275 c.y.
Emb.= 15 c.y.

185+28

C= 74 s.f.
F= 3 s.f.

710
700

Exc.= 241 c.y.
Emb.= 19 c.y.

184+27

C= 73 s.f.
F= 5 s.f.

Service Rd.
700


183+26

C= 56 s.f.
F= 5 s.f.

40 20 ℄ 20 40

ORIGINAL PLAN	SURVEY PLOTTED BY	DATE
	DRAWN BY	
	TRACED BY	
NOTE BOOK	DESIGNED BY	
	QUANTITIES BY	
No.	CHECKED BY	

FED. ROAD DIST. NO.	STATE	PROJ. NO.	FISCAL YEAR	SHEET NO.	TOTAL SHEETS
HAWAII	HAW.	37D-01-90	1990	49	50

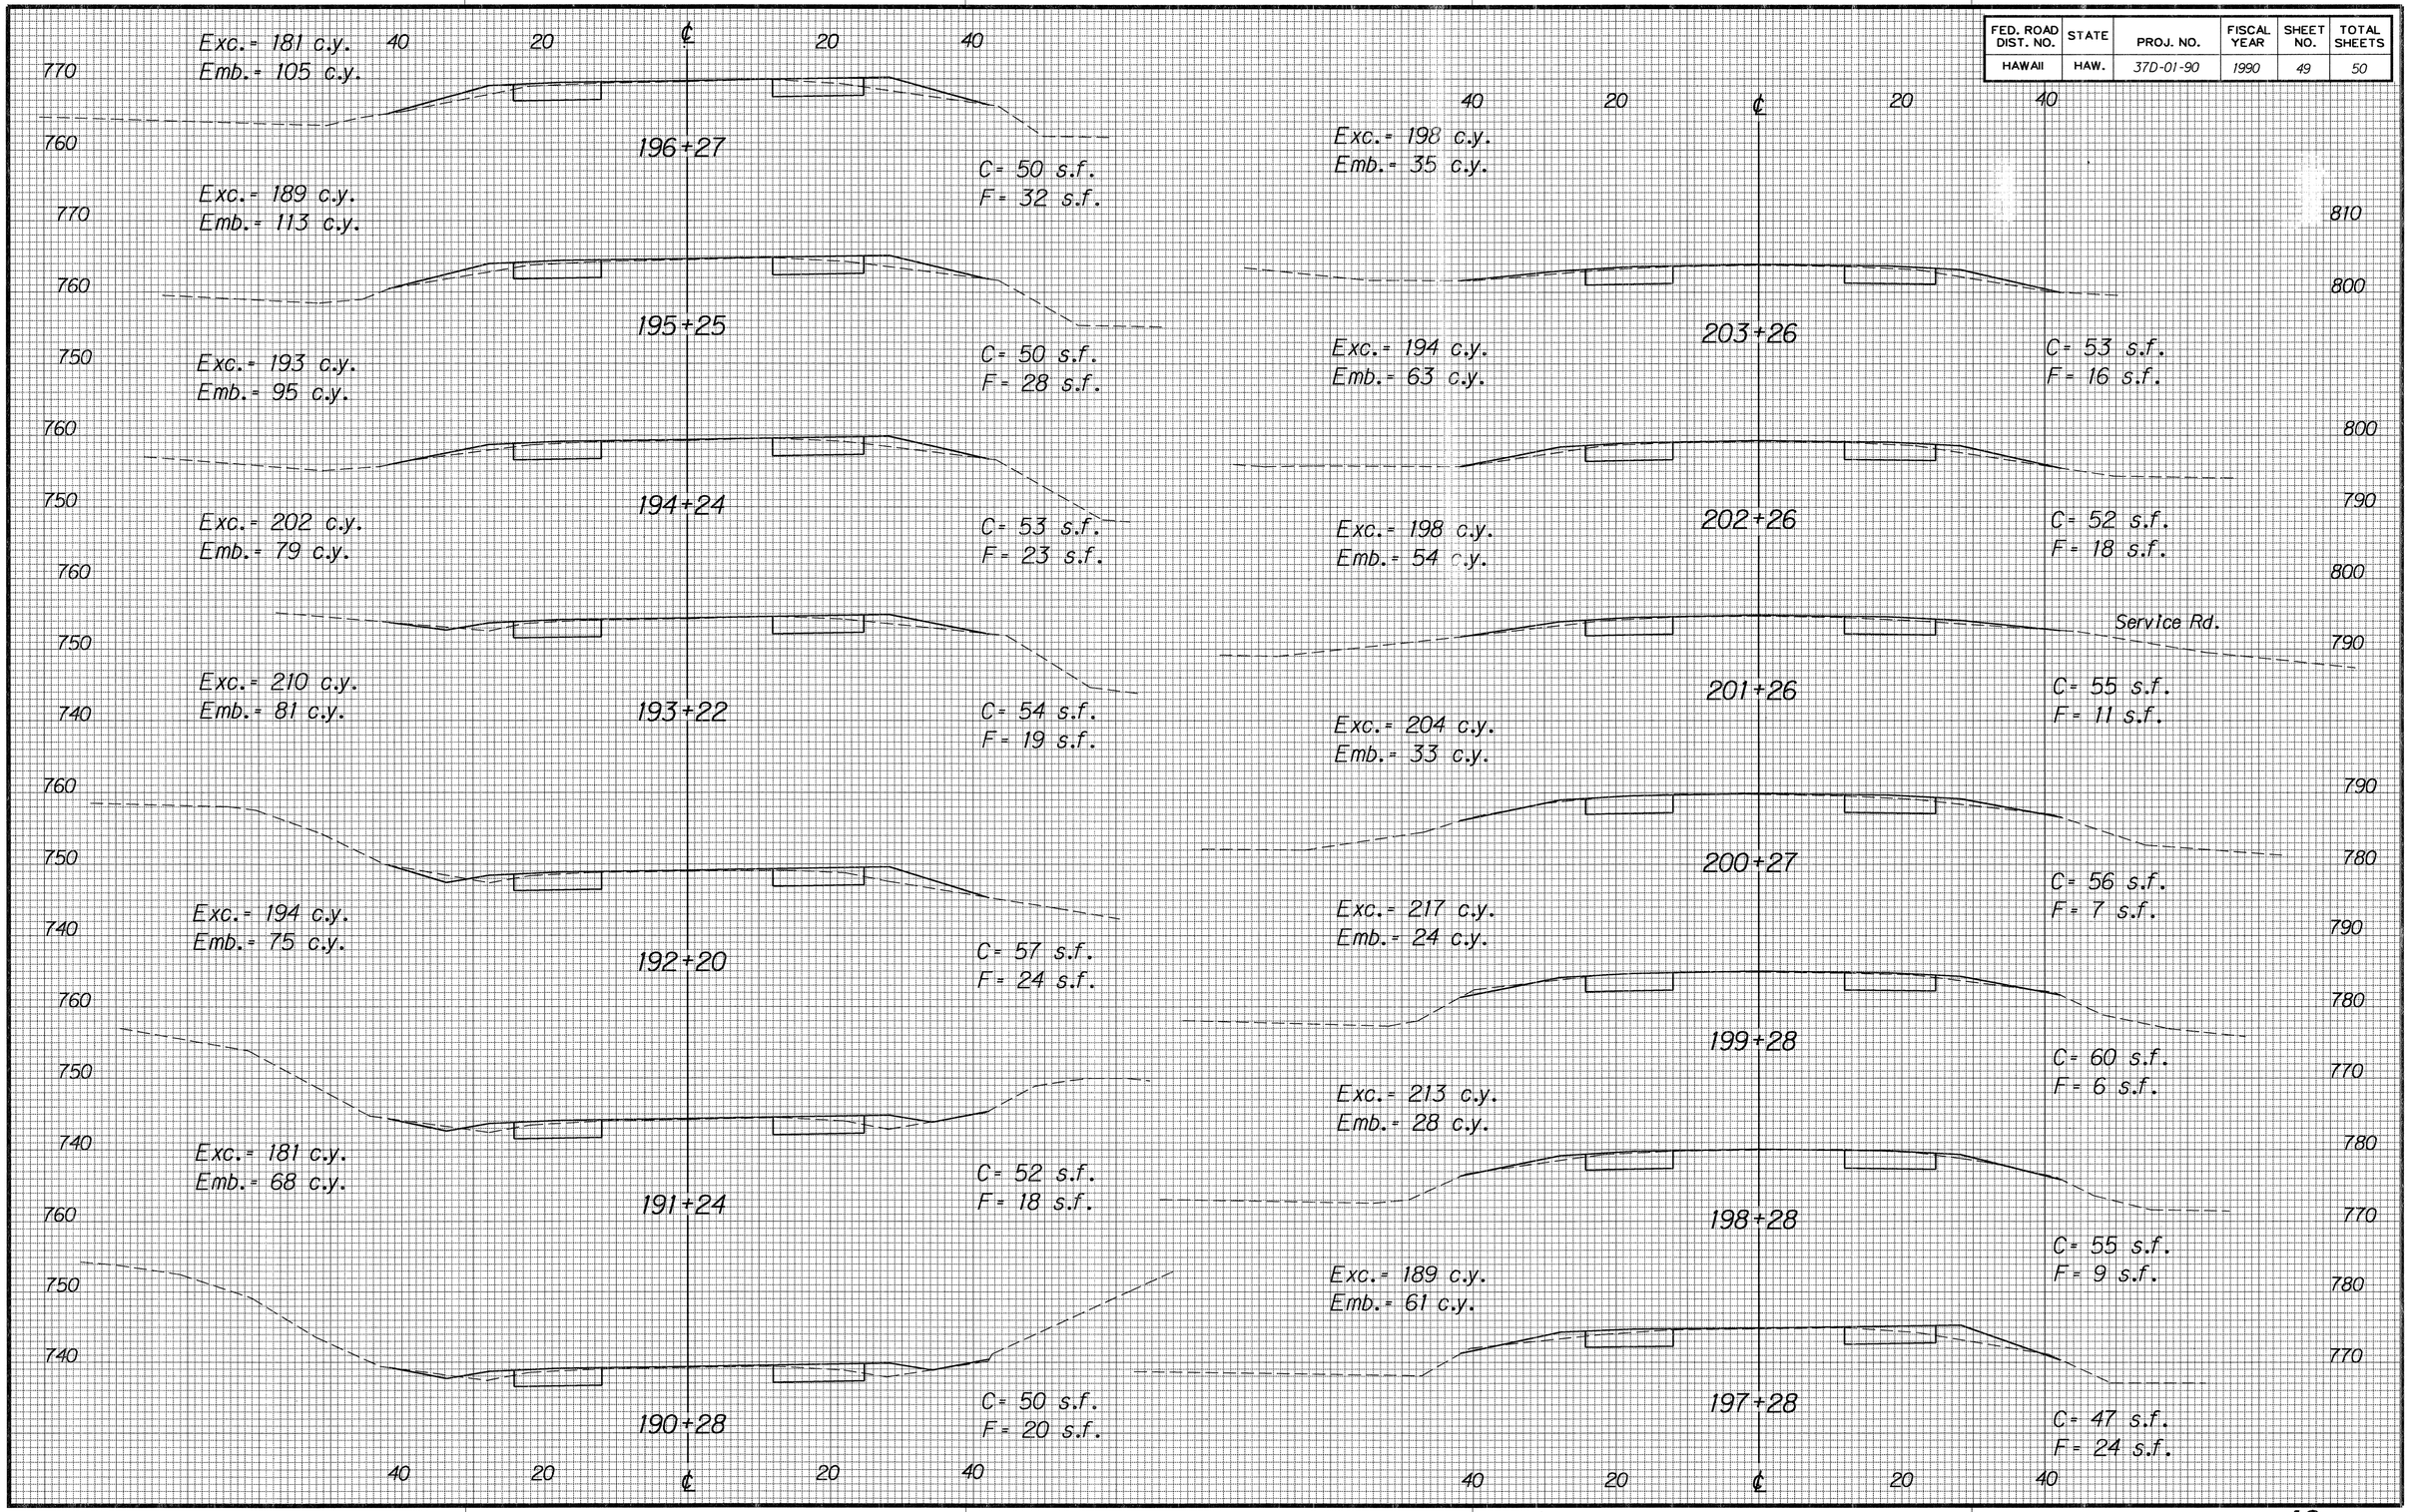

ORIGINAL PLAN

SURVEY PLOTTED BY _____ DATE

DRAWN BY _____

TRACED BY _____

DESIGNED BY _____


NOTE BOOK _____

QUANTITIES BY _____

CHECKED BY _____

No. _____

FED. ROAD DIST. NO.	STATE	PROJ. NO.	FISCAL YEAR	SHEET NO.	TOTAL SHEETS
HAWAII	HAW.	37D-01-90	1990	50	50

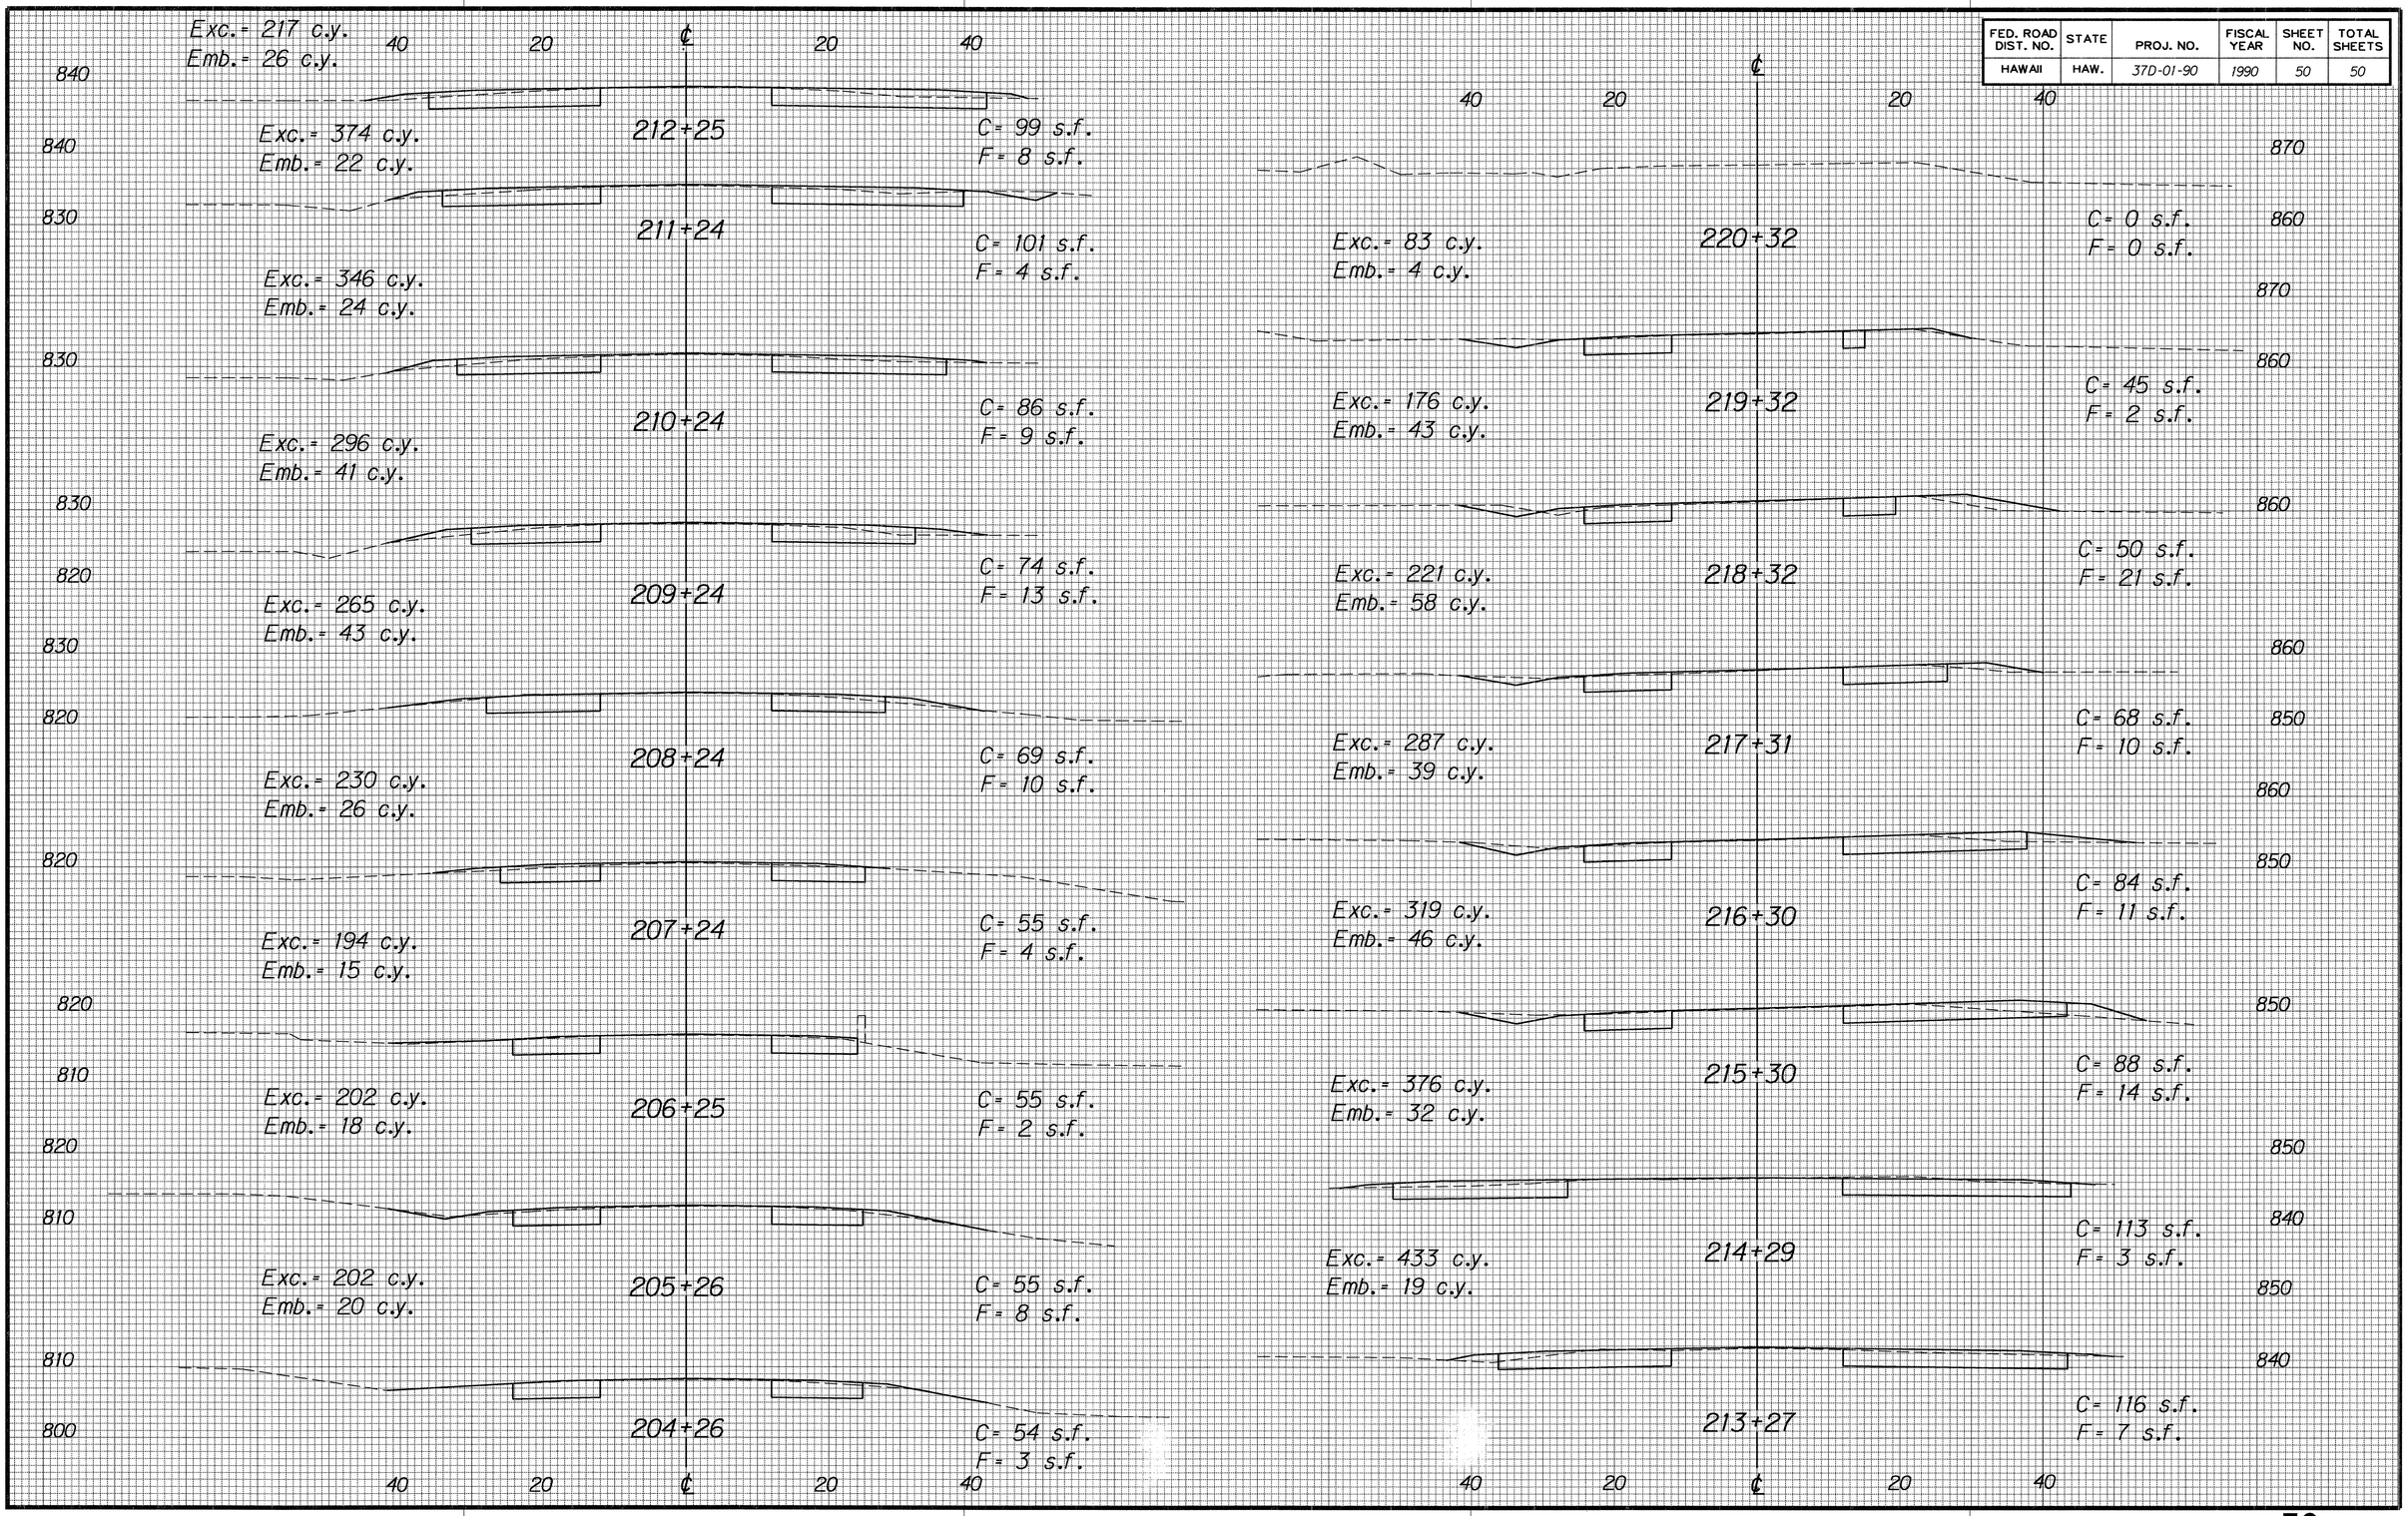

ORIGINAL PLAN	SURVEY PLOTTED BY	DATE
	DRAWN BY	
	TRACED BY	
NOTE BOOK	DESIGNED BY	
	QUANTITIES BY	
No.	CHECKED BY	