FED. ROAD DIST. NO.	STATE	PROJ. NO.	FISCAL YEAR	SHEET NO.	TOTAL SHEETS
HAWAII	HAW.	37D-01-90	1990	1	50

INDEX TO DRAWINGS

SHEET NO.	DESCRIPTION
1	TITLE SHEET
2	STANDARD PLANS SUMMARY
3 – 4	TYPICAL SECTIONS
5 – 16	ROADWAY PLANS
17 – 33	TRAFFIC DETAILS
34 – 50	CROSS SECTIONS

STATE OF HAWAII

DEPARTMENT OF TRANSPORTATION

HIGHWAYS DIVISION

HONOLULU, HAWAII

"AS-BUILT"

PLANS FOR

HALEAKALA HIGHWAY
TRUCK CLIMBING LANE

HANA HIGHWAY TO HALIIMAILE ROAD

PROJECT NO. 37D-01-90

DISTRICT OF WAILUKU AND MAKAWAO

ISLAND OF MAUI

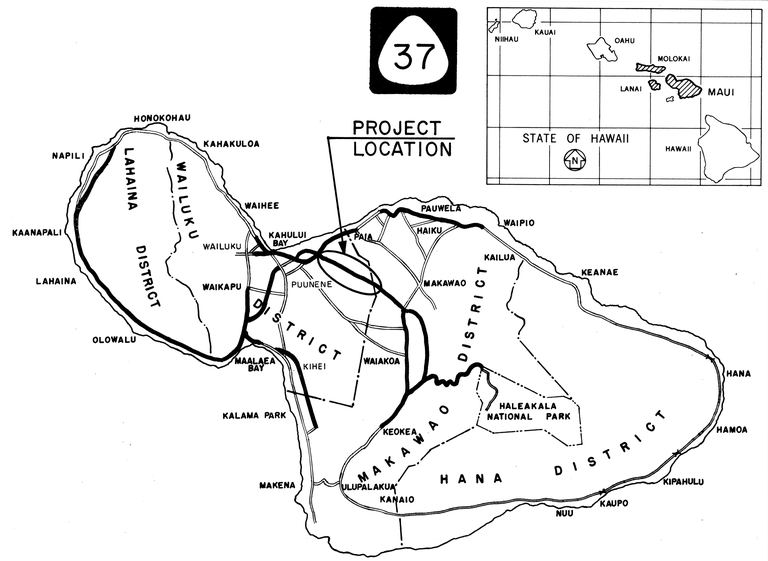

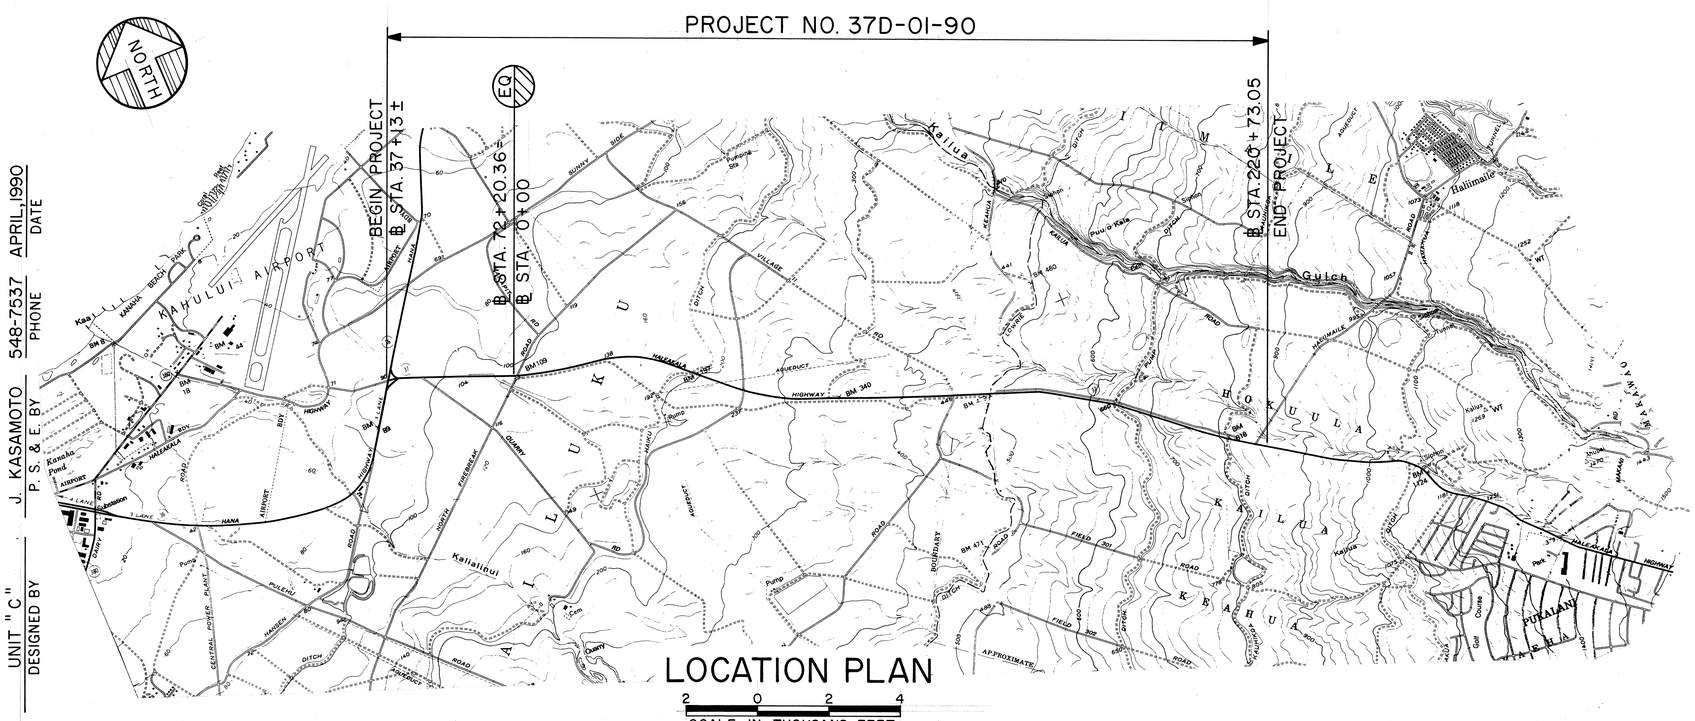

FEDERAL AID PROJECTS PREVIOUSLY CONSTRUCTED OR UNDER CONSTRUCTION

MILE POST 0.00 TO MILE POST 4.84

NO SIGNIFICANT CHANGES WERE MADE DURING CONSTRUCTION ON THESE PLANS EXCEPT CHANGES IN THE ORIGINAL THEORETICAL QUANTITIES. FOR ACTUAL QUANTITIES, REFER TO PROJECT LEDGER AND/OR COMPUTATION BOOK.

RESIDENT ENGINEER — DATE 6/3/99

FOR

DEPARTMENT OF TRANSPORTATION
STATE OF HAWAII

APPROVED:

DIR. OF TRANSPORTATION — DATE 7/9/90

UNIT "C"
DESIGNED BY J. KASAMOTO 548-7537 APRIL 1990
P. S. & E. BY PHONE DATE

37D-01-90