FED. ROAD DIST. NO.	STATE	FED. AID PROJ. NO.	FISCAL YEAR	SHEET NO.	TOTAL SHEETS
HAWAII	HAW.	STP-037-1(027)	2019	1	35

37

INDEX TO DRAWINGS

SHEET NO.	DESCRIPTION
1	TITLE SHEET
2	STANDARD PLANS SUMMARY
3	GENERAL NOTES AND LEGEND
4 – 6	WATER POLLUTION & EROSION CONTROL NOTES
7 – 13	GUARDRAIL DETAILS
14 – 35	ROADWAY & PAVEMENT MARKING PLANS

STATE OF HAWAII

DEPARTMENT OF TRANSPORTATION

HIGHWAYS DIVISION

HONOLULU, HAWAII

"AS-BUILT"

PLANS FOR

KULA HIGHWAY
GUARDRAIL AND SHOULDER IMPROVEMENTS

OMAOPIO ROAD TO SUN YAT SEN PARK

FEDERAL-AID PROJECT NO. STP-037-1(027)

DISTRICT OF MAKAWAO

ISLAND OF MAUI

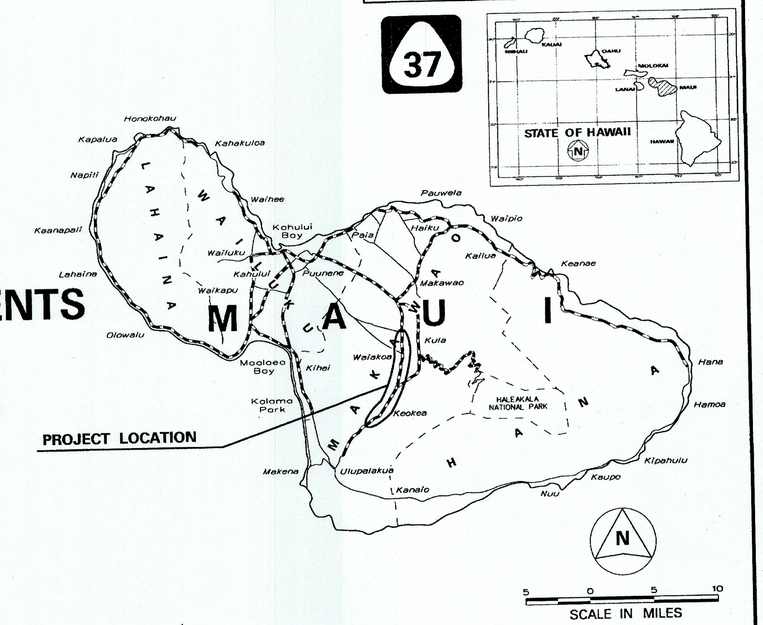

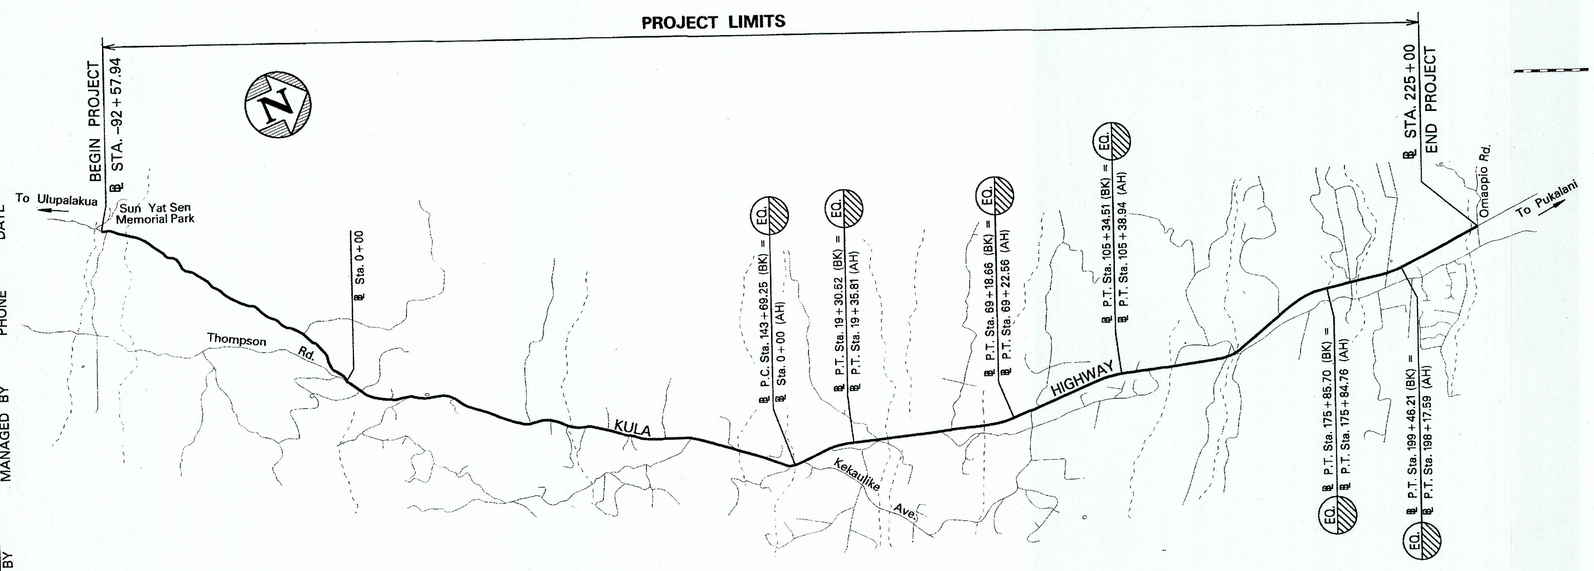

FEDERAL AID PROJECTS PREVIOUSLY CONSTRUCTED OR UNDER CONSTRUCTION

MILE POST 10.01 TO MILE POST 18.50

NO SIGNIFICANT CHANGES WERE MADE DURING CONSTRUCTION ON THESE PLANS EXCEPT CHANGES IN THE ORIGINAL THEORETICAL QUANTITIES. FOR ACTUAL QUANTITIES, REFER TO PROJECT LEDGER AND/OR COMPUTATION BOOK.

S. Biviani 1/4/2021
RESIDENT ENGINEER DATE

LAYOUT PLAN

GROSS LENGTH OF PROJECT..... 8.49 MILES

NET LENGTH OF PROJECT..... 8.49 MILES

DEPARTMENT OF TRANSPORTATION
STATE OF HAWAII

APPROVED:

6/28/19
DIR. OF TRANSPORTATION DATE

HWY-M DESIGNED BY | HWY-ME MANAGED BY | 873-3535 PHONE | DEC., 2018 DATE