INDEX TO DRAWINGS	
SHEET NO.	DESCRIPTION
1	TITLE SHEET
2	STANDARD PLANS SUMMARY
3	GENERAL NOTES AND LEGEND
4 – 5	WATER POLLUTION & EROSION CONTROL NOTES
6	TYPICAL SECTIONS AND DETAILS
7 – 15	ROADWAY PLANS
16 – 24	PAVEMENT MARKING PLANS

FED. ROAD DIST. NO.	STATE	FED. AID PROJ. NO.	FISCAL YEAR	SHEET NO.	TOTAL SHEETS
HAWAII	HAW.	STP–0310(4)	2007	1	24

STATE OF HAWAII

DEPARTMENT OF TRANSPORTATION

HIGHWAYS DIVISION

HONOLULU, HAWAII

"AS-BUILT"

PLANS FOR

NORTH KIHEI ROAD
PAVEMENT PREVENTIVE MAINTENANCE

HONOAPIILANI HIGHWAY TO ~~PILANI HIGHWAY~~ SOUTH KIHEI ROAD

FEDERAL AID PROJECT NO. STP–0310(4)

DISTRICT OF WAILUKU
ISLAND OF MAUI

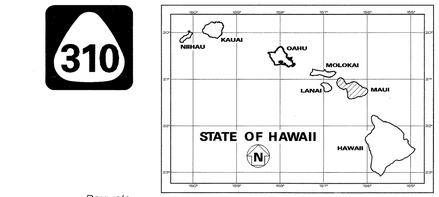

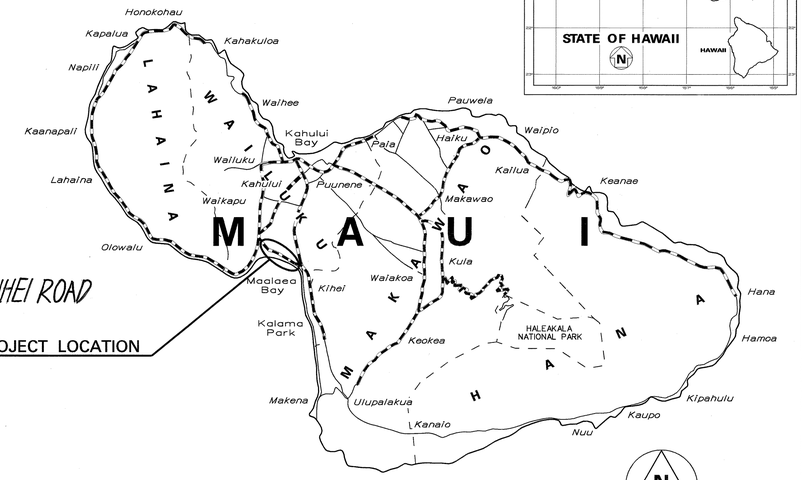

SCALE IN MILES

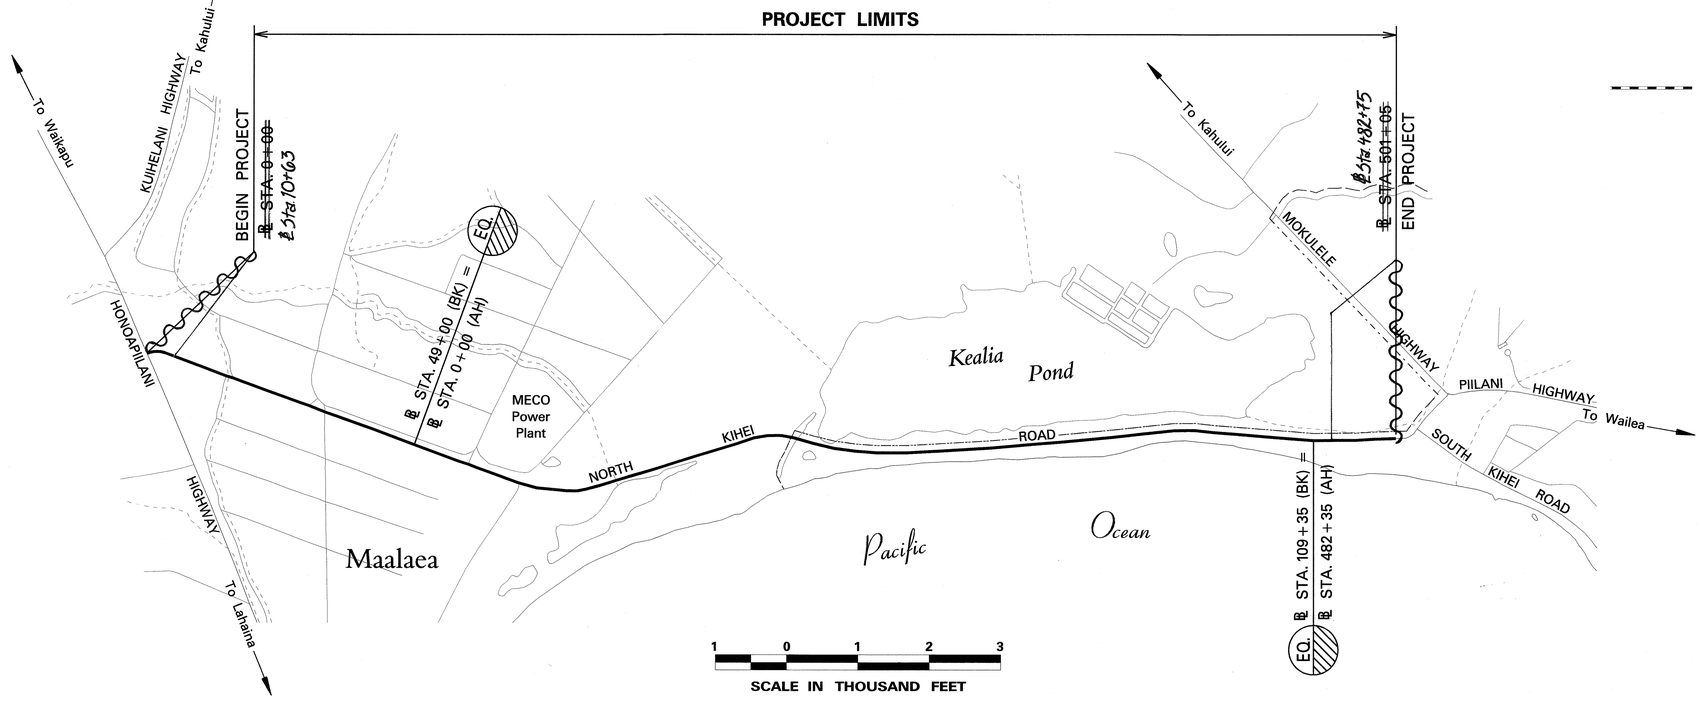

SCALE IN THOUSAND FEET

FEDERAL AID PROJECTS PREVIOUSLY CONSTRUCTED OR UNDER CONSTRUCTION

MILE POST ~~0.00~~ 0.20 TO MILE POST 3.00

DESIGN DESIGNATION

ADT (2007)	19,400
ADT (2017)	24,600
DHV	2,100
D	60/40
T	2.0%
T24	3.0%

CHANGES MADE DURING CONSTRUCTION HAVE BEEN INCORPORATED ON THESE PLANS EXCEPT CHANGES IN THE ORIGINAL THEORETICAL QUANTITIES. FOR ACTUAL QUANTITIES, REFER TO PROJECT LEDGER AND/OR COMPUTATION BOOK.

RESIDENT ENGINEER — 6.24.09 DATE

DEPARTMENT OF TRANSPORTATION
STATE OF HAWAII

APPROVED:

for Glenn M. Okimoto — 9.20.07
DIR. OF TRANSPORTATION — DATE

HWY-M DESIGNED BY
HWY-ME MANAGED BY
873-3535 PHONE
AUG., 2007 DATE