FED. ROAD DIST. NO.	STATE	FED. AID PROJ. NO.	FISCAL YEAR	SHEET NO.	TOTAL SHEETS
HAWAII	HAW.	SOS-0900 (21)	1984	5	12

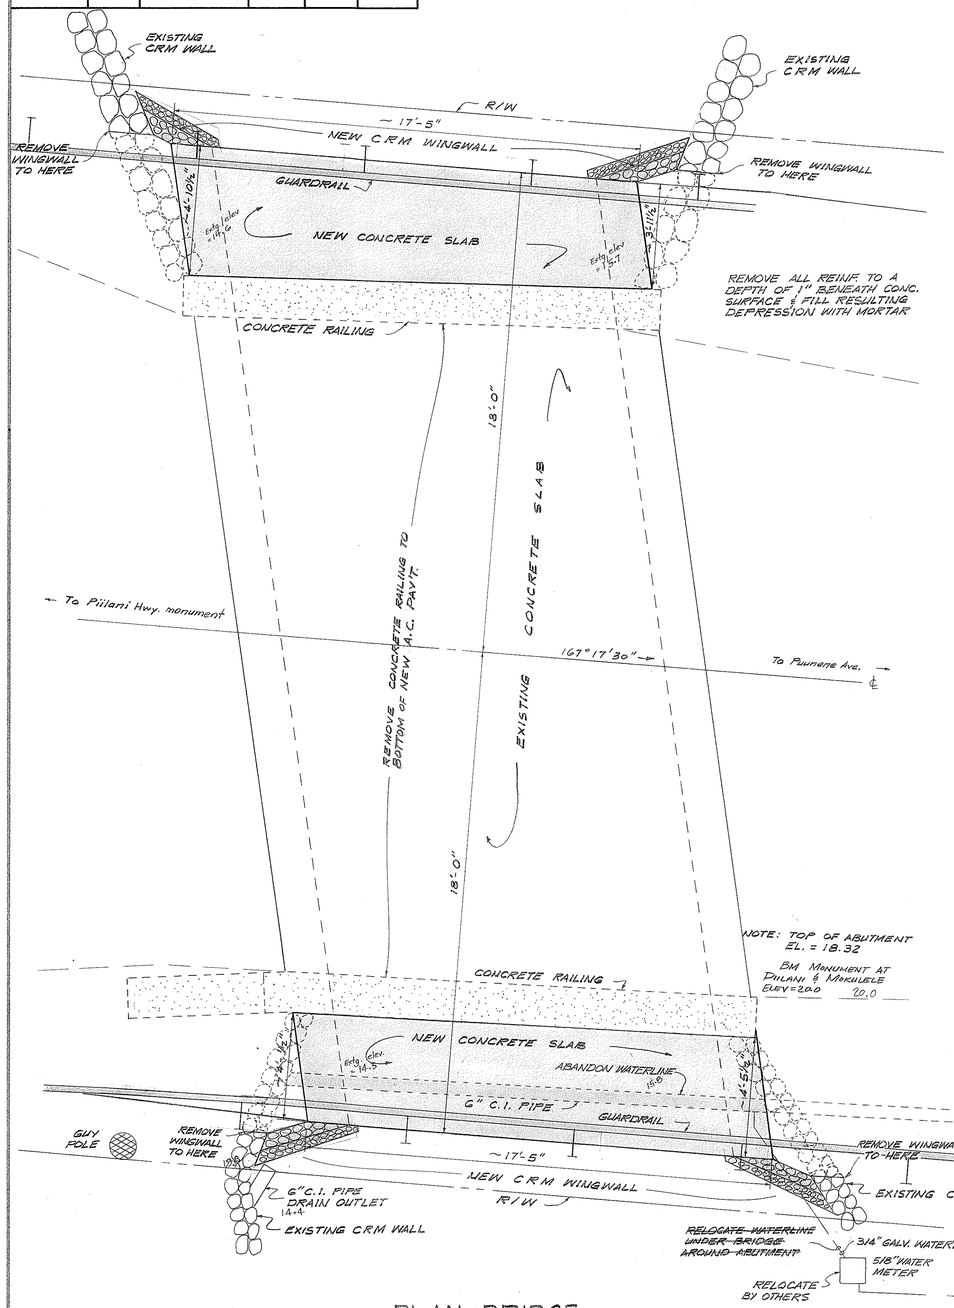

PLAN-BRIDGE

SCALE: 3/8"=1'-0"

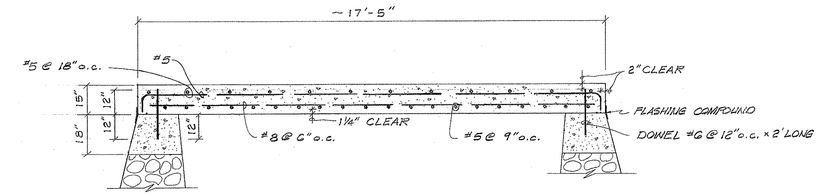

LONGITUDINAL SECTION

SCALE: 3/8"=1'-0"

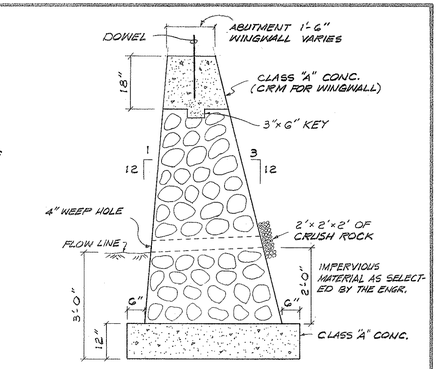

TYPICAL ABUTMENT & WINGWALL

SCALE: 1/2"=1'-0"

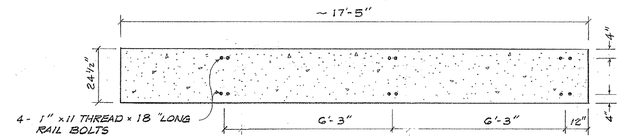

OUTSIDE VIEW OF BRIDGE FOR GUARD RAIL BOLTS DETAIL

SCALE: 3/8"=1'-0"

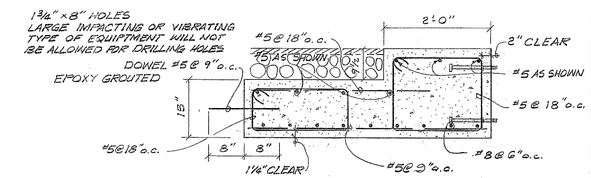

TRANSVERSE SECTION

SCALE: 3/4"=1'-0"

BRIDGE DETAILS

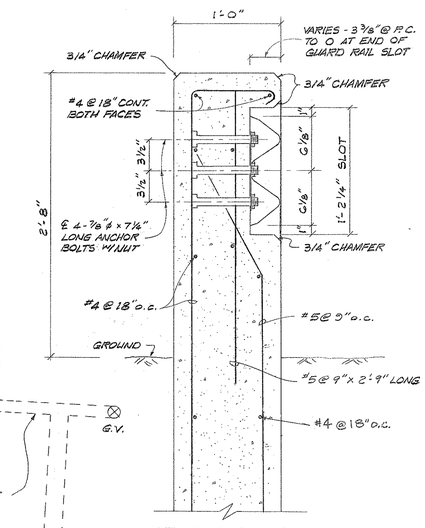

SECTION A-A

SCALE: 1½"=1'-0"

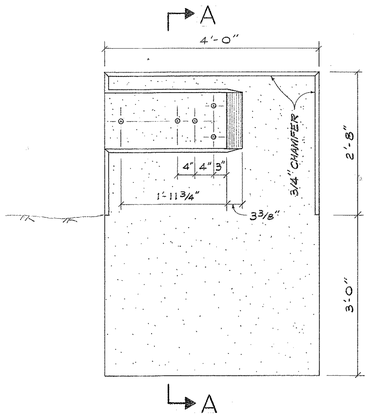

ELEVATION

SCALE: 3/4"=1'-0"

GUARD RAIL END STRUCTURE

(TO BE PAID FOR AS CLASS A CONCRETE)

COUNTY OF MAUI
DEPARTMENT OF PUBLIC WORKS

BRIDGE PLAN & DETAILS

10:6