FED. ROAD DIST. NO.	STATE	FED. AID PROJ. NO.	FISCAL YEAR	SHEET NO.	TOTAL SHEETS
HAWAII	HAW.	SOS-0900(21)	1984	6	12

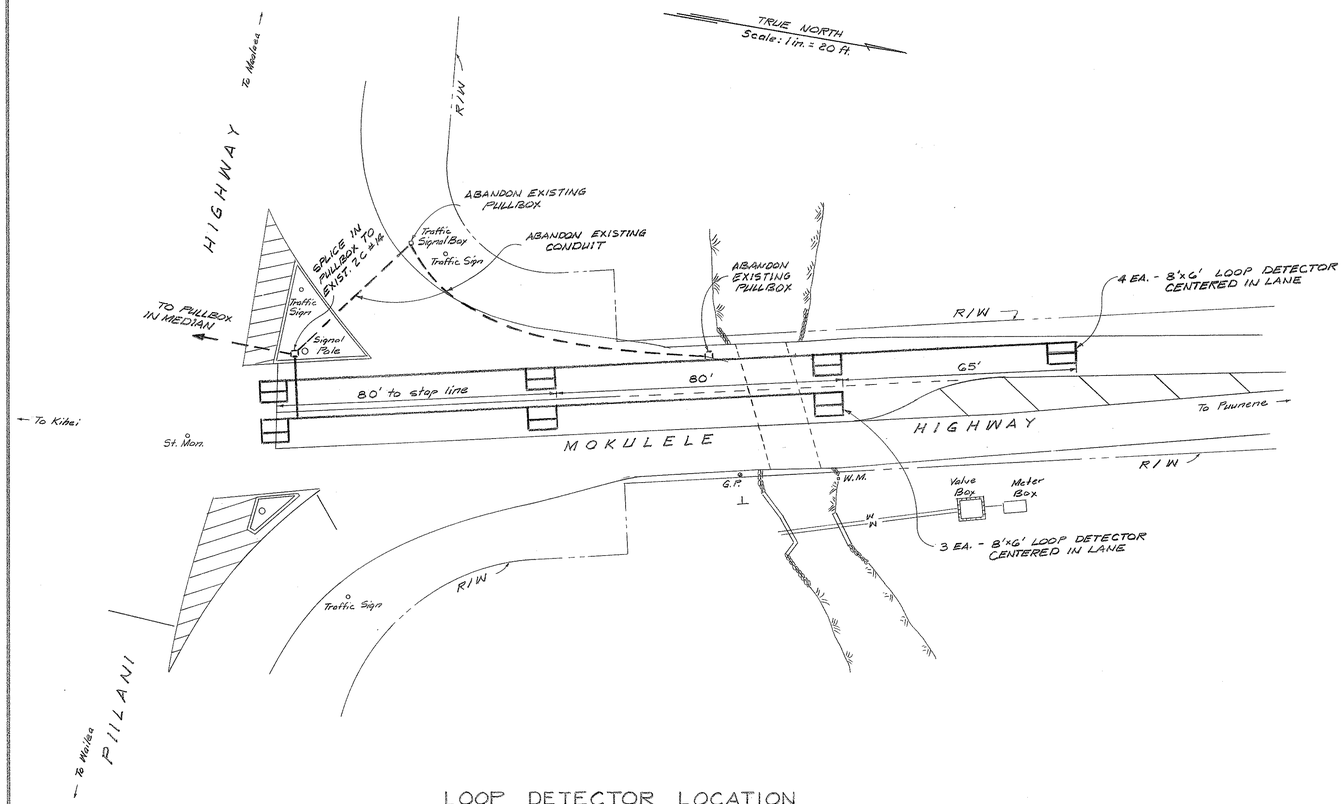

LOOP DETECTOR LOCATION

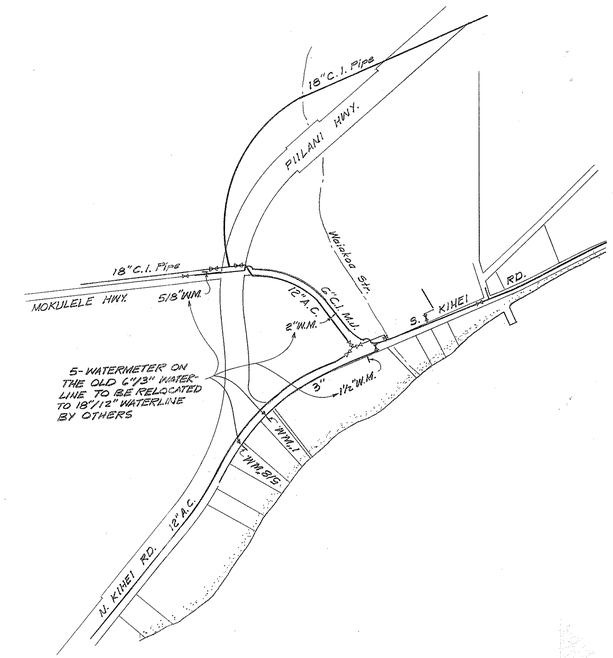

RELOCATE WATERMETER

COUNTY OF MAUI
DEPARTMENT OF PUBLIC WORKS

LOOP DETECTOR
RELOCATE WATERMETER

10:6