INDEX TO DRAWINGS	
SHEET NO.	DESCRIPTION
1	TITLE SHEET
2	STANDARD PLANS SUMMARY
3	GENERAL NOTES AND LEGEND
4 – 5	WATER POLLUTION & EROSION CONTROL NOTES
6 – 9	TYPICAL SECTIONS & DETAILS
10	CURB RAMP DETAILS
11 – 19	ROADWAY PLANS
20	PAVEMENT MARKING LEGEND, DETAILS & NOTES
21 – 22	RUMBLE STRIP DETAILS & NOTES
23	WORK ZONE SIGNING PLAN, NOTES & DETAILS
24 – 32	SIGNING & PAVEMENT MARKING PLANS

STATE OF HAWAII

DEPARTMENT OF TRANSPORTATION

HIGHWAYS DIVISION

HONOLULU, HAWAII

"AS-BUILT"

PLANS FOR

RTE 311 MOKULELE HIGHWAY PAVEMENT PREVENTIVE MAINTENANCE

KUIHELANI HIGHWAY TO MAUI HUMANE SOCIETY

FEDERAL–AID PROJECT NO. NH–A311(008)

DISTRICT OF WAILUKU

ISLAND OF MAUI

FED. ROAD DIST. NO.	STATE	FED. AID PROJ. NO.	FISCAL YEAR	SHEET NO.	TOTAL SHEETS
HAWAII	HAW.	NH–A311(008)	2014	1	32

311

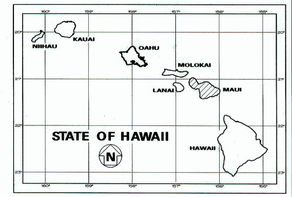

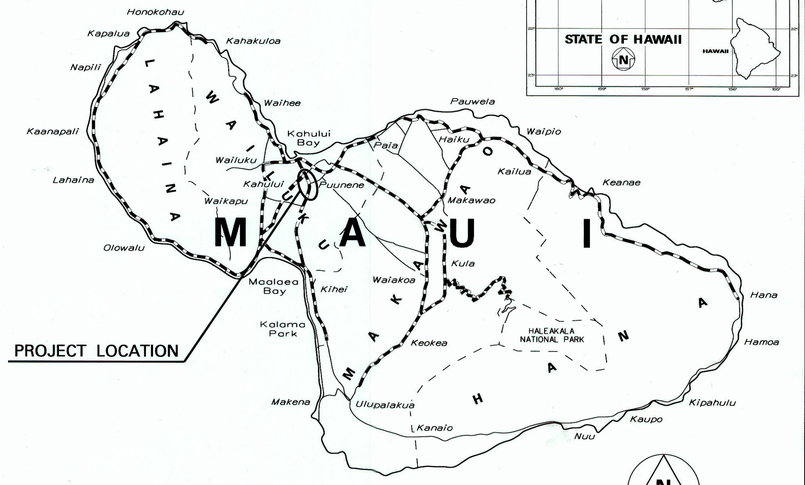

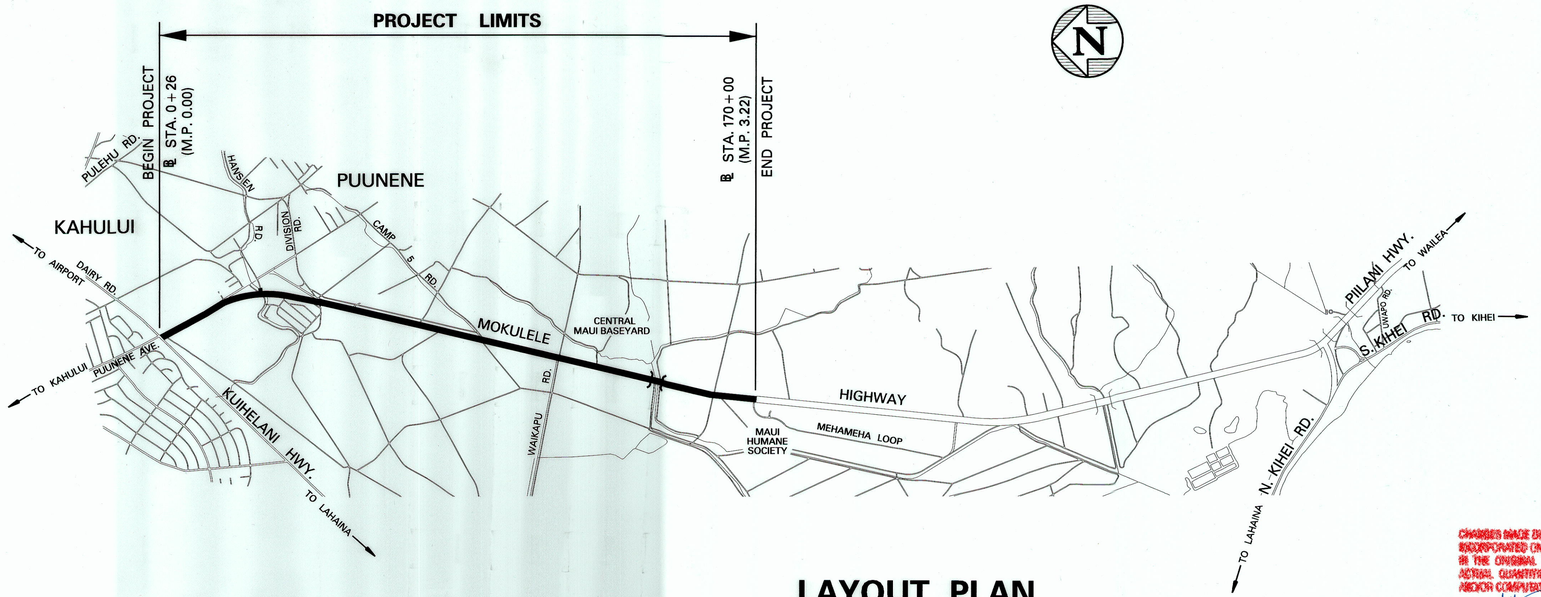

FEDERAL AID PROJECTS PREVIOUSLY CONSTRUCTED OR UNDER CONSTRUCTION

MILE POST 0.00 TO MILE POST 3.22±

LAYOUT PLAN

GROSS LENGTH OF PROJECT..... 3.22 MILES

NET LENGTH OF PROJECT..... 3.22 MILES

DESIGN DESIGNATION

ADT (2013)	32,200
ADT (2023)	37,000
DHV (2013)	2,960
DESIGN K	8.0
DESIGN D	55/45
DESIGN T	4.5
T_{24}	4.5
V	40 M.P.H.

CHANGES MADE DURING CONSTRUCTION HAVE BEEN INCORPORATED ON THESE PLANS EXCEPT CHANGES IN THE ORIGINAL THEORETICAL QUANTITIES. FOR ACTUAL QUANTITIES, REFER TO PROJECT LEDGER AND/OR COMPUTATION BOOK.

RESIDENT ENGINEER — DATE 6/8/16

DEPARTMENT OF TRANSPORTATION
STATE OF HAWAII

APPROVED:

for DIR. OF TRANSPORTATION — DATE 4/21/14

HWY–M DESIGNED BY

HWY–ME MANAGED BY

873–3535 PHONE

FEB., 2014 DATE