| FED. ROAD DIST. No. | STATE | FED. AID PROJ. No. | FISCAL YEAR | SHEET No. | TOTAL SHEETS |
|---|---|---|---|---|---|
| HAWAII | HAW. | S-0330(6) | 1967 | 41 | 47 |

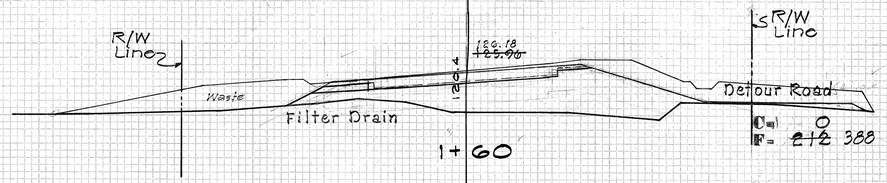


Exc= ~~36~~ 33
Emb= ~~210~~ 407

Detour Road
C= 0
F= 6

Detour Road
C= ~~48~~ 44
F= ~~84~~ 162

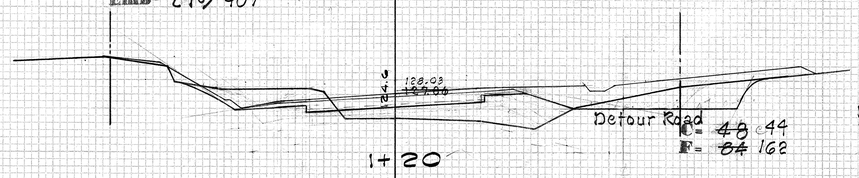


Detour Road
C= 54
F= 0

Exc= ~~132~~ 123
Emb= ~~73~~ 139

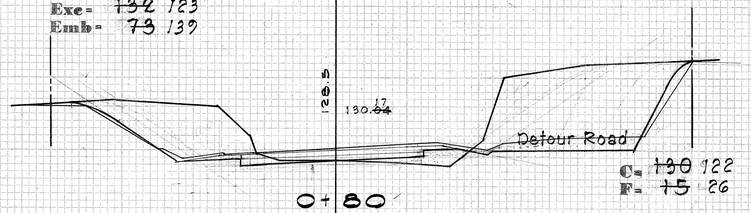


Detour Road
C= 268
F= 0

Exc= ~~130~~ 122
Exc= ~~15~~ 26

Exc= ~~253~~ 246
Emb= ~~16~~ 24

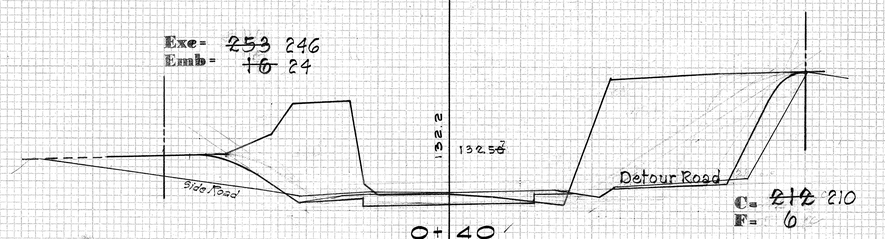


Detour Road
C= 362
F= 0

C= ~~212~~ 210
F= 6

Exc= ~~230~~ 216
Emb= ~~6~~ 7

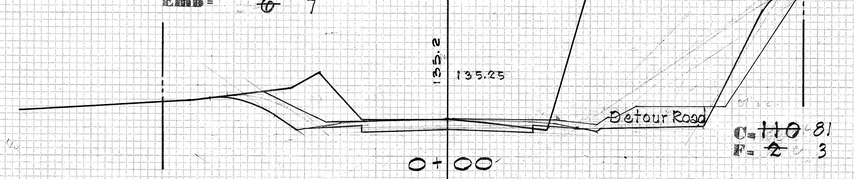


Detour Road
C= 490
F= 0

C= ~~110~~ 81
F= ~~2~~ 3

Exc. = ~~61~~ 45
Emb. = 2

C = 0
F = 0

0 - 30



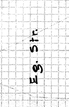

| FED. ROAD DIST. No. | STATE | FED. AID PROJ. No | FISCAL YEAR | SHEET No. | TOTAL SHEETS |
|---|---|---|---|---|---|
| HAWAII | HAW. | 50330(2) | 1967 | 42 | 47 |

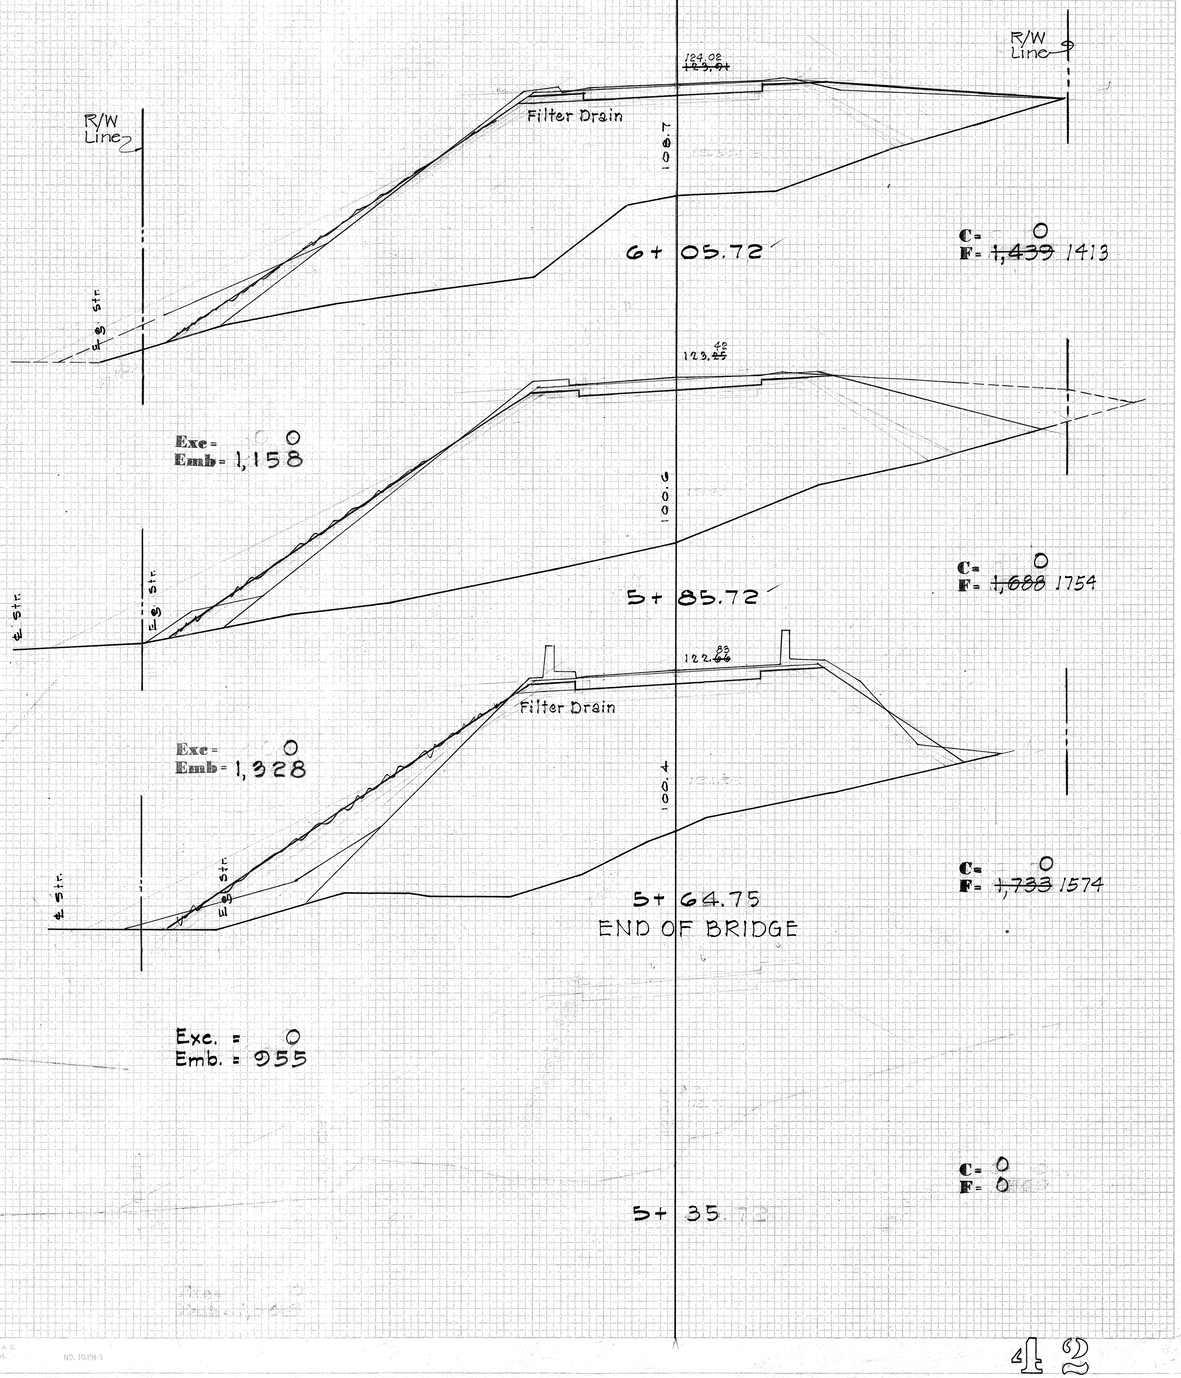


PLATE 3-CROSS SECTION, F.A.S.
CLEARPRINT PAPER CO., S.F. CAL.
NO. 1GRM-3

42

| FED. ROAD DIST. No. | STATE | FED. AID PROJ. No. | FISCAL YEAR | SHEET No. | TOTAL SHEETS |
|---|---|---|---|---|---|
| HAWAII | HAW. | S-0330(9) | 1967 | 43 | 47 |

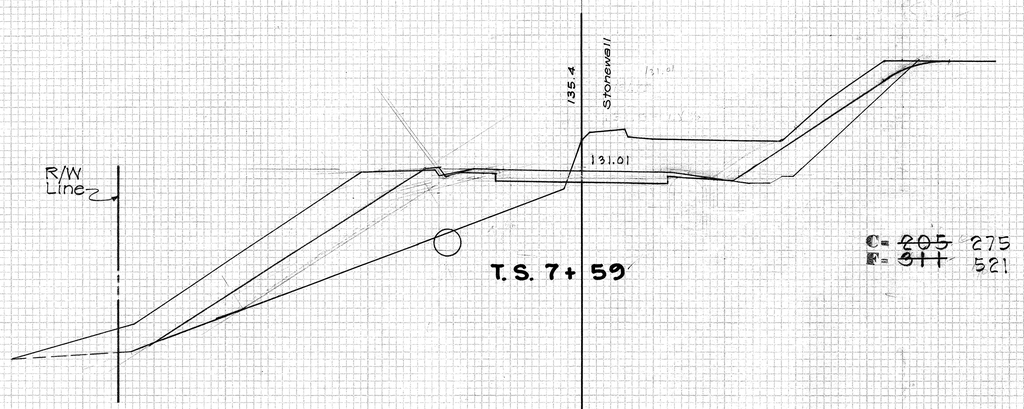


T.S. 7+59

C= ~~205~~ 275
F= ~~311~~ 521

Exc= ~~103~~ 128
Emb= ~~250~~ 349

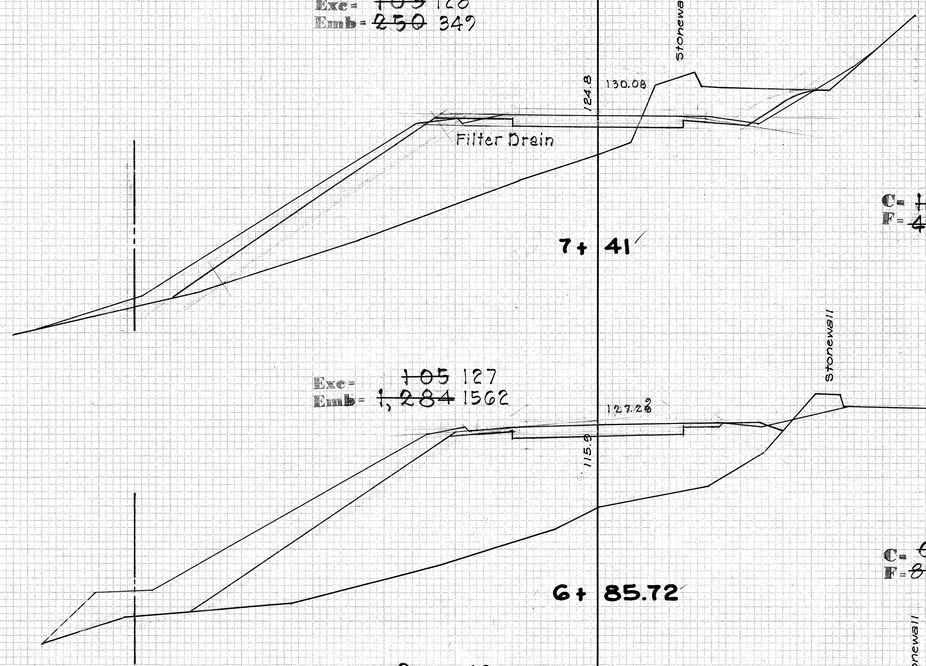


7+41

C= ~~103~~ 110
F= ~~438~~ 526

Exc= ~~105~~ 127
Emb= ~~1,284~~ 1562




6+85.72

C= ~~0~~ 14
F= ~~816~~ 1,000

Exc= ~~0~~ 10
Emb= ~~1,396~~ 1612

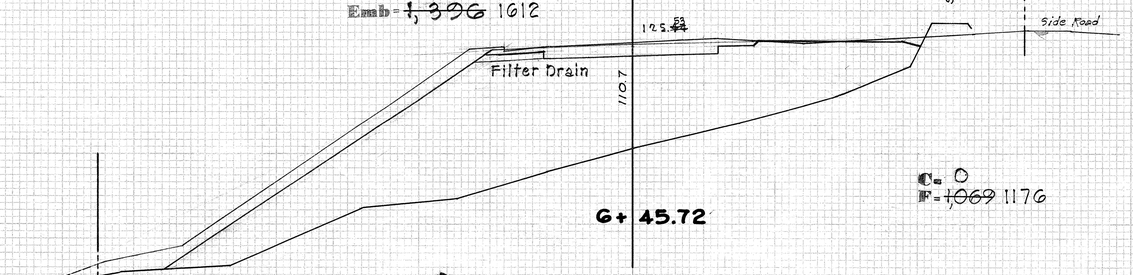


6+45.72

C= 0
F= ~~1,069~~ 1176

Exc= 0
Emb= 1,858

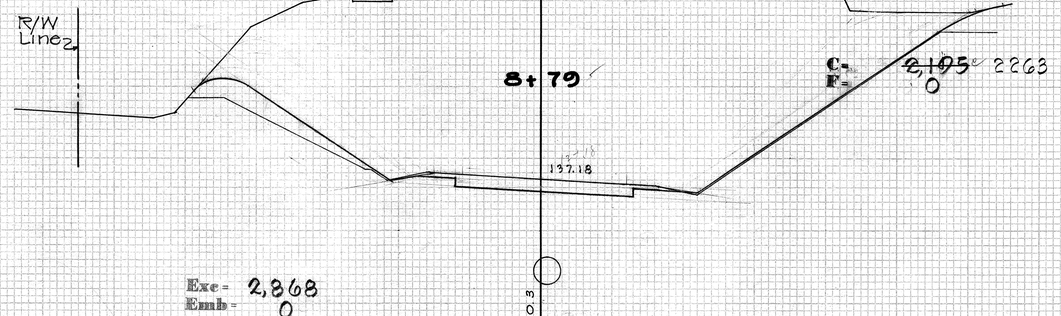


8+79

C= ~~2,195~~ 2263
F= 0

Exc= 2,868
Emb= 0

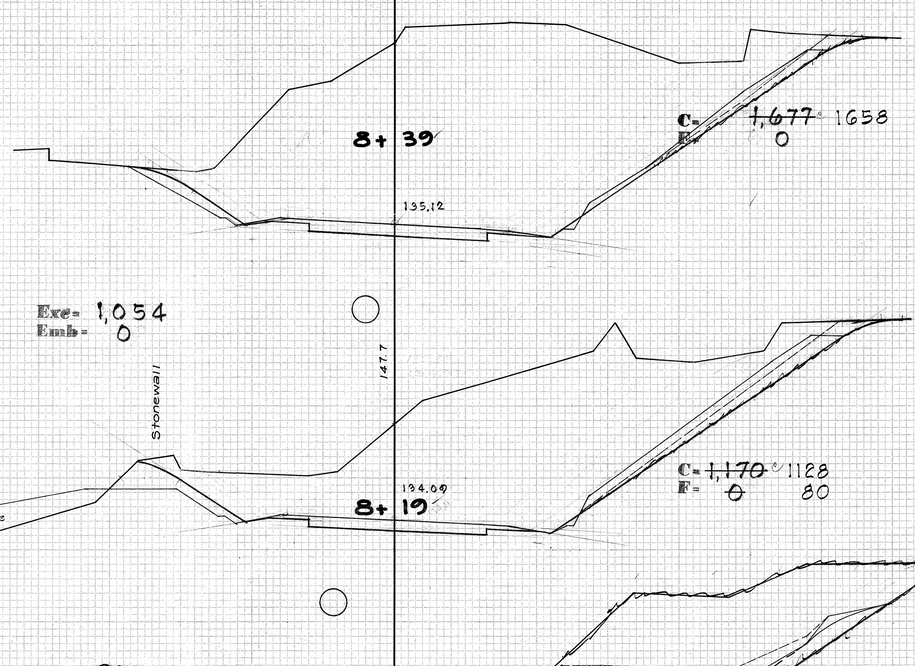


8+39

C= ~~1,677~~ 1658
F= 0

Exc= 1,054
Emb= 0

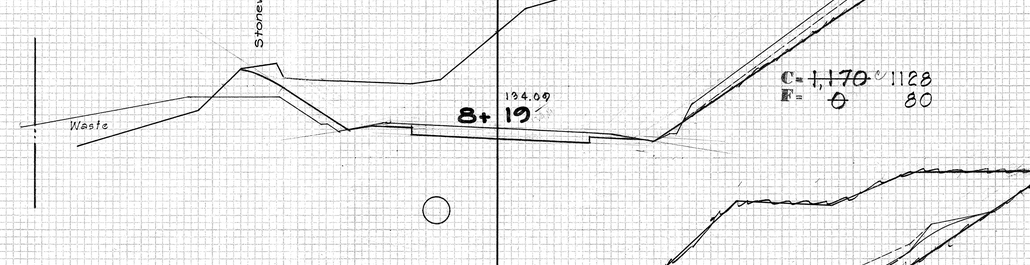


8+19

C= ~~1,170~~ 1128
F= 0 80

Exc= 906
Emb= 0

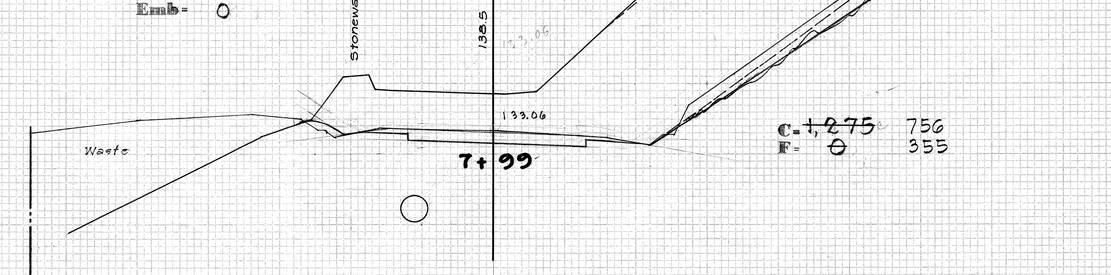


7+99

C= ~~1,275~~ 756
F= 0 355

Exc= 1,096
Emb= 230

| FED. ROAD DIST. No. | STATE | FED. AID PROJ. No. | FISCAL YEAR | SHEET No. | TOTAL SHEETS |
|---|---|---|---|---|---|
| | HAWAII | S-0330(2) | 1967 | 44 | 47 |

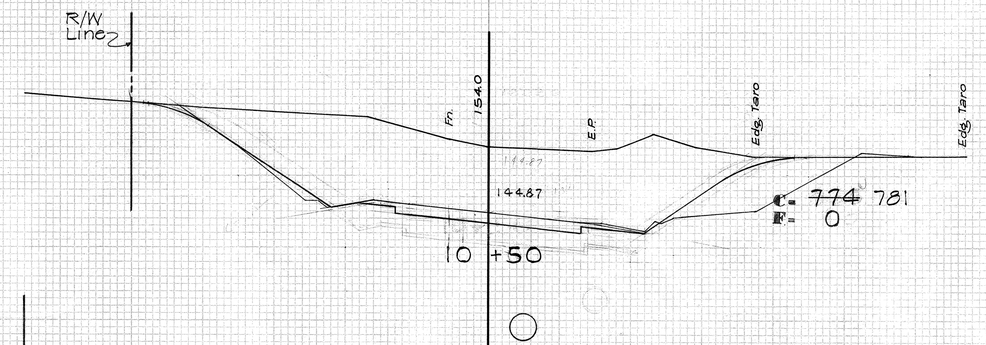


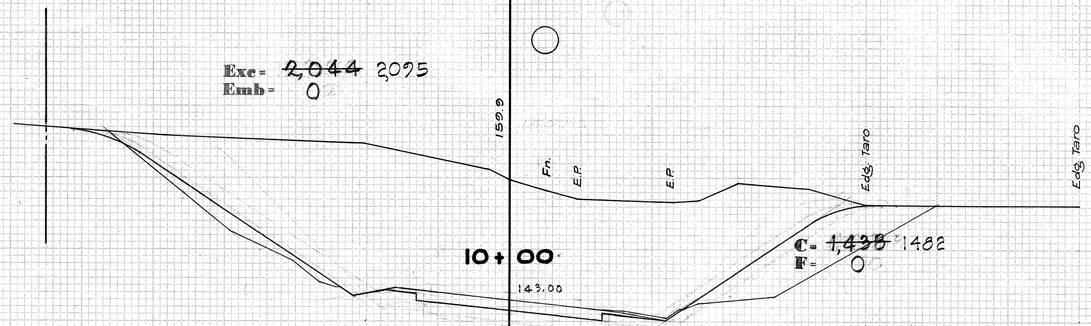


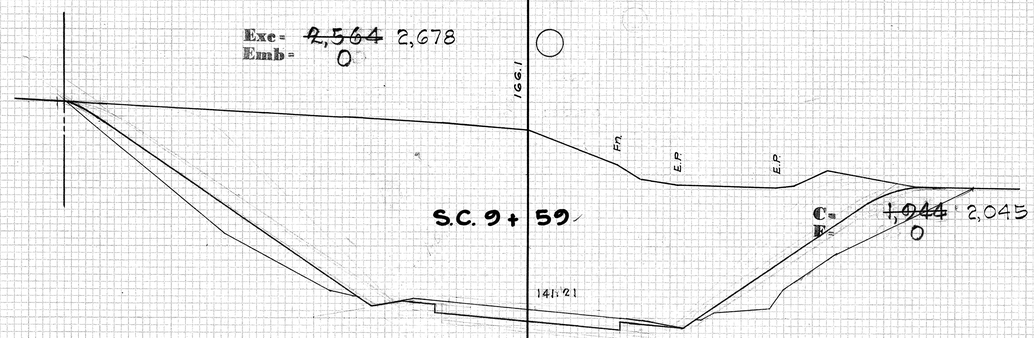


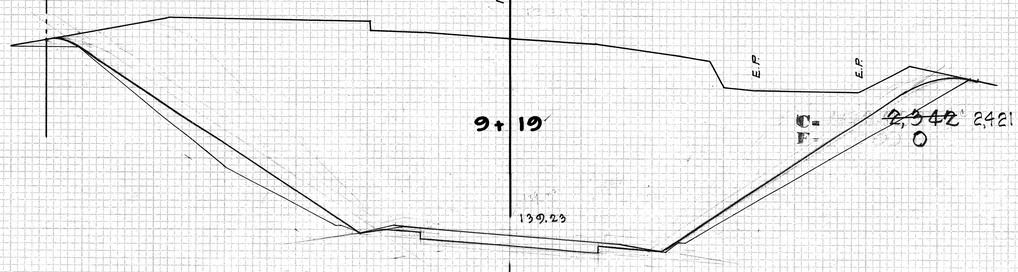


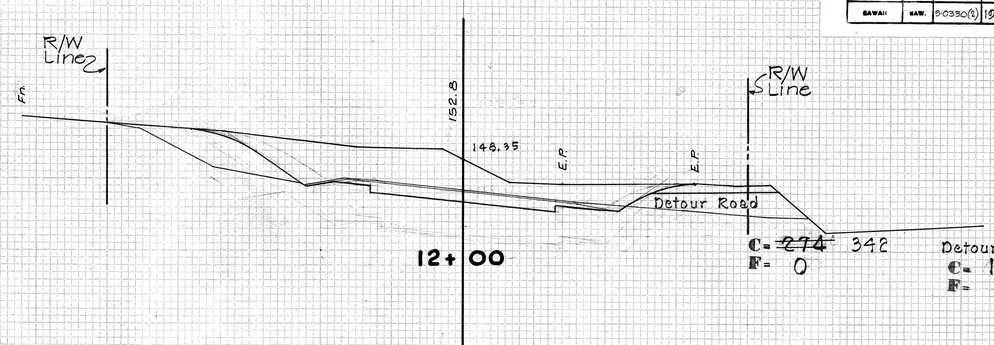


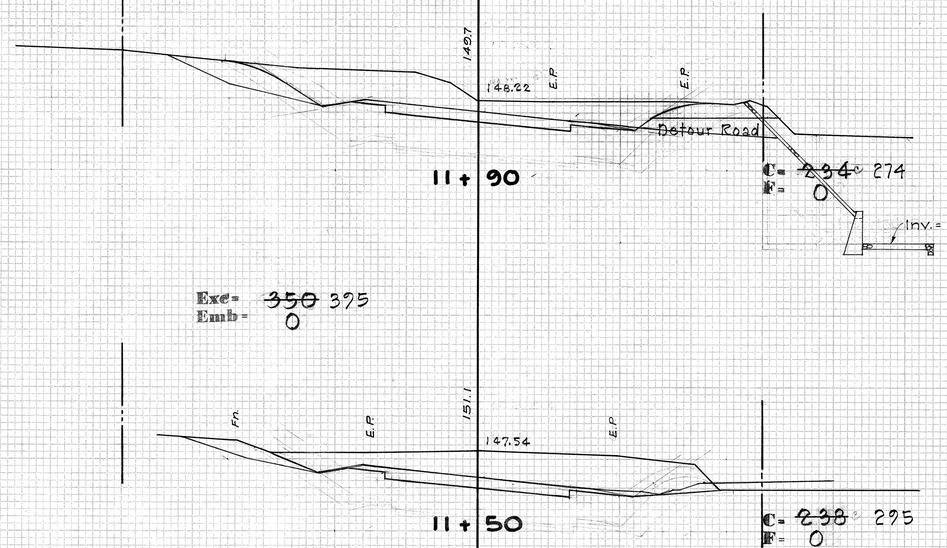





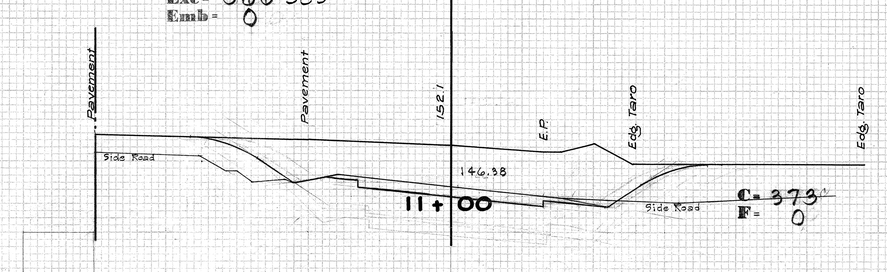


PLATE 3 - CROSS SECTION, F.A.S.
CLEARPRINT PAPER CO., S.F. CAL.
NO. 10004-3

4 4

| FED. ROAD DIST. No. | STATE | FED. AID PROJ. No. | FISCAL YEAR | SHEET No. | TOTAL SHEETS |
|---|---|---|---|---|---|
| | HAW. | S-0330(2) | 1967 | 45 | 47 |

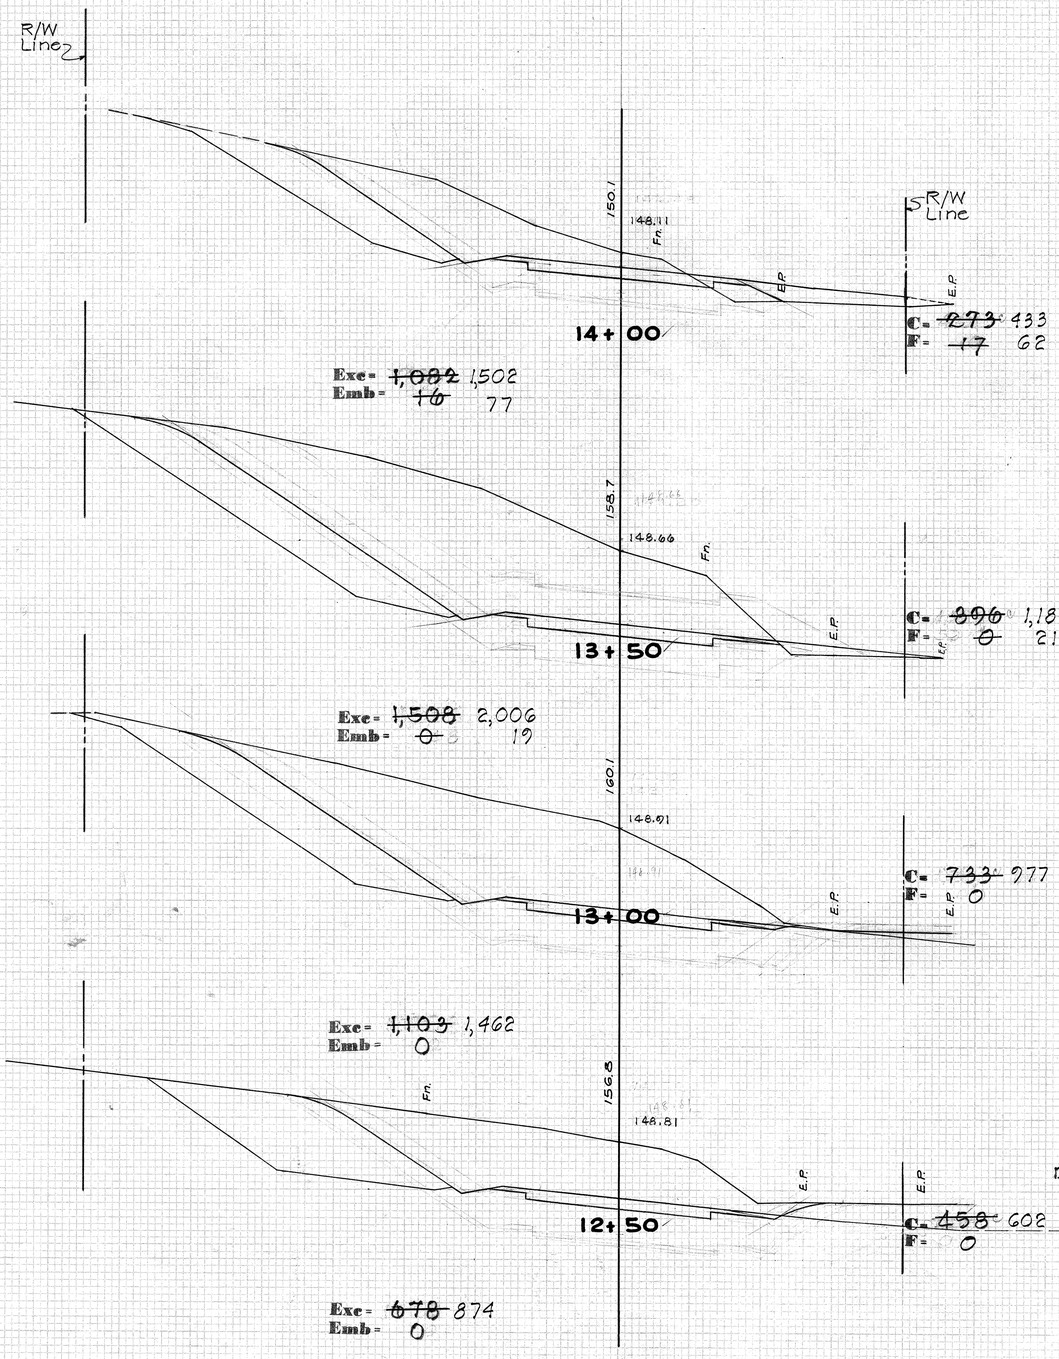


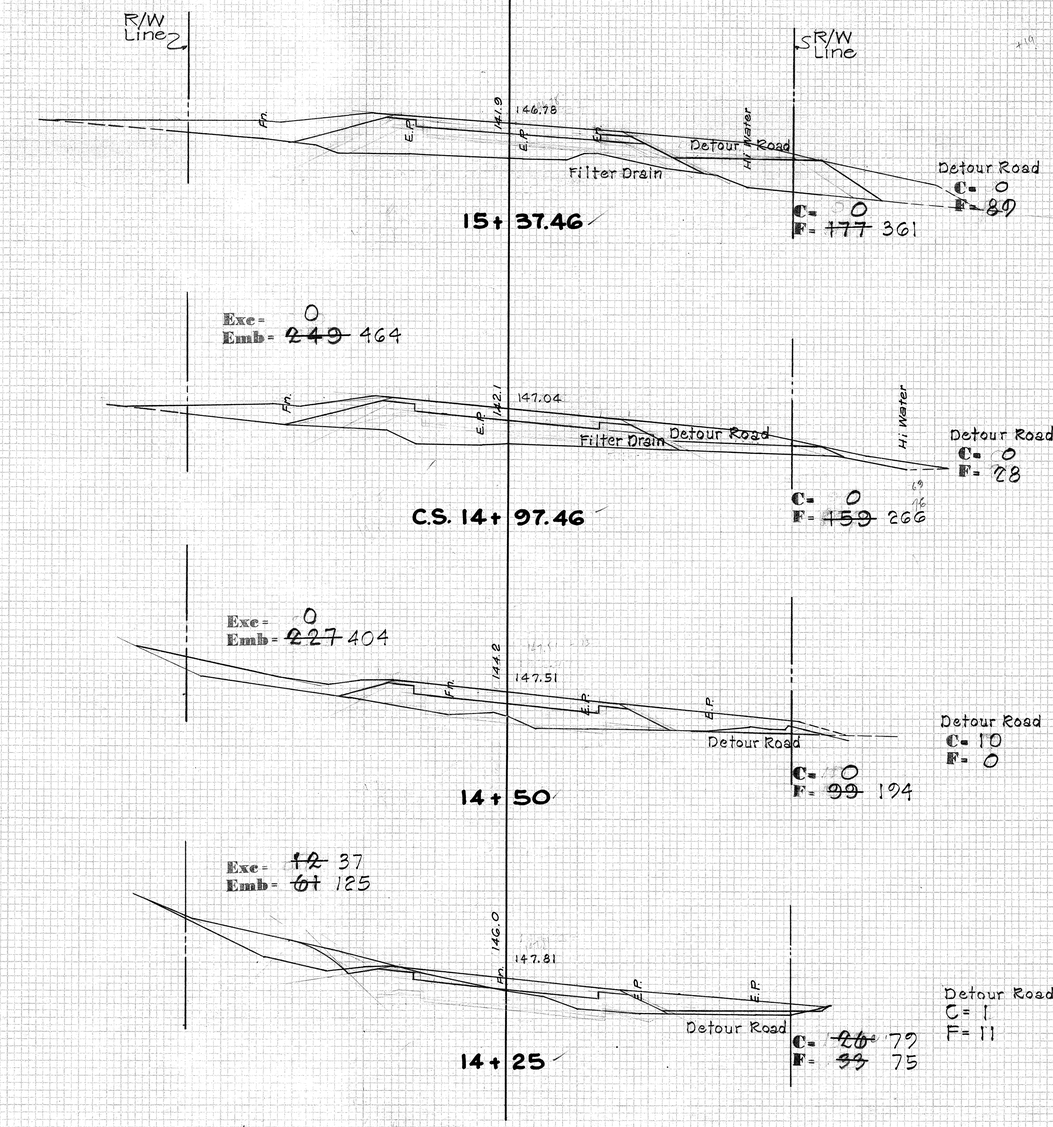


FINAL SURVEY — ORIGINAL SURVEY — SURVEYED — PLOTTED — TRACED — CHECKED — NOTE BOOK — NO. — BY — DATE

PLATE 3 - CROSS SECTION, F.A.S. CLEARPRINT PAPER CO. S. F. CAL. NO. 1002M-3

| FED. ROAD DIST. No. | STATE | FED. AID PROJ. No. | FISCAL YEAR | SHEET No. | TOTAL SHEETS |
|---|---|---|---|---|---|

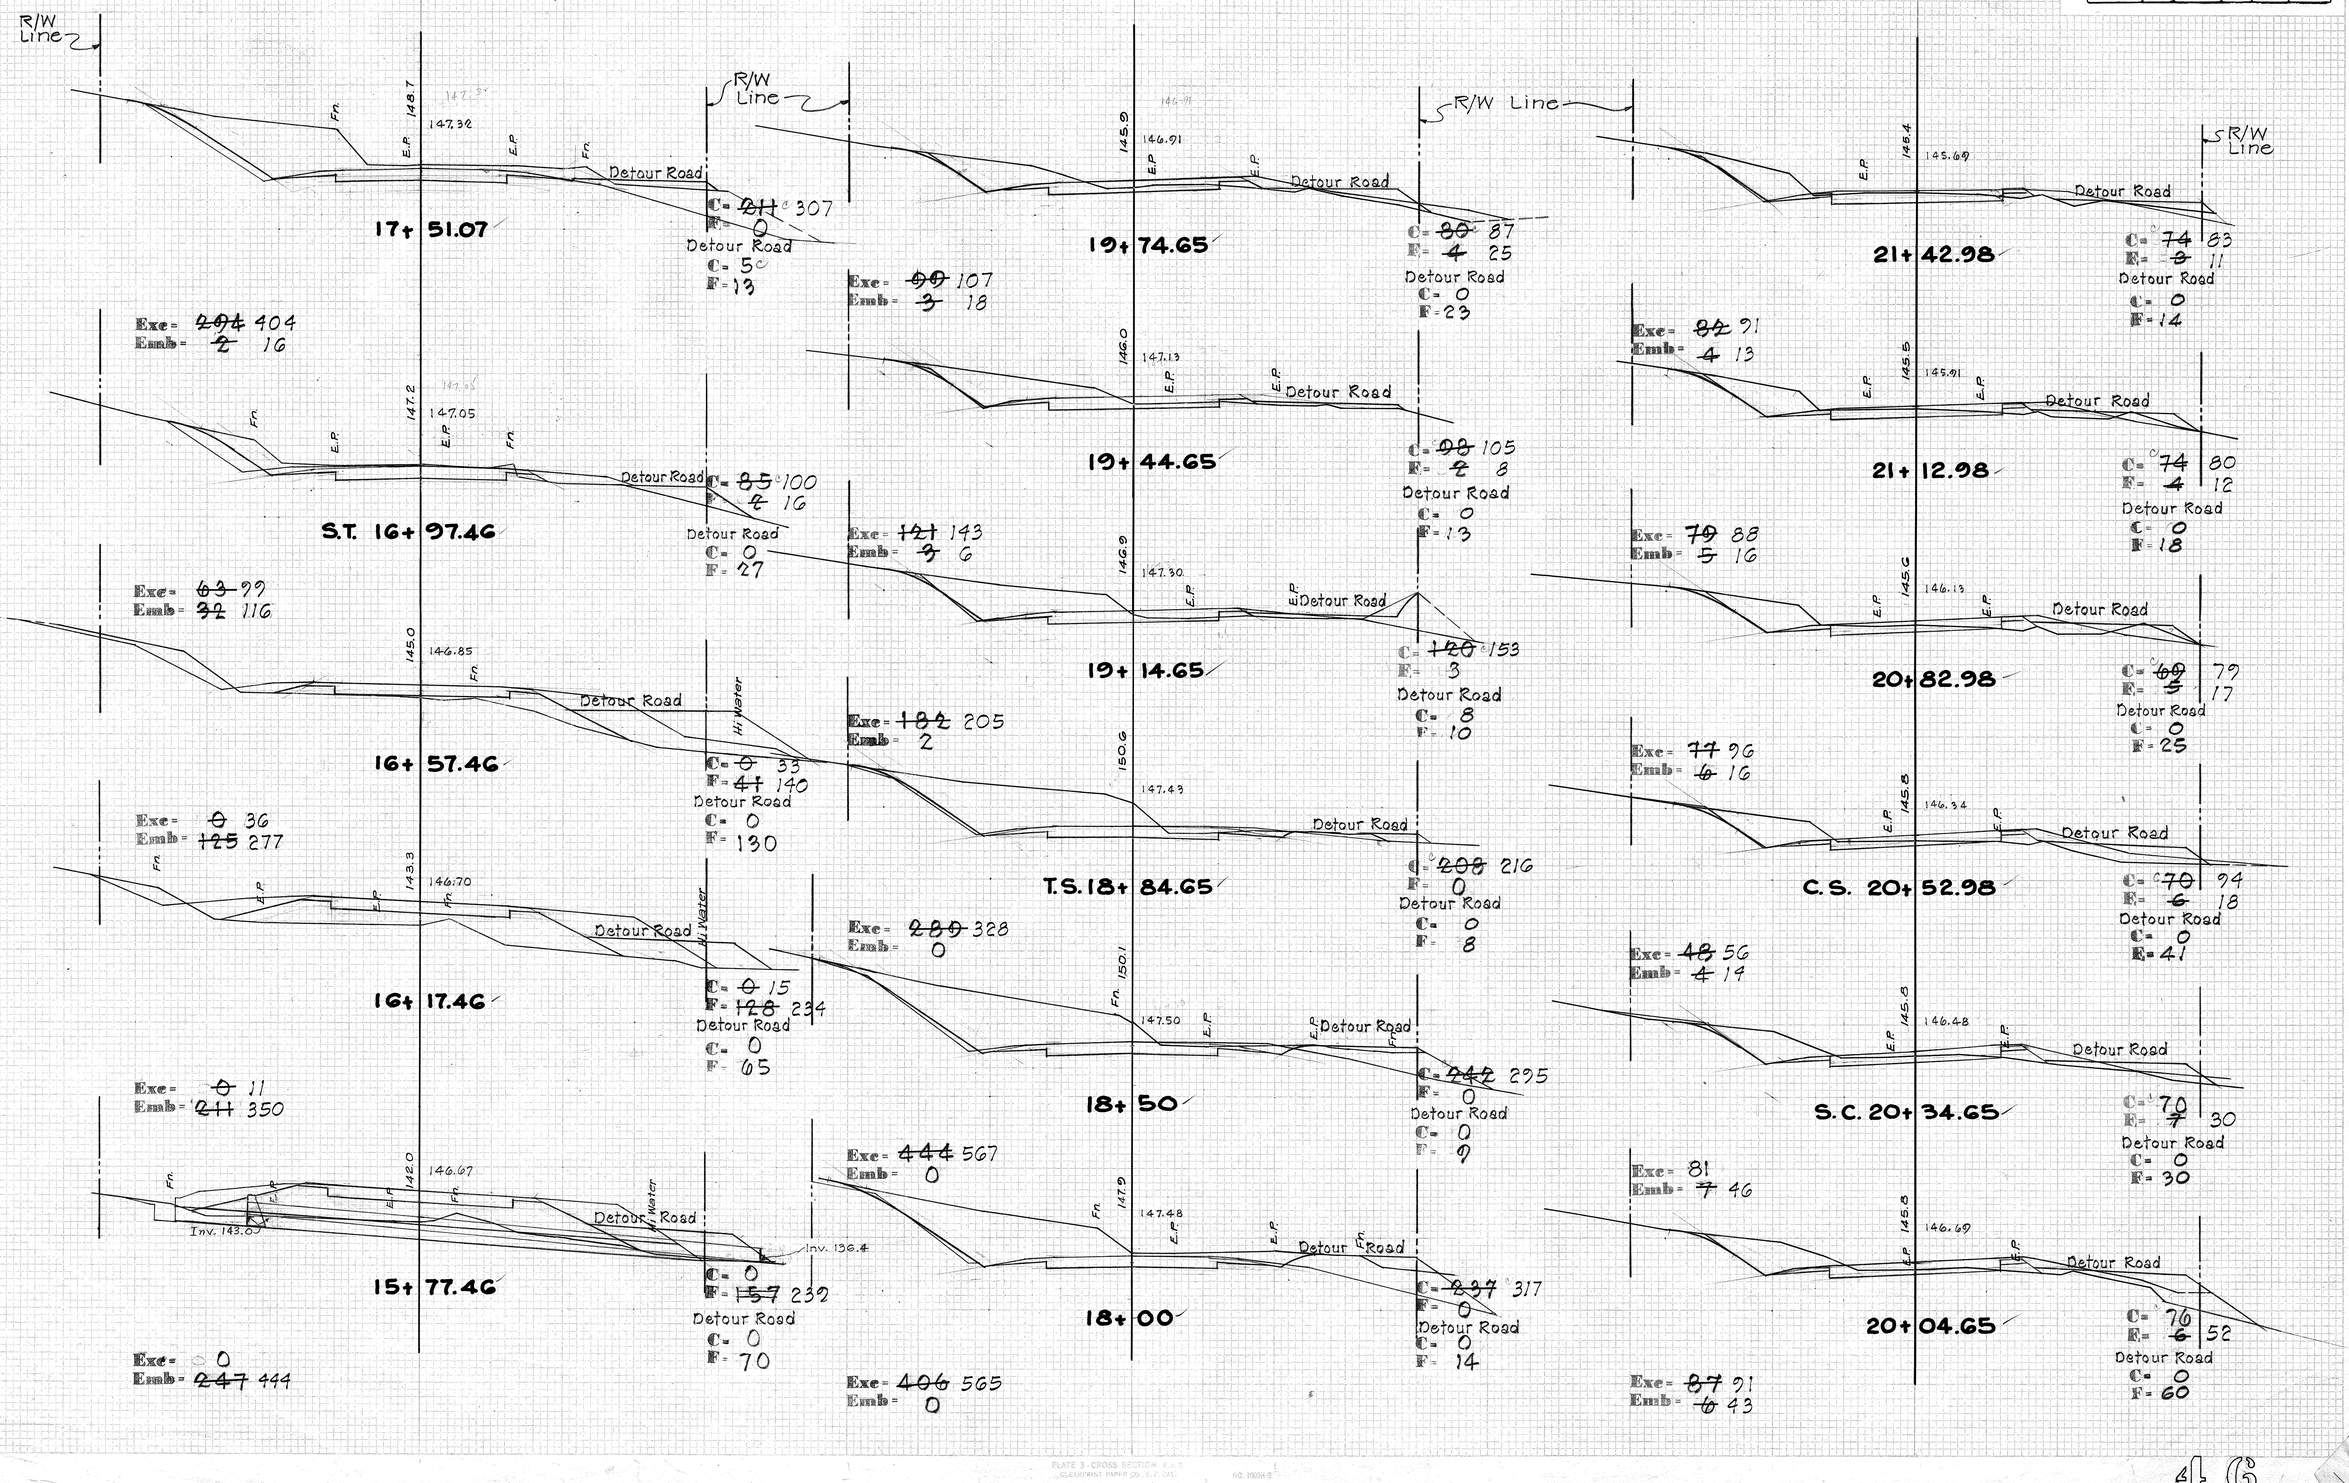


PLATE 3 - CROSS SECTION
CLEARPRINT PAPER CO., S. F. CAL.
NO. 1900-S

46

| FED. ROAD DIST. No. | STATE | FED. AID PROJ. No. | FISCAL YEAR | SHEET No. | TOTAL SHEETS |
|---|---|---|---|---|---|
| | HAW. | (50330(2)) | 1967 | 47 | 47 |