FED. ROAD DIST. NO.	STATE	FED. AID PROJ. NO.	FISCAL YEAR	SHEET NO.	TOTAL SHEETS
HAWAII	HAW.	S-0330(2)	1967	5	47

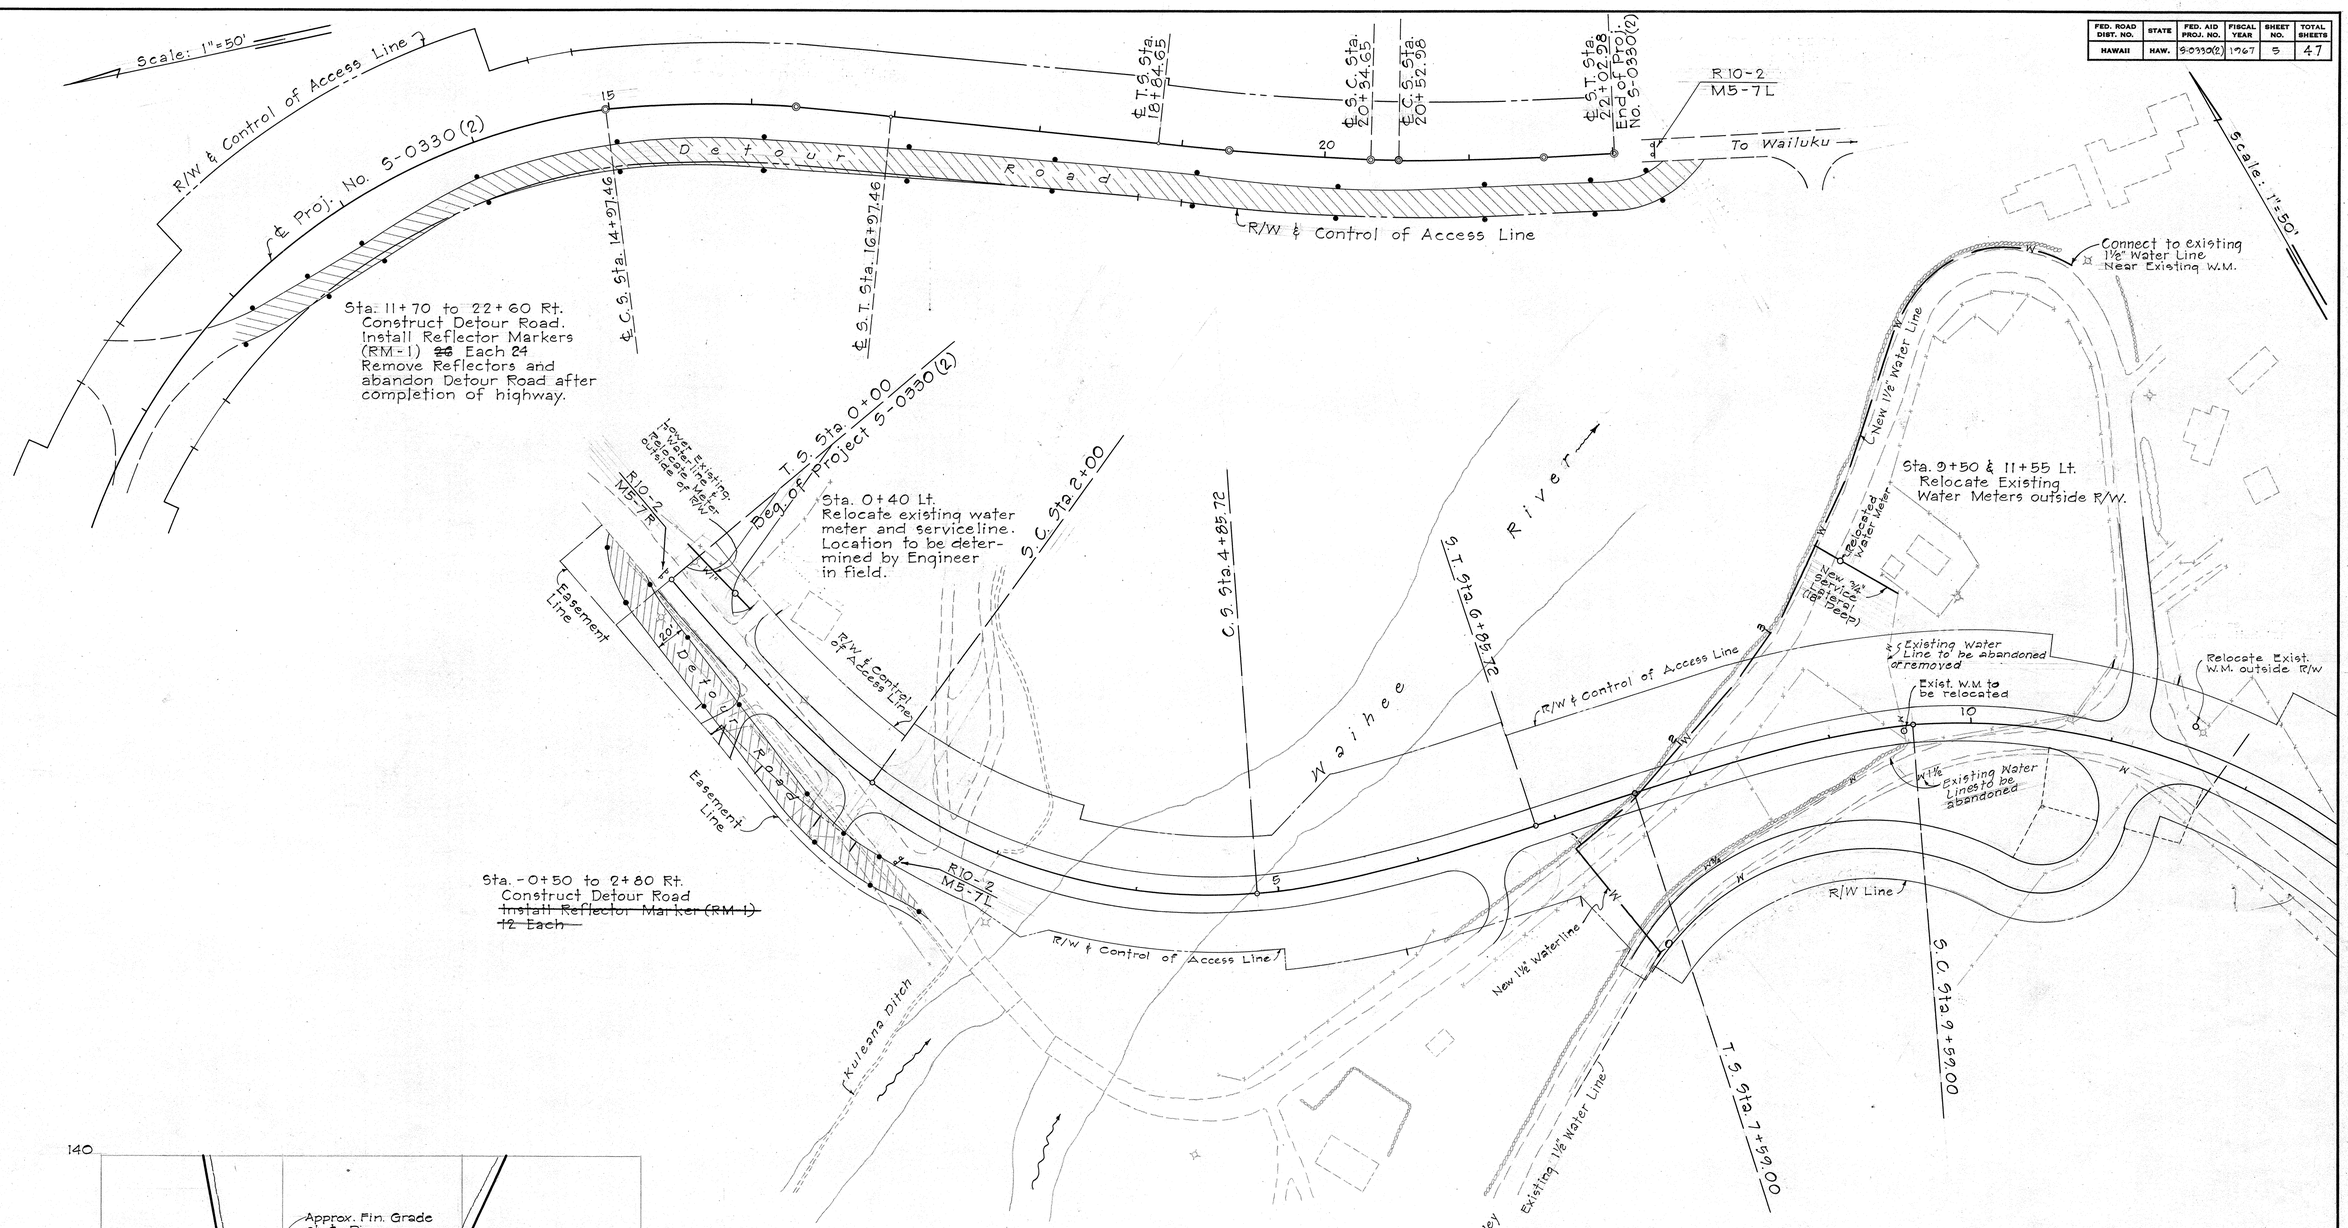

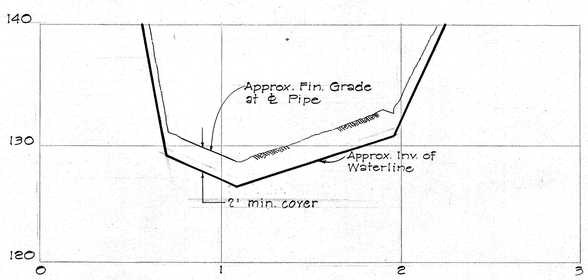

PARTIAL PROFILE AT ℄ 1½" WATERLINE

Not to Scale

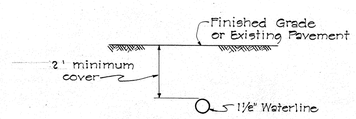

TYPICAL SECTION
1½" WATERLINE

Not to Scale

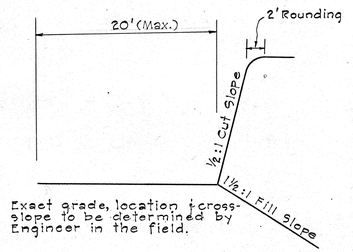

Exact grade, location & cross-slope to be determined by Engineer in the field.

TYPICAL SECTION-DETOUR ROADS

Scale: ⅛" = 1'-0"

STATE OF HAWAII
DEPARTMENT OF TRANSPORTATION
HIGHWAYS DIVISION

DETOUR ROADS AND
ADJUSTMENTS TO WATER SYSTEM

KAHEKILI HIGHWAY
WAIHEE BRIDGE & APPROACHES
F.A.S.P. No. S-0330 (2)

Scale: As Noted Date: Oct. 1966

SHEET No. 1 OF 1 SHEETS

ORIGINAL PLAN		DATE
	SURVEY PLOTTED BY	
	DRAWN BY	" " " "
	TRACED BY	
NOTE BOOK	DESIGNED BY	
	QUANTITIES BY	
No.	CHECKED BY	

5