FED. ROAD DIST. No.	STATE	FED. AID PROJ. No.	FISCAL YEAR	SHEET No.	TOTAL SHEETS
HAWAII	HAW.	S-0330(6)	1967	37	47

Exc = 72
Emb = 0

133.4
130.90
1+75

C = 88
F = 0

Exc = 78
Emb = 0

136.6
133.24
1+50

C = 81
F = 0

Exc = 100
Emb = 0

136.2
135.36
1+00

C = 27
F = 0

Exc = 8
Emb = 3

Exc = 81
Emb = 0

136.7
134.11
0+50

C = 61
F = 0

126.7
126.70
2+33

C = 48
F = 0

Exc = 87
Emb = 0

137.5
132.76
0+31

Exc = 70
Emb = 0

136.0
128.17
2+00

C = 67
F = 0

Exc = 46
Emb = 0

C = 191
F = 0

Exc = 0
Emb = 32

108.4
110.62
3+61.05

C = 0
F = 35

Exc = 0
Emb = 112

111.0
116.36
3+18.03

C = 0
F = 109

Exc = 59
Emb = 95

123.1
122.09
2+76.80

C = 75
F = 0

Exc = 45
Emb = 11


124.8
125.36
2+50

C = 15
F = 22


Exc = 8
Emb = 3

NO. 0+71

SEE SHEET

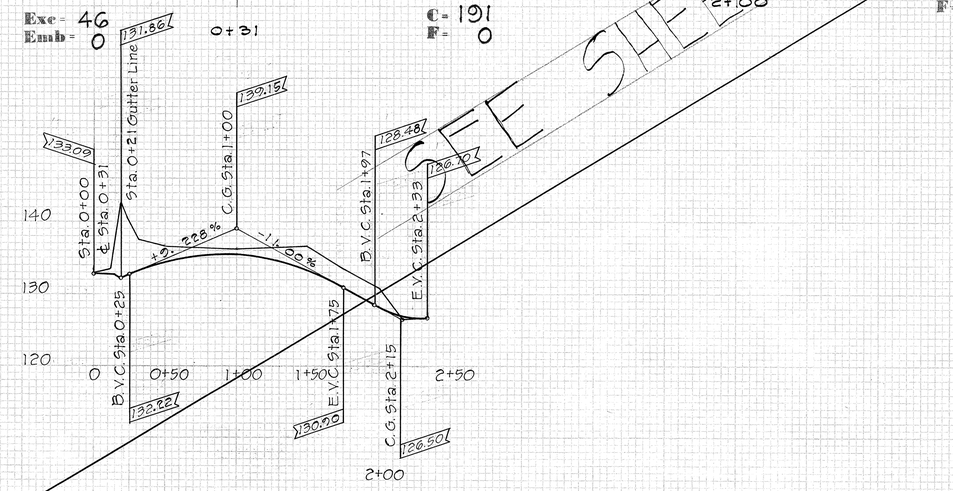

PROFILE
LINE "A"

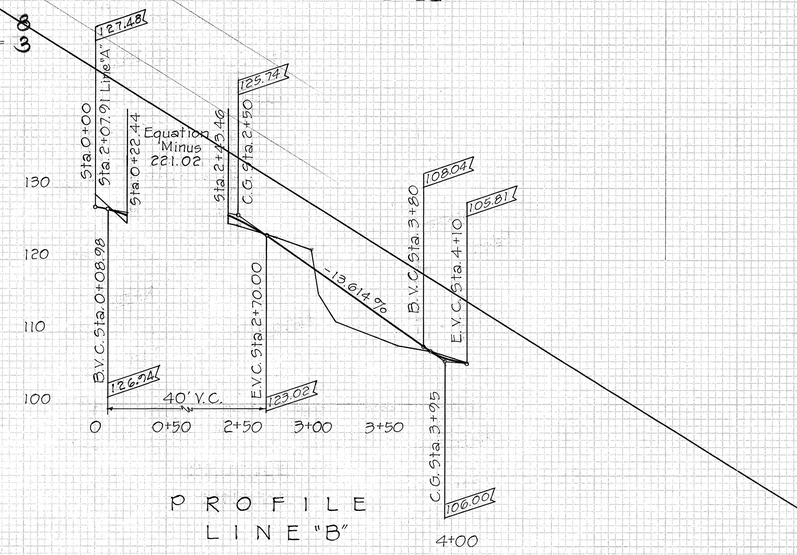


PROFILE
LINE "B"

ACCESS ROAD AT STA. 0+31 LT.


PLATE 3-CROSS SECTION, F.A.S.
CLEARPRINT PAPER CO., S.F. CAL.
NO. 1000N-2

37

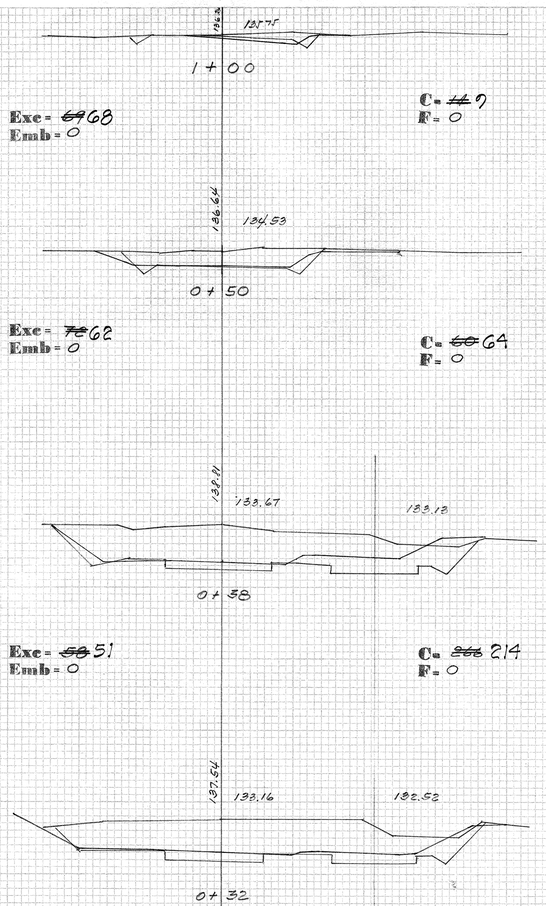


Exc = ~~69~~ 68
Emb = 0

C = ~~11~~ 9
F = 0

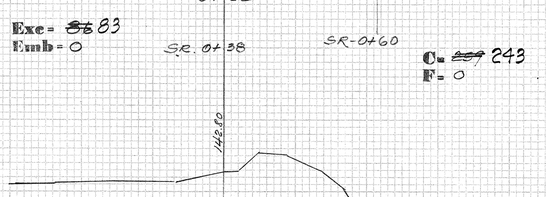

Exc = ~~76~~ 62
Emb = 0

C = ~~60~~ 64
F = 0

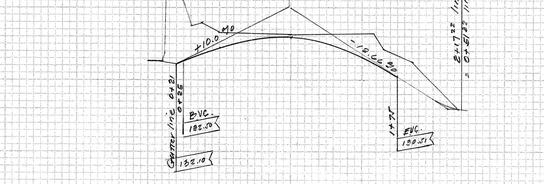

Exc = ~~58~~ 51
Emb = 0


C = ~~256~~ 214
F = 0

Exc = ~~58~~ 83
Emb = 0

SR. 0+38 SR-0+60


C = ~~257~~ 243
F = 0

LINE "A"

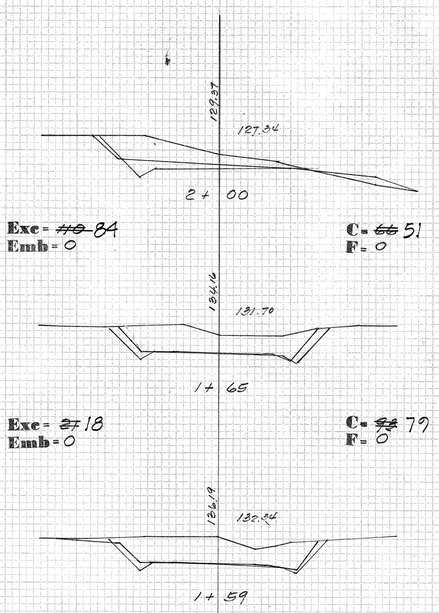

Exc = ~~48~~ 84
Emb = 0

C = ~~66~~ 51
F = 0

 

Exc = ~~27~~ 18
Emb = 0


C = ~~94~~ 79
F = 0

Exc = ~~30~~ 27
Emb = 0

C = ~~95~~ 86
F = 0


Exc = ~~94~~ 77
Emb = 0

C = ~~87~~ 74
F = 0

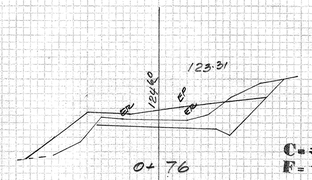


Exc = ~~29~~ 6
Emb = ~~0~~ 15

C = ~~50~~ 10
F = ~~0~~ 40

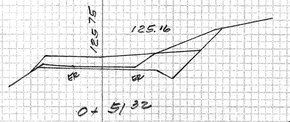


Exc = ~~19~~ 6
Emb = ~~0~~ 9

C = ~~34~~ 12
F = ~~0~~ 17

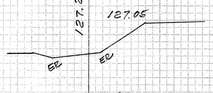


C = 0
F = 0

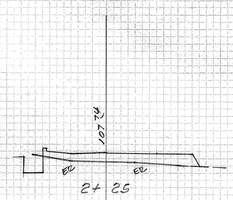


Exc = 0
Emb = ~~11~~ 60

C = 0
F = ~~0~~ 23

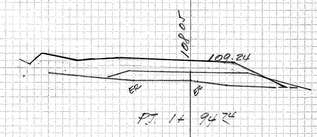


Exc = 1
Emb = ~~25~~ 106

C = 0
F = ~~30~~ 84

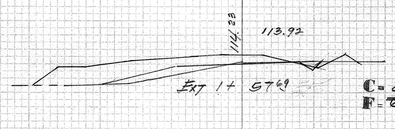


C = 2
F = ~~6~~ 70

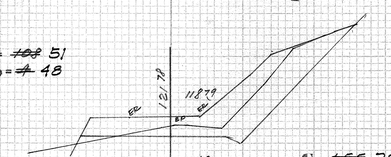

Exc = ~~108~~ 51
Emb = ~~4~~ 48

C = ~~155~~ 72
F = 0

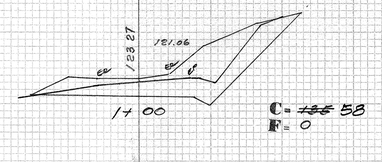

Exc = ~~111~~ 50
Emb = 0

C = ~~135~~ 58
F = 0

Exc = ~~83~~ 30
Emb = ~~0~~ 18

LINE "B"

SIDE ROAD STA 0+38 & 0+60

37 "A"

PLATE 3-CROSS SECTION
CLEARPRINT PAPER CO., S. F. CAL.
NO. 1010H-3

FED. ROAD DIST. No.	STATE	FED. AID PROJ. No.	FISCAL YEAR	SHEET No.	TOTAL SHEETS
HAWAII	HAW.	S-0330(2)	1967	38	47

Exc = ~~19~~ 21
Emb = ~~0~~ 5




C = ~~38~~ 34
F = 0

0+25


Exc = 21
Emb = 0

C = 54
F = 0


0+12

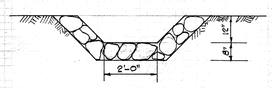

SECTION "A-A"
GRP LINED DITCH
STA. 1+08± to 1+86 ±
Scale: 3/8"=1'-0"

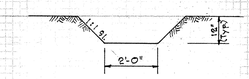

TYPICAL SECTION
UNLINED DITCH
STA. 2+18. to 3+00 RT.
Scale: 3/8"=1'-0"

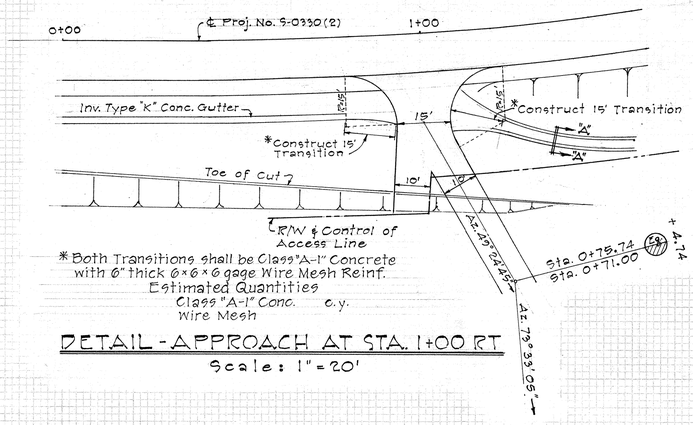


* Both Transitions shall be Class "A-1" Concrete with 6" thick 6×6×6 gage Wire Mesh Reinf.

Estimated Quantities
Class "A-1" Conc. c.y.
Wire Mesh


DETAIL - APPROACH AT STA. 1+00 RT
Scale: 1" = 20'

Exc = ~~12~~ 15
Emb = ~~0~~ 2

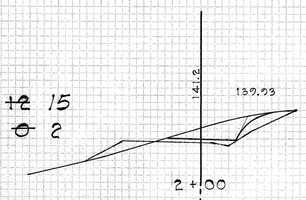


C = ~~18~~ 31
F = ~~0~~ 7

Exc = ~~20~~ 49
Emb = ~~10~~ 20

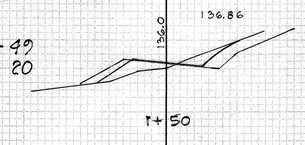


C = ~~4~~ 22
F = ~~11~~ 15

Exc = ~~10~~ 30
Emb = ~~21~~ 31

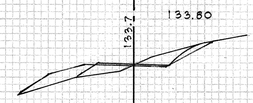


C = ~~7~~ 10
F = ~~12~~ 18

Exc = ~~98~~ 69
Emb = ~~56~~ 81

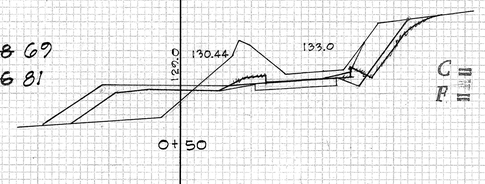


C = ~~90~~ 64
F = ~~49~~ 70

Exc = ~~+~~ 10
Emb = ~~2~~ 9

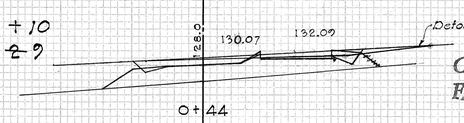

C = ~~0~~ 25
F = ~~15~~ 15


Exc = 2
Emb = 44

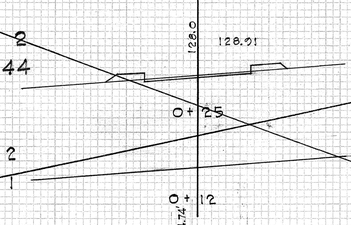

C = 5
F = 9

Exc = 2
Emb = 1


C = 0
F = 0

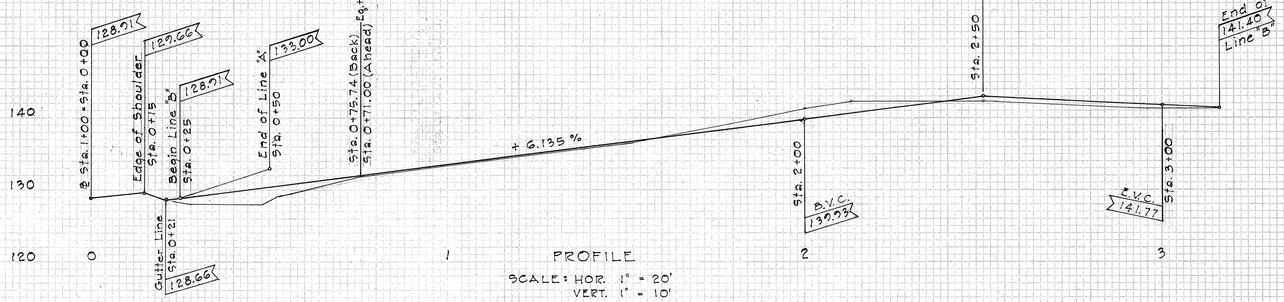


PROFILE
SCALE: HOR. 1" = 20'
VERT. 1" = 10'

SIDE ROAD STA. 1+00 RT.

Exc = ~~0~~ 2
Emb = ~~2~~ 1

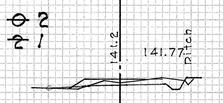


C = ~~0~~ 8
F = ~~6~~ 1

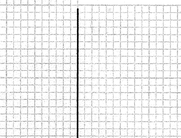


C = 0
F = 0

Exc = ~~0~~ 35
Emb = ~~6~~ 2

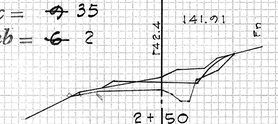

C = ~~+0~~ 30
F = + 1

Exc = ~~20~~ 43
Emb = ~~2~~ 3

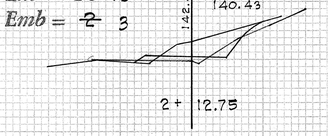

C = ~~30~~ 32
F = ~~2~~ 3


PLATE 2 - CROSS SECTION, F.A.S.
CLEARPRINT PAPER CO., S. F. CAL. NO. 1000N-3

38

FED. ROAD SEC. No.	STATE	FED. AID PROJ. No.	FISCAL YEAR	SHEET No.	TOTAL SHEETS


FINAL SURVEY — NOTE BOOK — NO. — SURVEYED — PLOTTED — PROFILE — AREAS — AREAS CHECKED — BY — DATE

ORIGINAL SURVEY — NOTE BOOK — NO. — SURVEYED — PLOTTED — PROFILE — AREAS — AREAS CHECKED — BY — DATE — 6-28 — 6-30

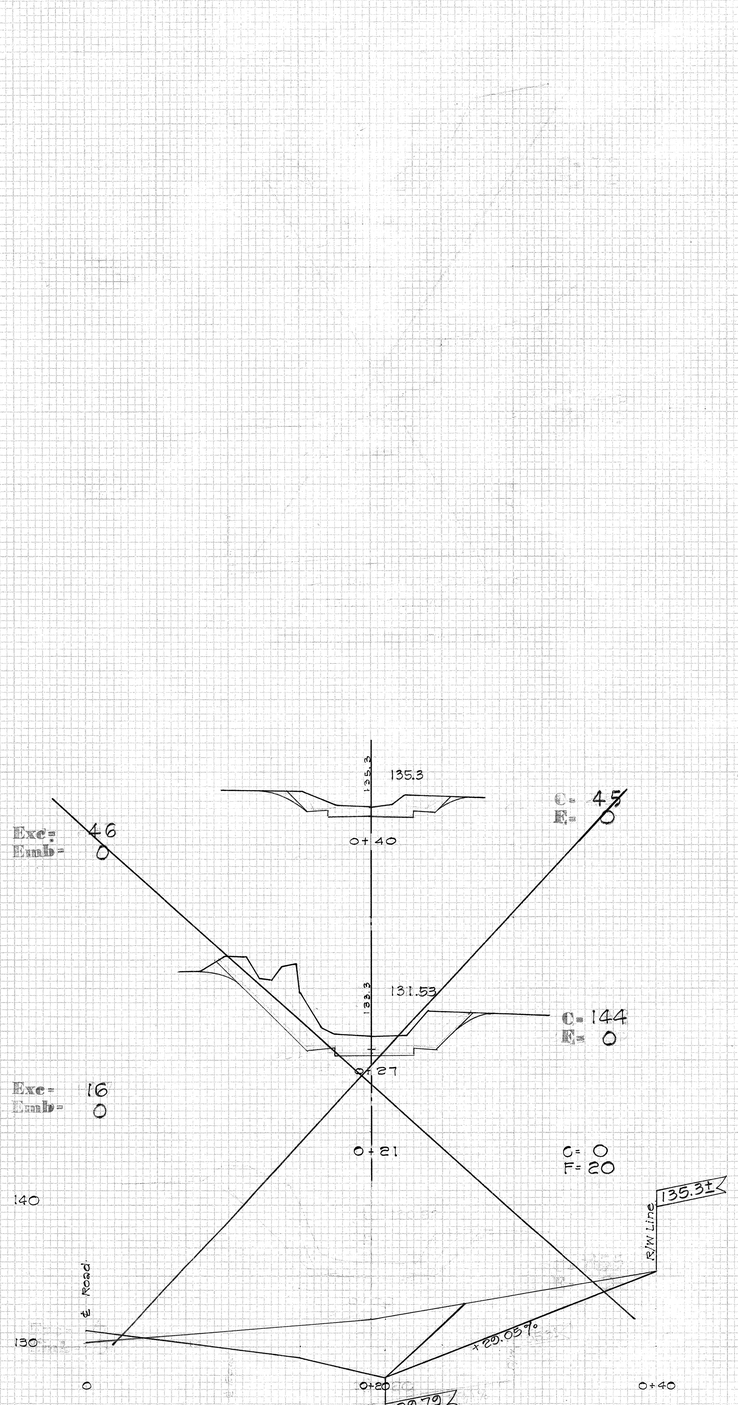

PROFILE OF DRIVEWAY
Scale: Vert. 1"=5'
Horiz. 1"=5'


ACCESS AT STA. 0+60 LT.

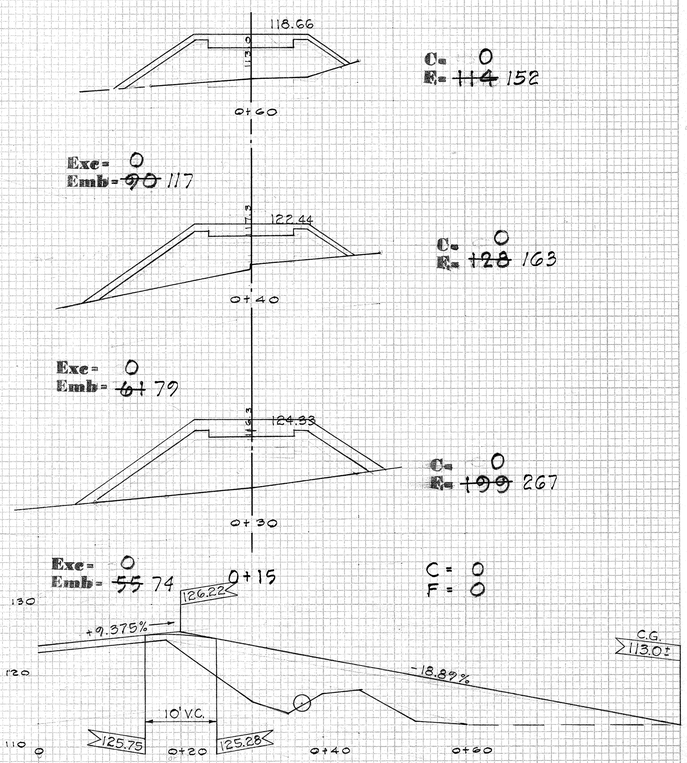



ACCESS AT STA. 2+00 RT.

33 39

FED. ROAD DIST. No.	STATE	FED. AID PROJ. No.	FISCAL YEAR	SHEET No.	TOTAL SHEETS
HAWAII	HAW.	S-0330(2)	1967	40	47

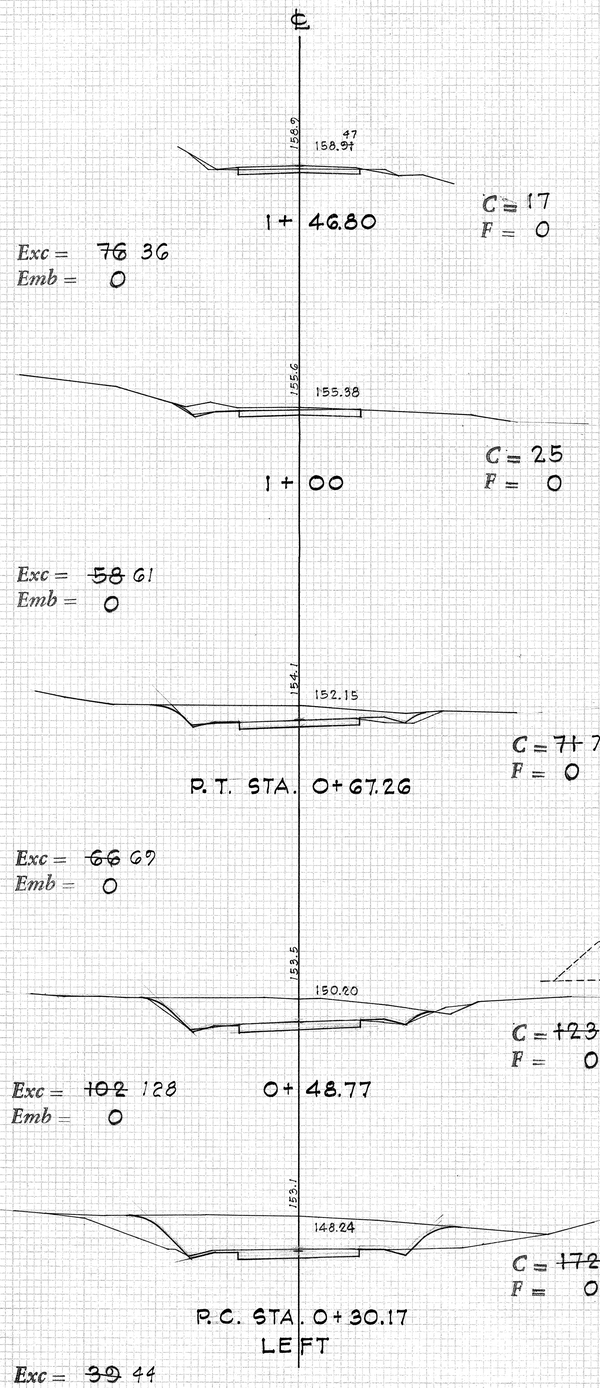

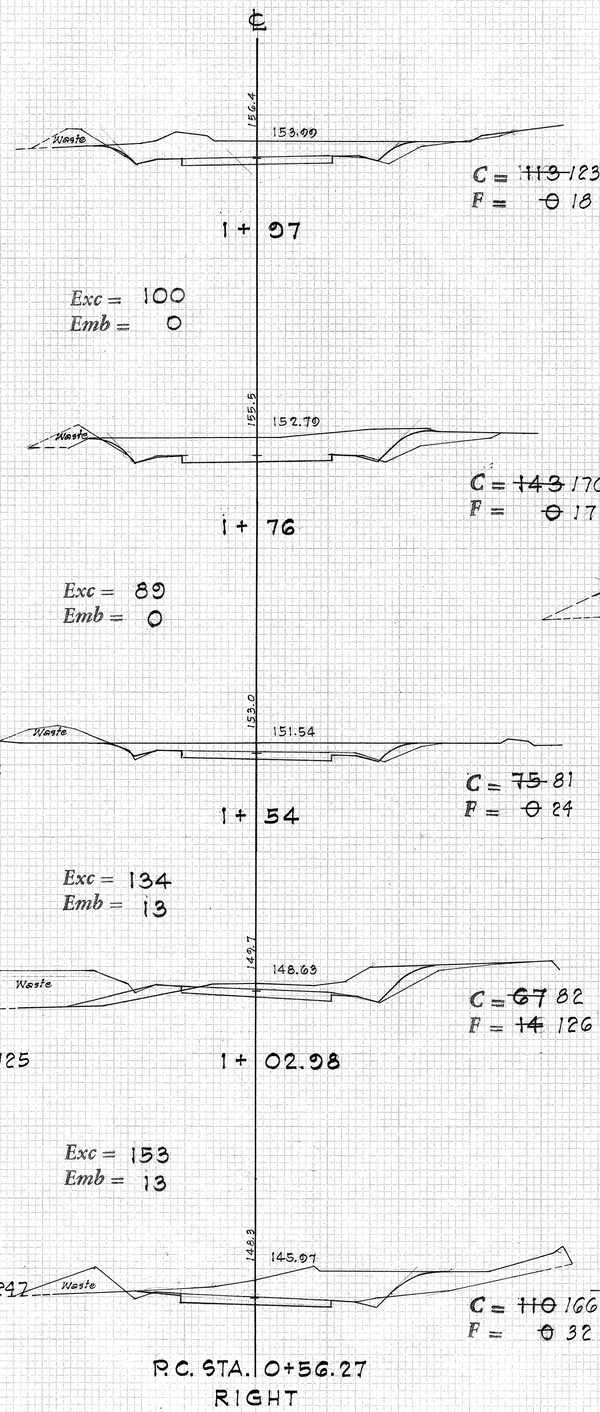

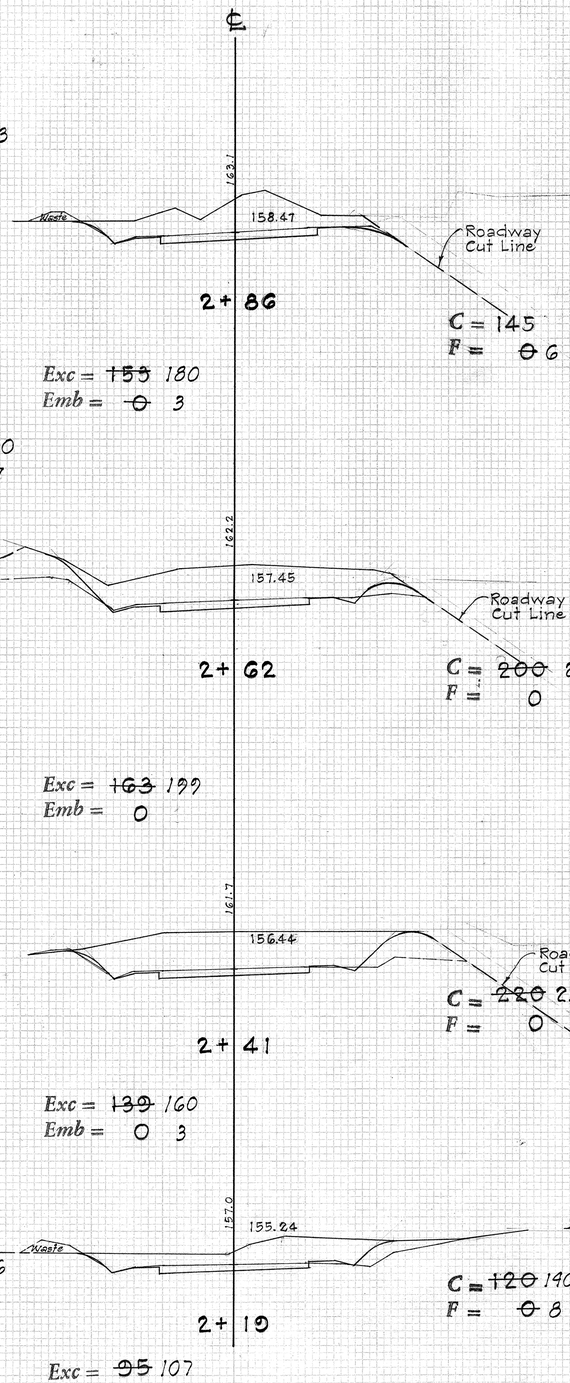

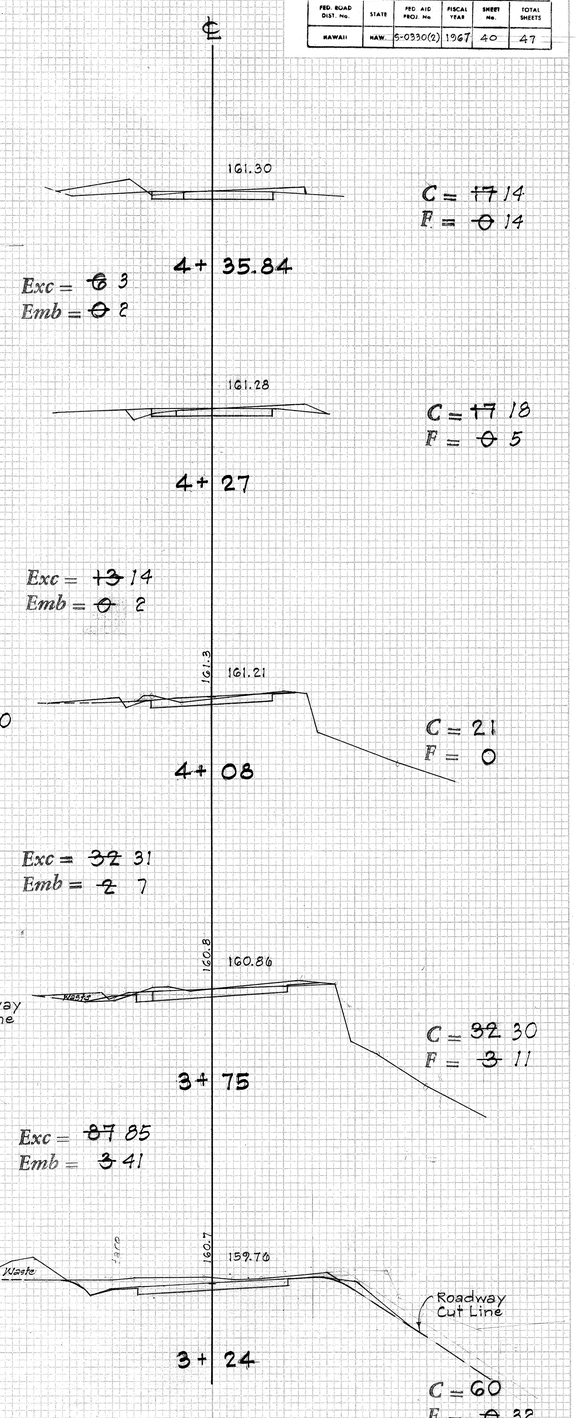


PLATE 3 CROSS SECTION, F.A.S.
CLEARWIRE PAPER CO., S. F. CAL.
NO. 1027N-3