FED. ROAD DIST. NO.	STATE	PROJ. NO.	FISCAL YEAR	SHEET NO.	TOTAL SHEETS
HAWAII	HAW.	340D-01-93M	1993	1	22

INDEX TO DRAWINGS

SHEET NO.	DESCRIPTION
1	TITLE SHEET
2	STANDARD PLANS SUMMARY
3	GENERAL NOTES, LEGEND & SCHEDULE
4	RECONSTRUCTION AREA SCHEDULE AND DETAIL
5	TYPICAL SECTION AND DETAILS
6 – 11	ROADWAY PLANS
12 – 22	SIGNING & PAVEMENT MARKING PLANS

STATE OF HAWAII

DEPARTMENT OF TRANSPORTATION

HIGHWAYS DIVISION

HONOLULU, HAWAII

"AS-BUILT"

PLANS FOR

KAHEKILI HIGHWAY RESURFACING

WAIEHU BEACH ROAD TO CAMP MALUHIA, PAPANAHOA TO HONOKOHAU

PROJECT NO. 340D-01-93M

DISTRICTS OF LAHAINA AND WAILUKU

ISLAND OF MAUI

PROJECT LOCATIONS

PROJECT NO. 340D-01-93M

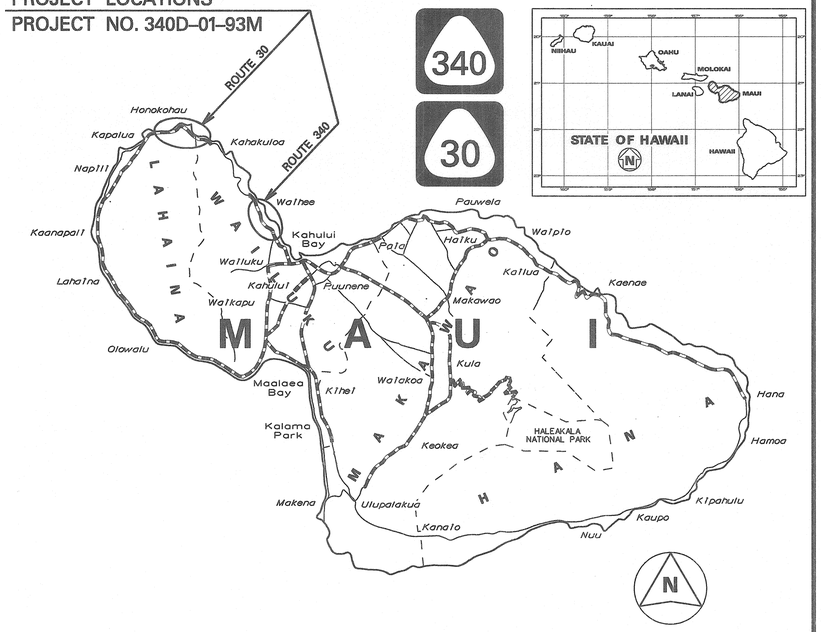

FEDERAL AID PROJECTS PREVIOUSLY CONSTRUCTED OR UNDER CONSTRUCTION

ROUTE 340 MILE POST 2.88 TO MILE POST 6.91

ROUTE 30 MILE POST 22.44 TO MILE POST 18.50

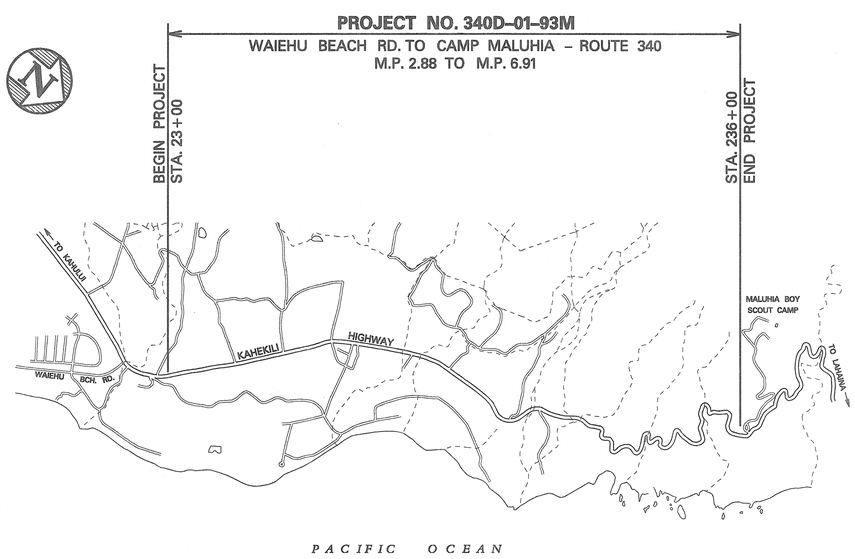

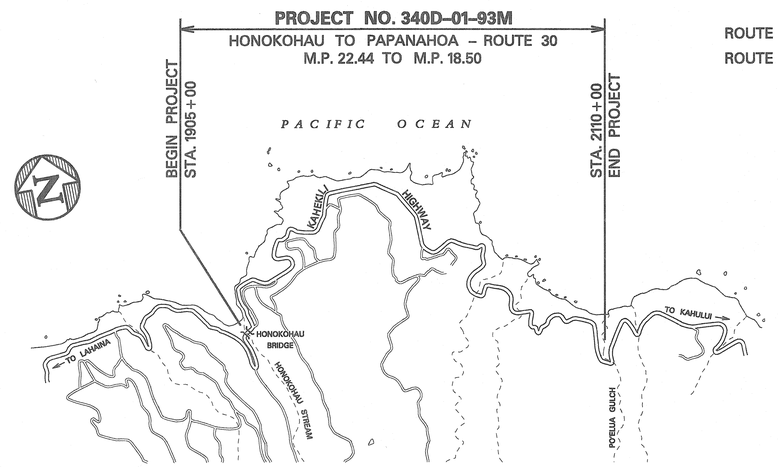

LOCATION PLAN

2 0 2 4 6

SCALE IN THOUSAND FEET

CHANGES MADE DURING CONSTRUCTION HAVE BEEN INCORPORATED ON THESE PLANS EXCEPT CHANGES IN THE ORIGINAL THEORETICAL QUANTITIES. FOR ACTUAL QUANTITIES, REFER TO PROJECT LEDGER AND/OR COMPUTATION BOOK.

FOR RESIDENT ENGINEER 11/5/01 DATE

DEPARTMENT OF TRANSPORTATION
STATE OF HAWAII

APPROVED:

FOR DIR. OF TRANSPORTATION 5/25/93 DATE

DESIGN UNIT "C"	J.KASAMOTO	587-2250	APRIL, 1993
DESIGNED BY	P. S. & E. BY	PHONE	DATE

login: jasop lkbldtsht.dgn 4-21-93