FED. ROAD DIST. NO.	STATE	PROJ. NO.	FISCAL YEAR	SHEET NO.	TOTAL SHEETS
HAWAII	HAW.	340D-01-97	1998	1	5

INDEX TO DRAWINGS	
SHEET NO.	DESCRIPTION
1	TITLE SHEET
2	STANDARD PLANS SUMMARY
3	GENERAL NOTES AND LEGEND
4	PLAN
5	PLAN, PROFILE & DRAINAGE DETAILS

STATE OF HAWAII

DEPARTMENT OF TRANSPORTATION

HIGHWAYS DIVISION

HONOLULU, HAWAII

"AS-BUILT"

PLANS FOR

KAHEKILI HIGHWAY
DRAINAGE AND SAFETY IMPROVEMENTS

VICINITY OF CAMP MALUHIA

PROJECT NO. 340D-01-97

DISTRICT OF WAILUKU

ISLAND OF MAUI

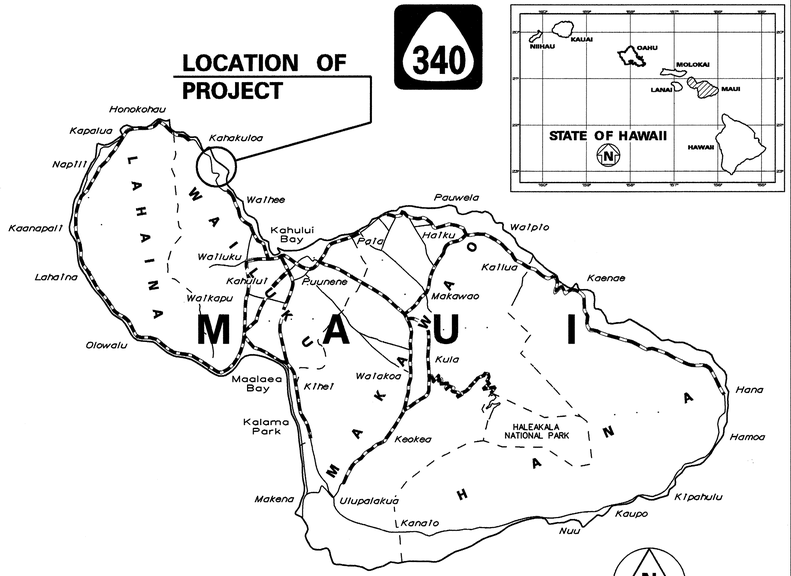

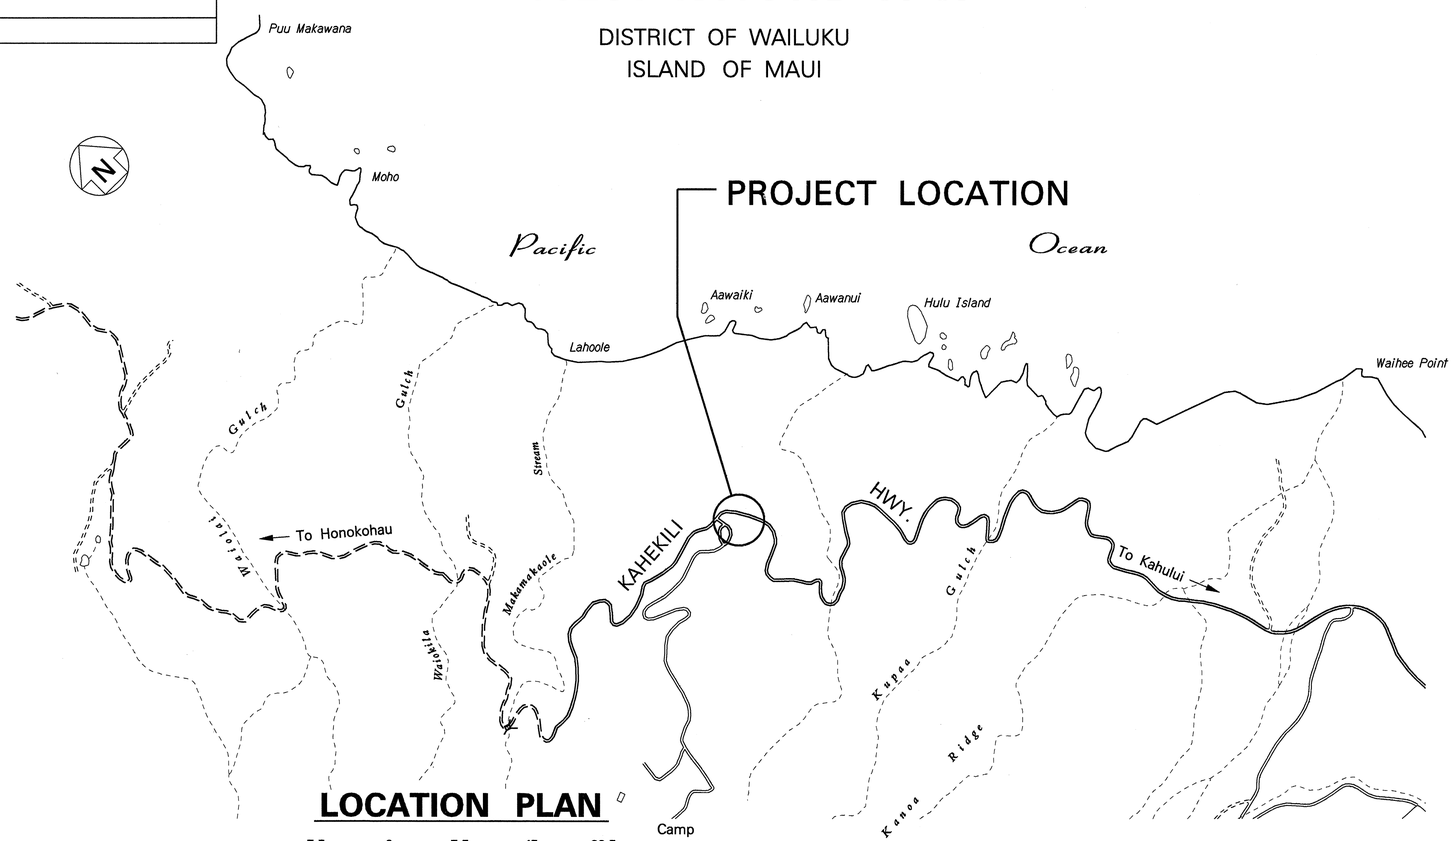

LOCATION PLAN

FEDERAL AID PROJECTS PREVIOUSLY CONSTRUCTED OR UNDER CONSTRUCTION

MILE POST 4.25

CHANGES MADE DURING CONSTRUCTION HAVE BEEN INCORPORATED ON THESE PLANS EXCEPT CHANGES IN THE ORIGINAL THEORETICAL QUANTITIES. FOR ACTUAL QUANTITIES, REFER TO PROJECT LEDGER AND/OR COMPUTATION BOOK.

Michael Hownis — 3-8-2000

RESIDENT ENGINEER — DATE

DEPARTMENT OF TRANSPORTATION STATE OF HAWAII	
APPROVED: Kazu Hayashida	4/30/98
DIR. OF TRANSPORTATION	DATE

HWY-M — DESIGNED BY

R. HIRONAKA — P. S. & E. BY

587-2250 — PHONE

APRIL, 1998 — DATE