FED. ROAD DIST. NO.	STATE	FED. AID PROJ. NO.	FISCAL YEAR	SHEET NO.	TOTAL SHEETS
HAWAII	HAW.	No 58(1)	1945	1	16

INDEX TO DRAWING

SHEET NO.	DESCRIPTION
1	Title Sheet
2	Typical Section
3 - 4	Plan & Profile
5 - 6	Standard Details
7	Standard Bridge Details
8 - 13	Bridge Details
14 - 16	Cross Sections

All changes made during construction have been shown in red on these tracings and checked by

Resident Engineer

Date: 4/16/89

TERRITORY OF HAWAII
TERRITORIAL HIGHWAY DEPARTMENT
HONOLULU, T.H.

PLANS OF
KAWAIPAPA BRIDGE ON HANA BELT ROAD
FEDERAL AID PROJECT NO. F. 58(1)

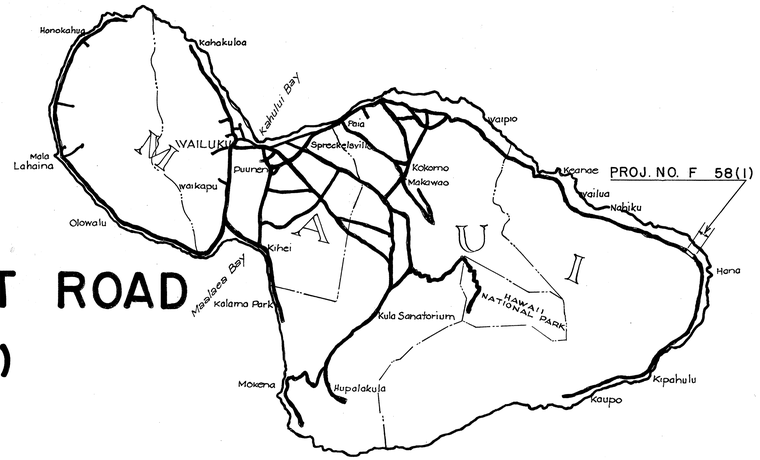

Federal Aid Projects previously constructed or under construction

DISTRICT OF HANA
ISLAND OF MAUI

SCALE

PLAN ..... 1 INCH = 50 FEET

PROFILE ..... (HOR. 1 INCH = 50 FEET
(VER. 1 INCH = 5 FEET

CROSS SECTIONS ..... HOR. 1 INCH = 10 FEET
VER. 1 INCH. = 10 FEET

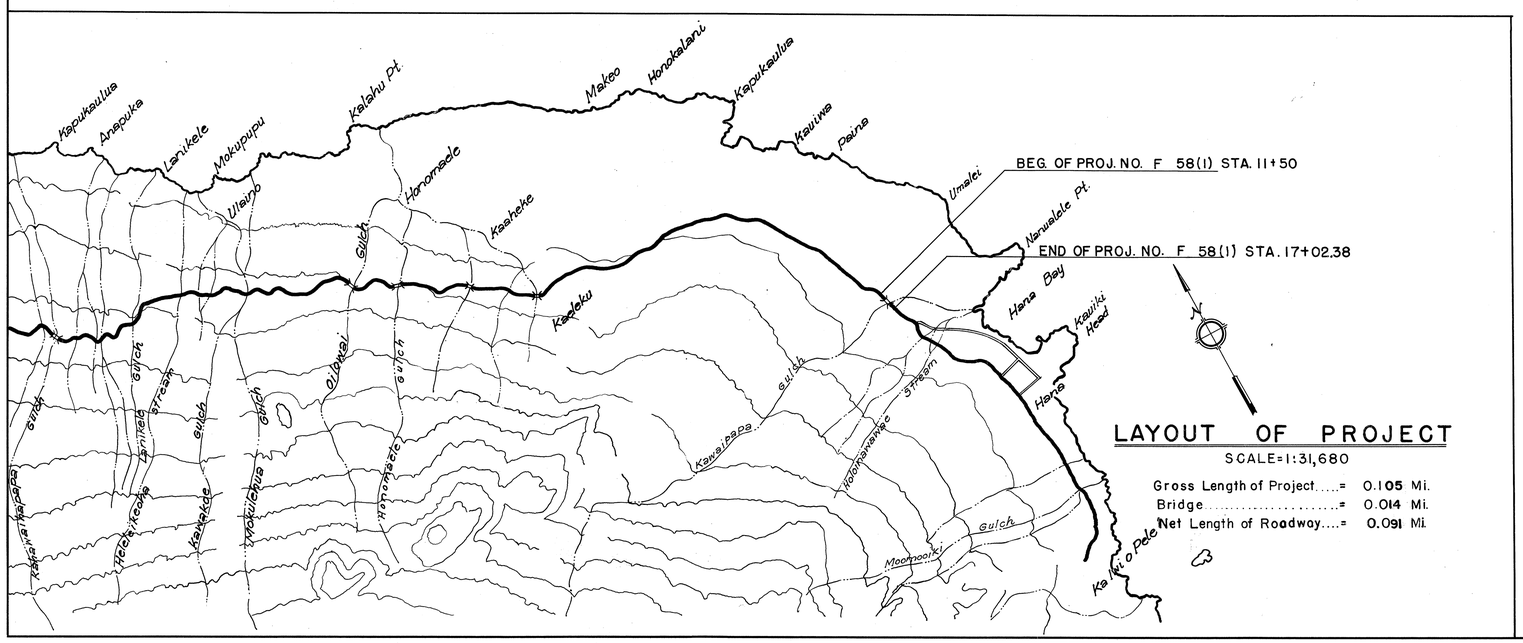

LAYOUT OF PROJECT

SCALE=1:31,680

Gross Length of Project ..... = 0.105 Mi.
Bridge ..... = 0.014 Mi.
Net Length of Roadway .... = 0.091 Mi.

RECOMMENDED FOR APPROVAL:

[redacted]

Principal Highway Engineer
Public Roads Administration
Federal Works Agency

RECOMMENDED FOR APPROVAL:

[redacted]

Chief Western Division
Public Road Administration
Federal Works Agency

APPROVED:

[redacted]

Commissioner
Public Roads Administration
Federal Works Agency

Approved
Date: Nov. 13 1945
By B. F. Rush
Territorial Highway Engineer

ORIGINAL PLAN		DATE
	SURVEY PLOTTED BY	
	TRACED BY	" " "
	DRAWN BY	" " "
	TRACED BY	" " "
	QUANTITIES BY	" " "
	QUANTITIES CHECKED BY	" " "
	CHECKED BY	" " "
NOTE BOOK		
No.		

5184.1

K & E CO., N. Y.
"IMPERIAL" TRACING CLOTH
PRINTED ON