
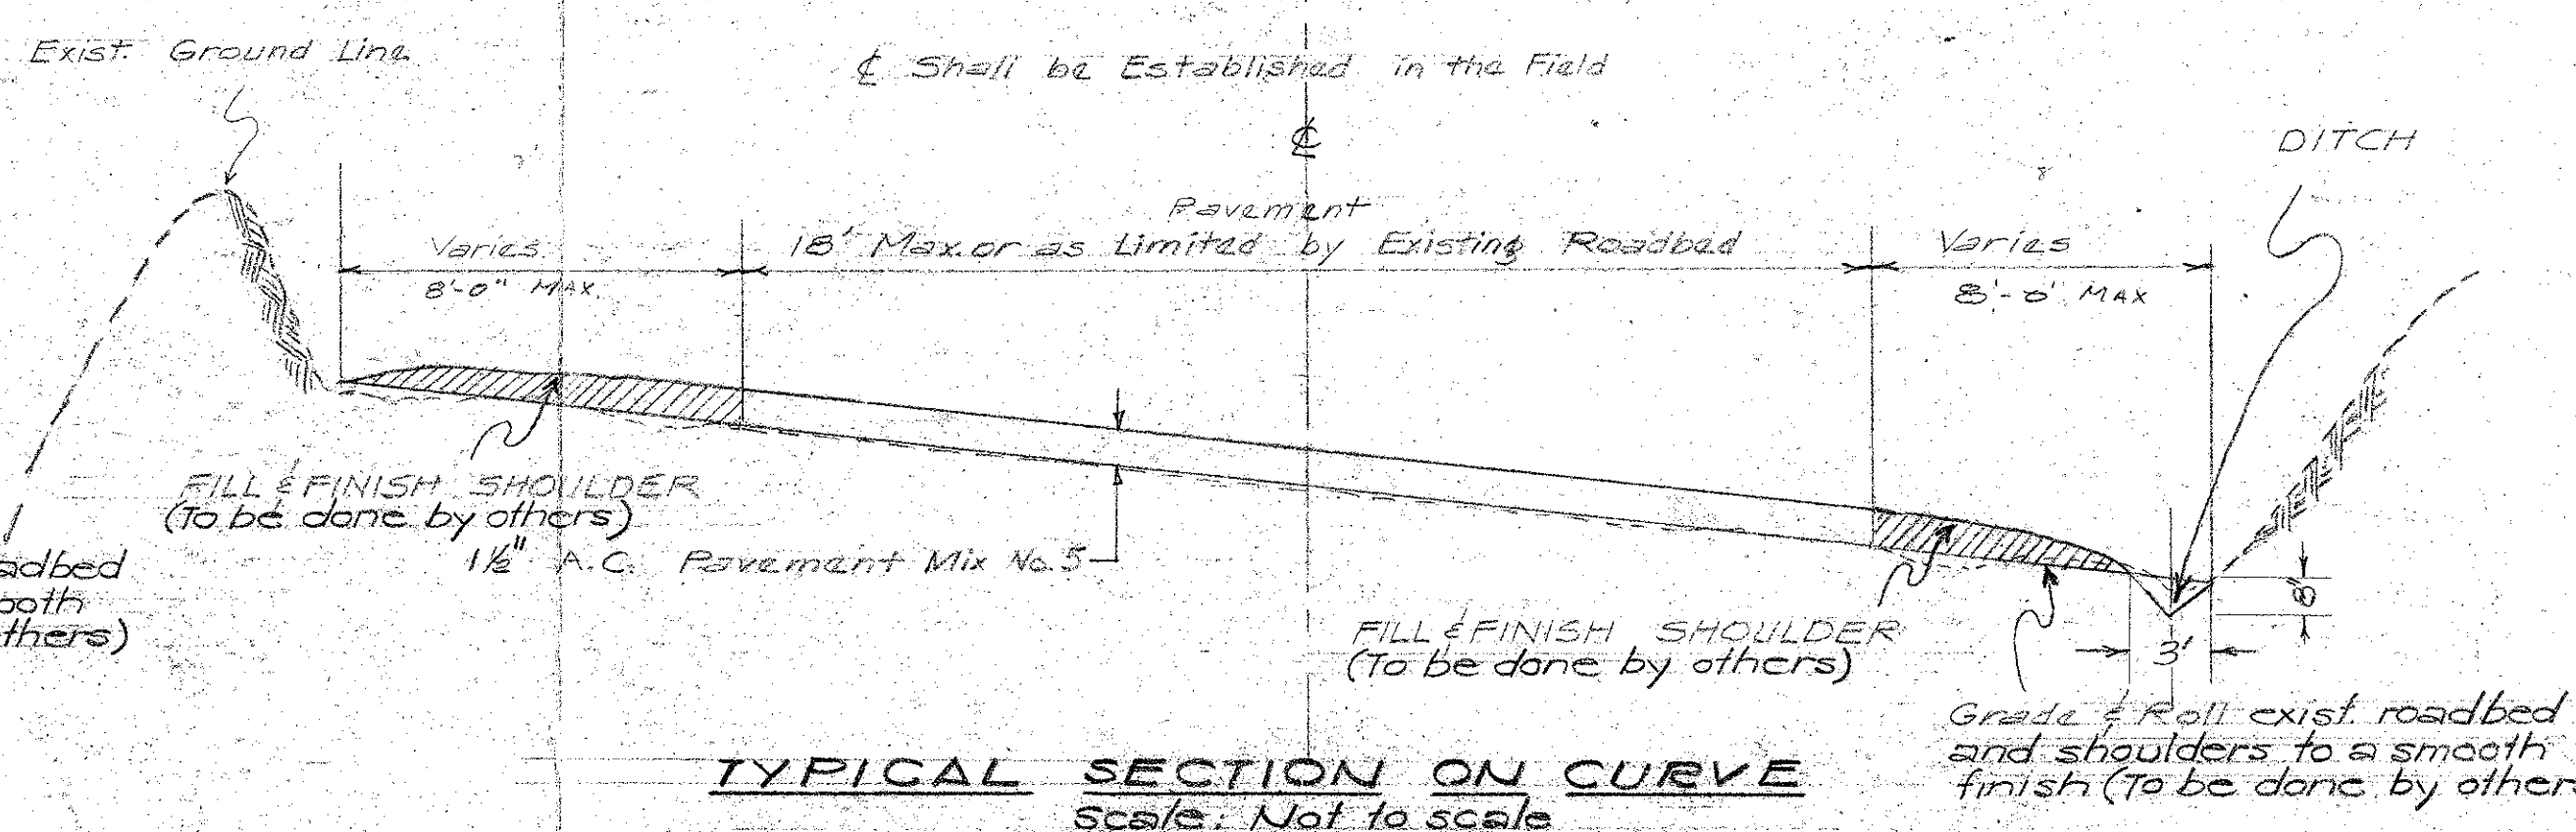
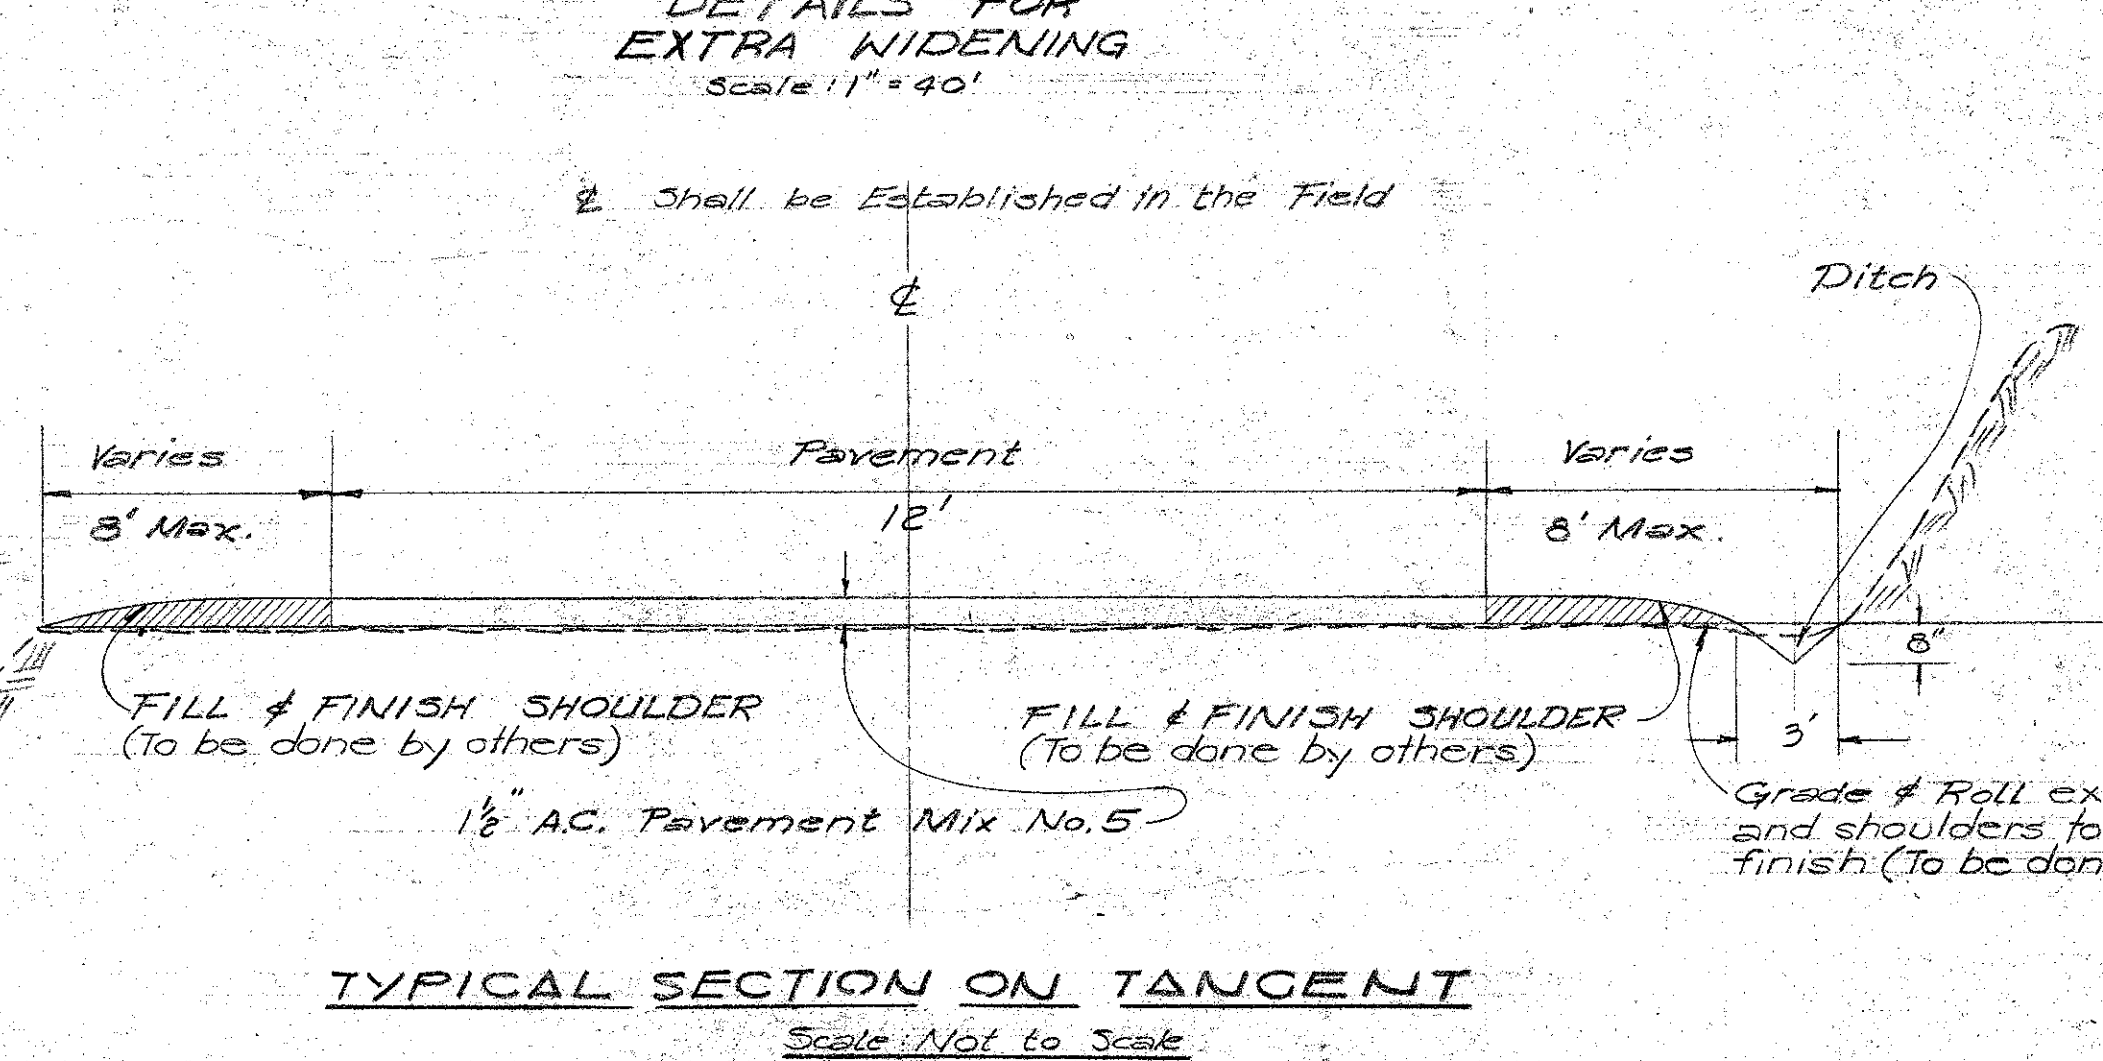
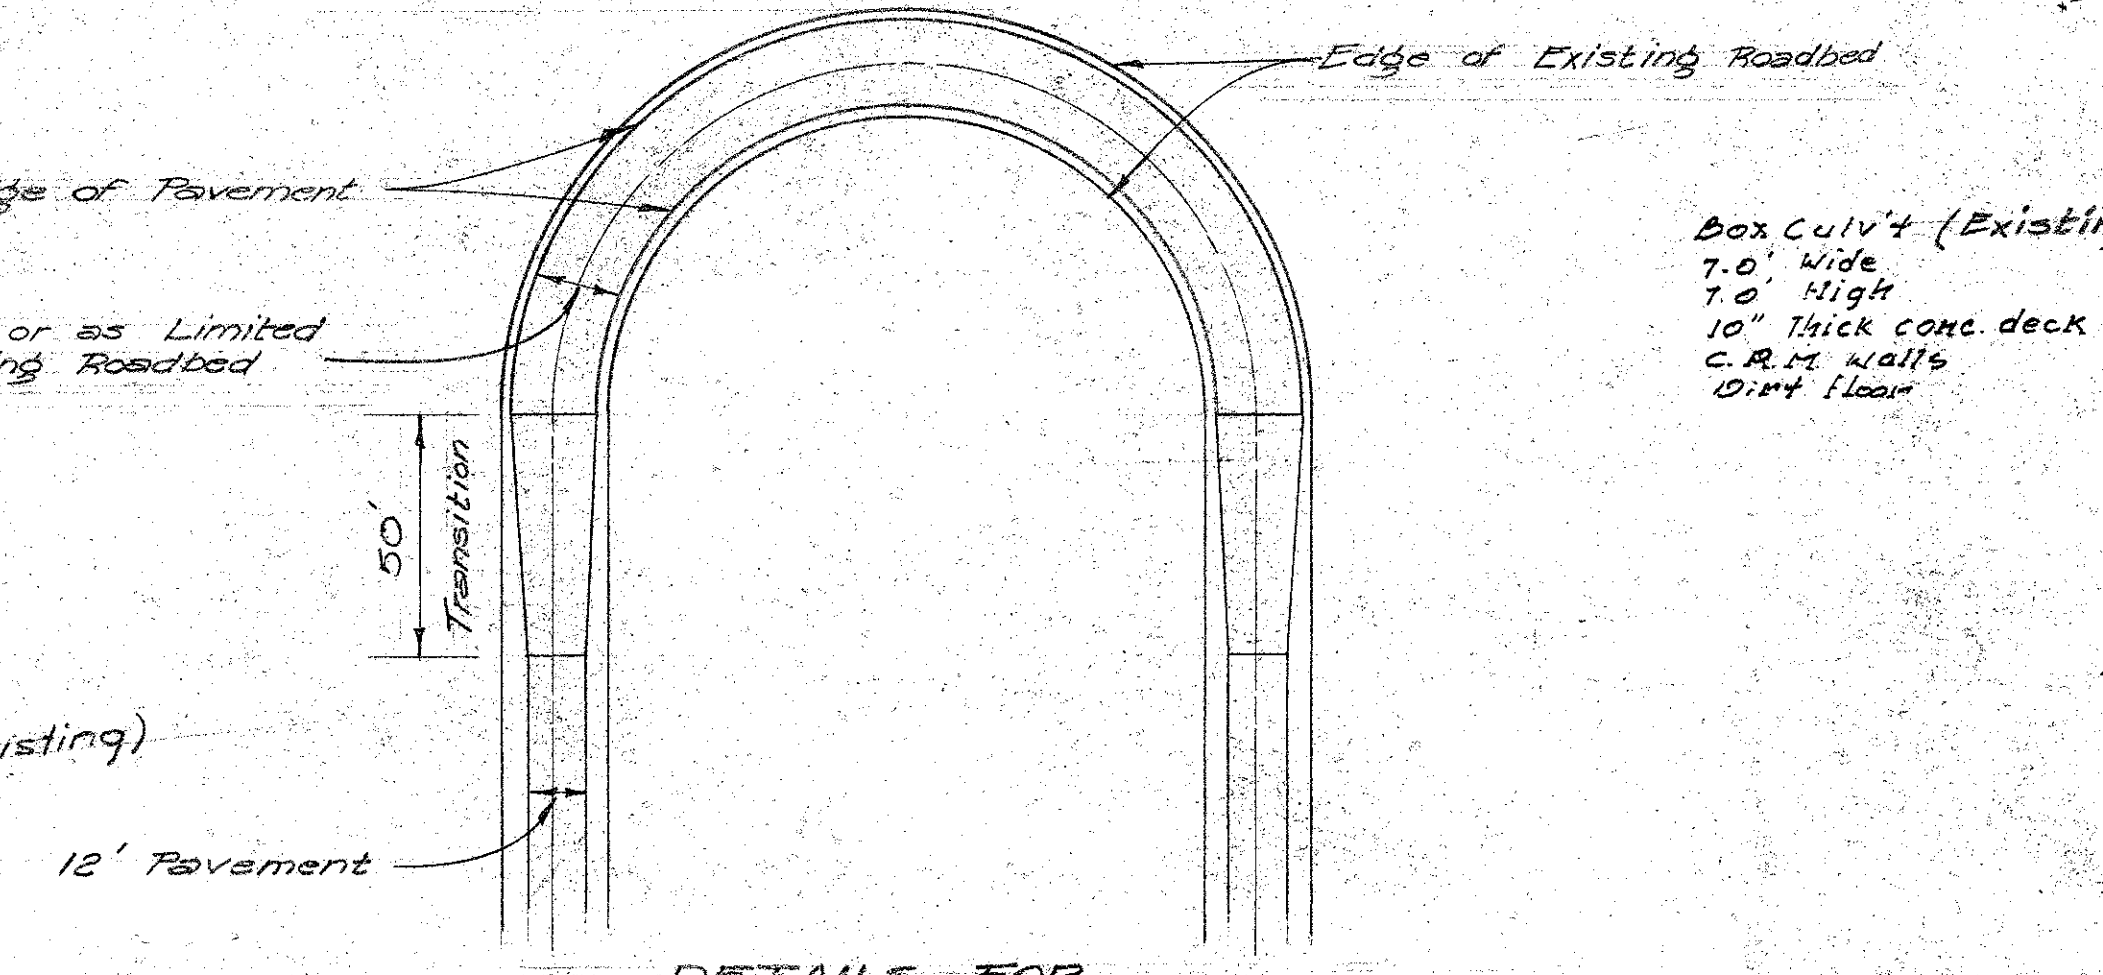
 


NOTE:
Two sets of Stationings are used on these Plans.
1. Stations shown adjacent to the circular symbols connected by solid lines are traverse transit points used for the topographic survey.
2. Stations preceded by the center line symbol (E) are roadway stations established by scaling along the existing road. These stations are shown on the Plans only to help establish locations and estimate quantities.

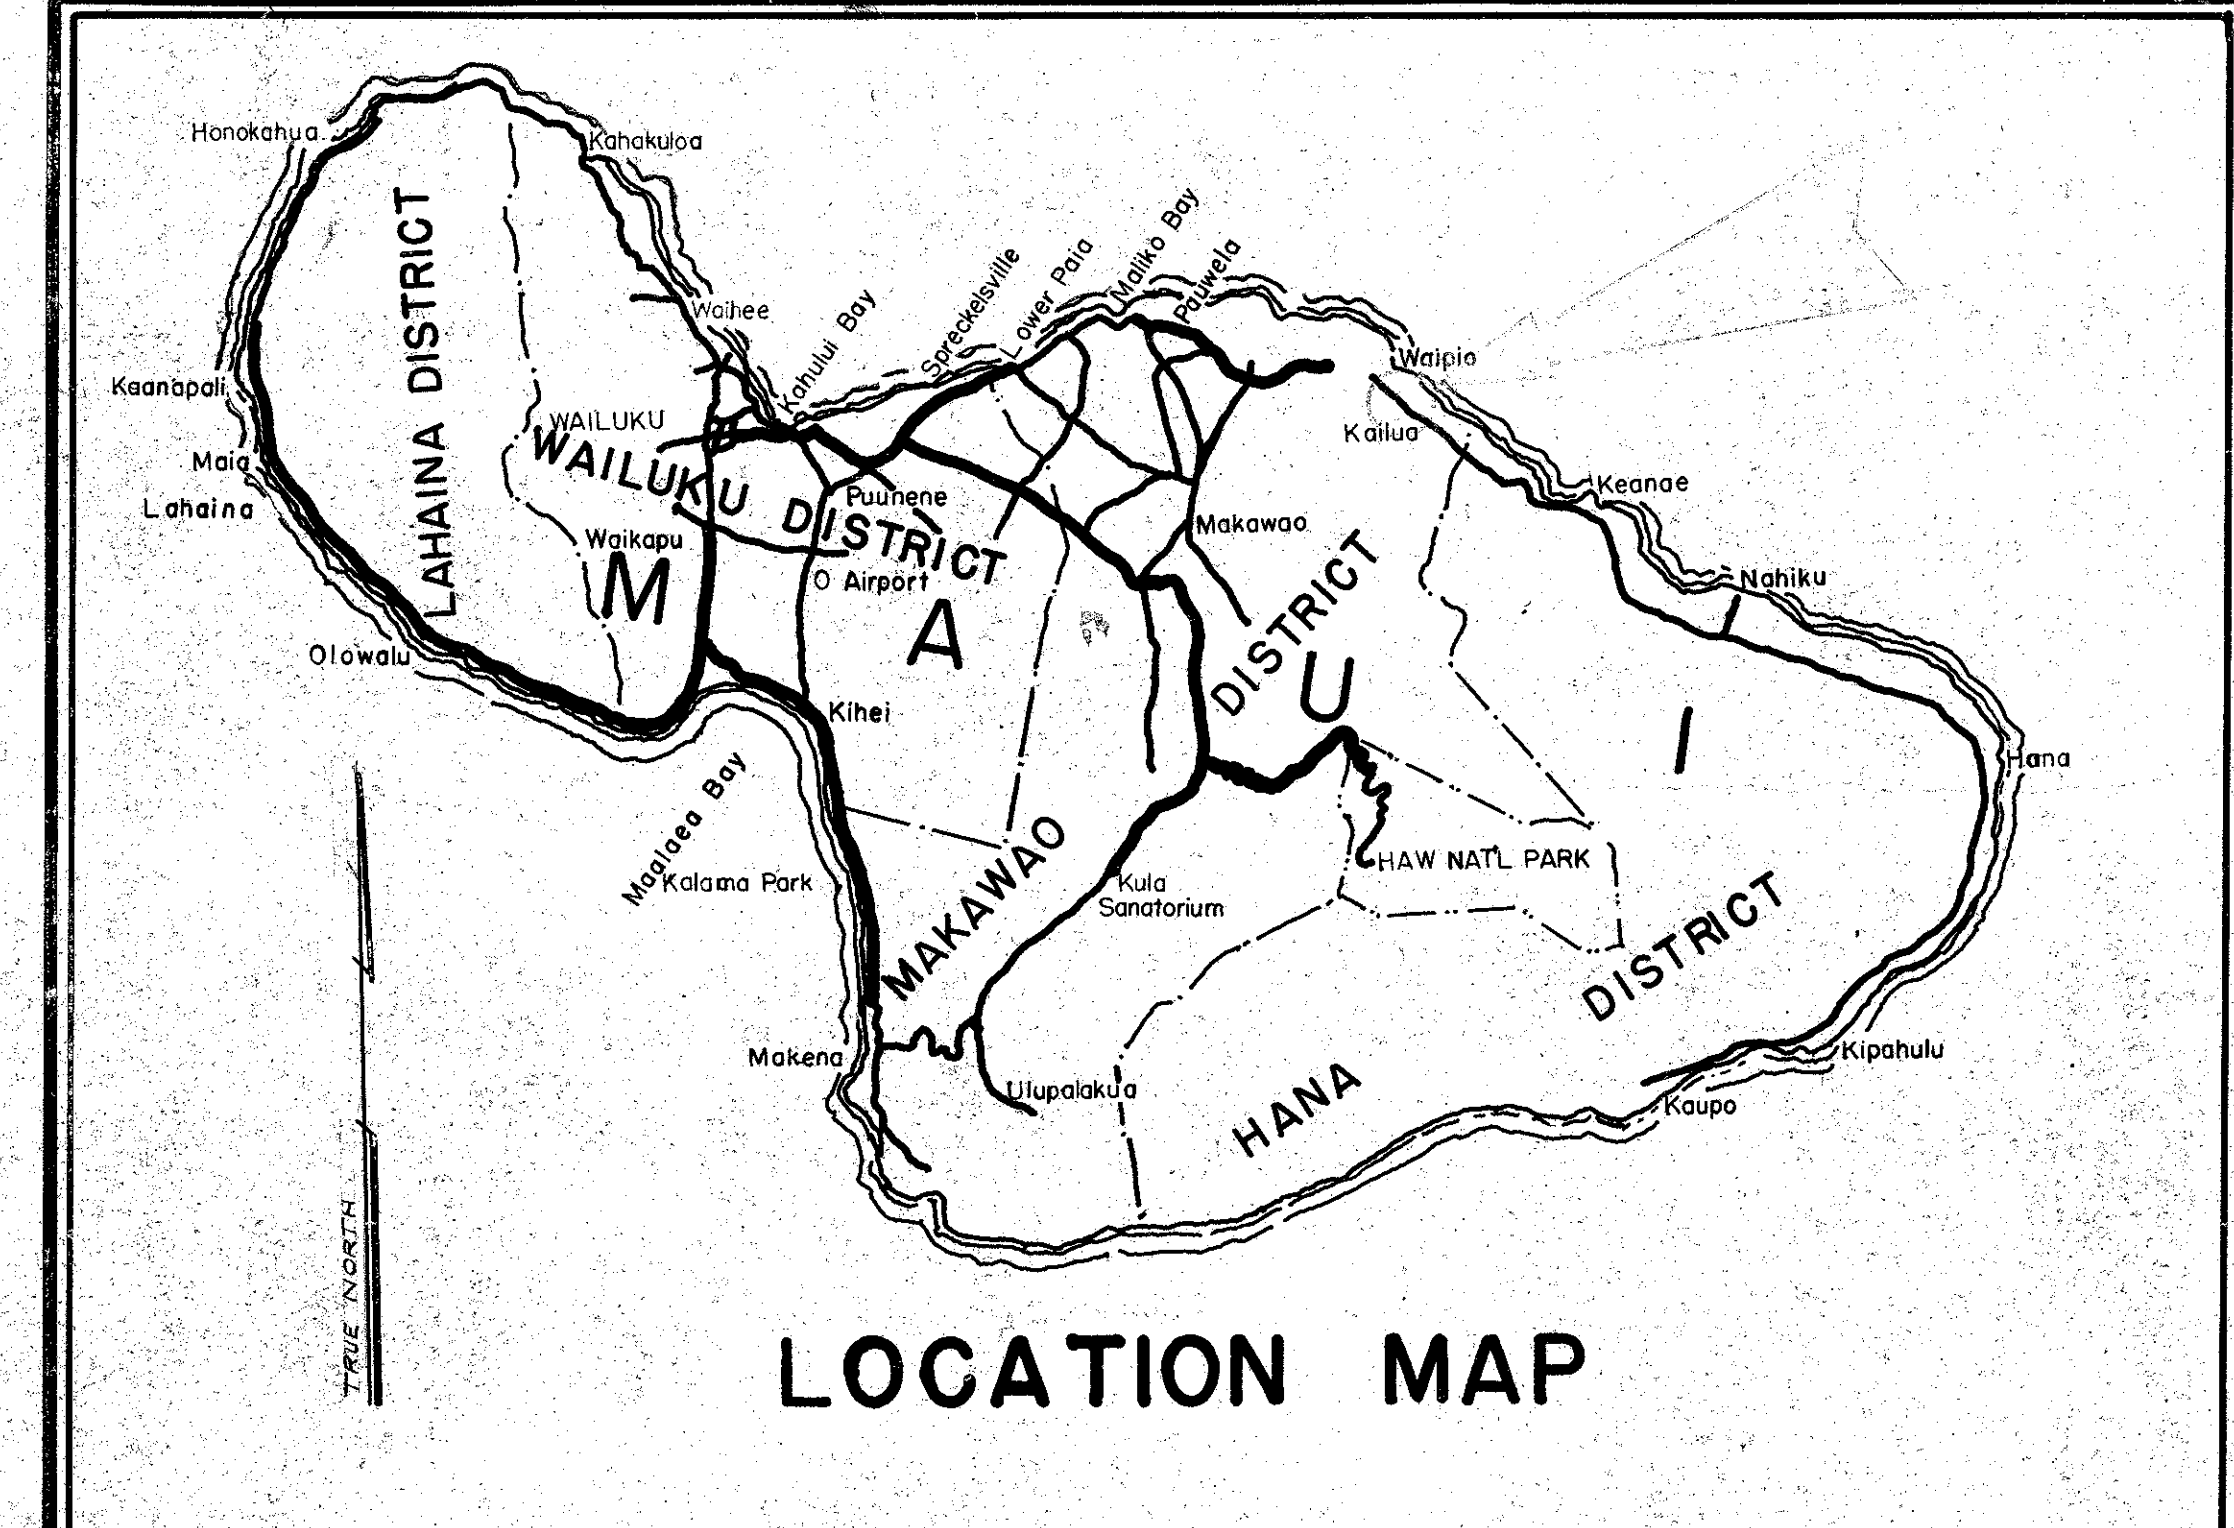

STATE OF HAWAII
DEPARTMENT OF TRANSPORTATION
DIVISION OF HIGHWAYS
HONOLULU, HAWAII

PLANS FOR
THE SURFACING OF A PORTION OF
HANA BELT ROAD DEVELOPMENT
PROJ. NO. A-360-01-59

Authorized By Act 150, S.L. 1957
Section 8, Item 2 (W)

APPROVED DATE DEC. 12, 1960
DIRECTOR OF TRANSPORTATION