FED. ROAD DIST. NO.	STATE	PROJ. NO.	FISCAL YEAR	SHEET NO.	TOTAL SHEETS
HAWAII	HAW.	360AB-01-77	1977	1	24

PROJ. NO. 360AB-01-77

INDEX TO DRAWINGS	
SHEET NO	DESCRIPTION
1	TITLE SHEET
2	GEN. NOTES & TYP. SECT.
3-22	PLAN, PROFILE & DETAILS
23-24	STANDARD DETAILS

STATE OF HAWAII
DEPARTMENT OF TRANSPORTATION
HIGHWAYS DIVISION
HONOLULU, HAWAII

"AS-BUILT" PLANS FOR

HANA BRIDGES - OVERBURDEN REMOVAL

PROJECT NO. 360AB-01-77

DISTRICT OF HANA
ISLAND OF MAUI

SCALES

PLAN		1 IN. = 20 FT.
PROFILE	HOR.	1 IN. = 20 FT.
	VER.	1 IN. = 2 FT.
X-SECTIONS	HOR.	1 IN. = FT.
	VER.	1 IN. = FT.

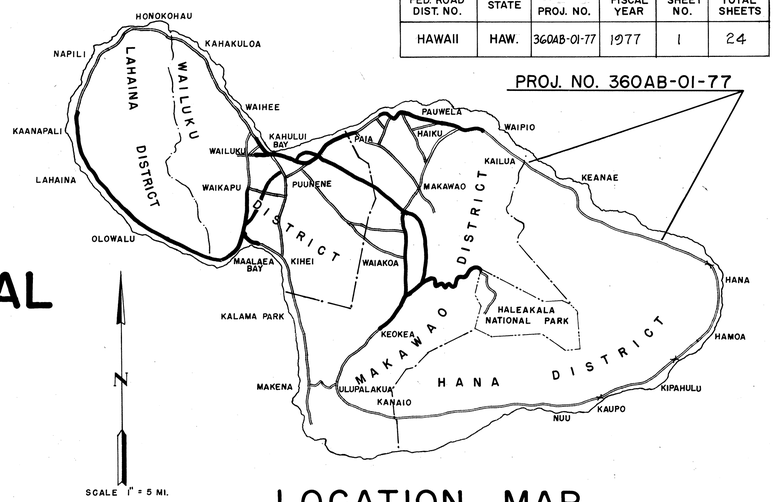

LOCATION MAP

FEDERAL AID PROJECTS PREVIOUSLY CONSTRUCTED OR UNDER CONSTRUCTION

ALL CHANGES MADE DURING CONSTRUCTION
HAVE BEEN NOTED IN RED ON THESE TRACINGS
AND CHECKED BY

Stanley Kato 5/11/78
RESIDENT ENGINEER DATE

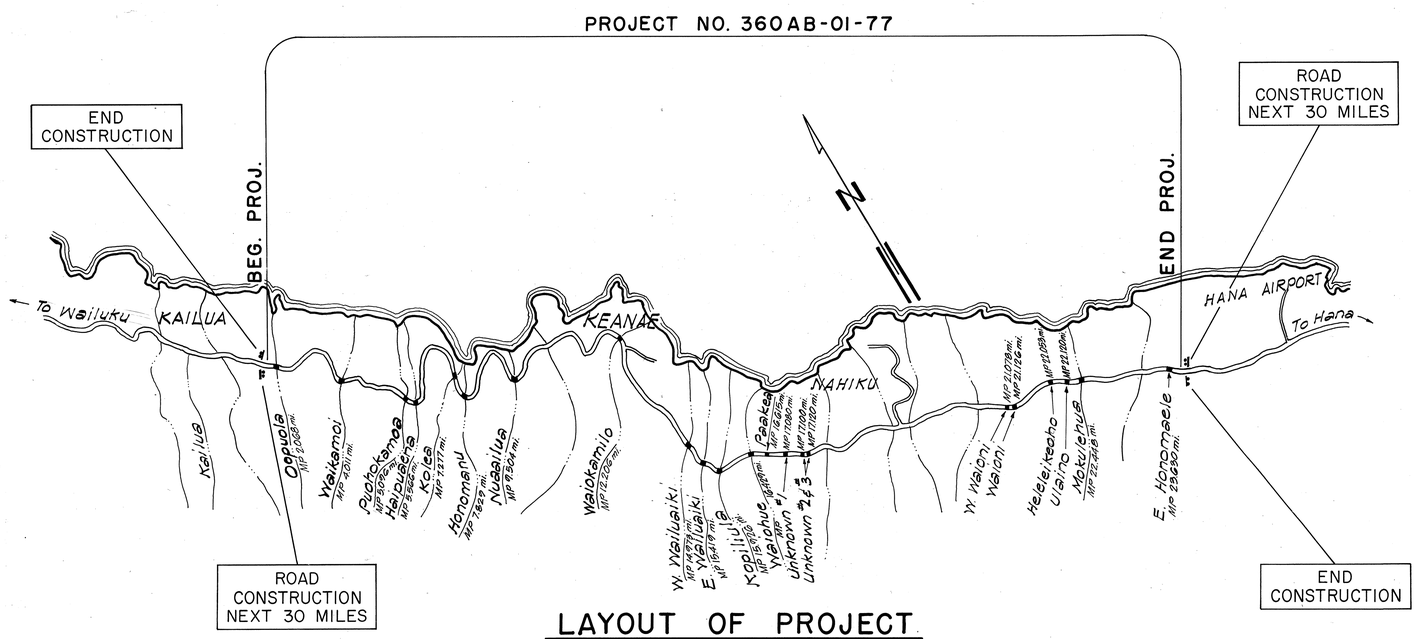

LAYOUT OF PROJECT
SCALE: 1" = 1 MILE

DESIGNED BY: MAUI DISTRICT OFFICE
STATE HWYS. DIVISION
DATE: OCT. 1976

Ronald Tsuzuki 548-2456
P.S.&E. BY: PHONE
Unit B May, 1977
DESIGN UNIT DATE

DEPARTMENT OF TRANSPORTATION
STATE OF HAWAII
APPROVED:
R. Higashionna 5/17/77
for DIR. OF TRANSPORTATION DATE