FED. ROAD DIST. NO.	STATE	PROJ. NO.	FISCAL YEAR	SHEET NO.	TOTAL SHEETS
HAWAII	HAW.	360A-01-80	1980	1	33

INDEX TO DRAWINGS

SHEET NO.	DESCRIPTION
1	TITLE SHEET
2	TYPICAL SECTION
3 - 4	GENERAL NOTES & SCHEDULES
5 - 6	PLAN
7 - 8	DETAIL PLANS
9 - 14	STANDARD GUARDRAIL DETAILS
15 - 19	DRAINAGE PLANS & DETAILS
20 - 22	CONCRETE CULVERT EXTENSION PLANS
23 - 33	TRAFFIC SIGNS & PAVEMENT MARKINGS PLANS & DETAILS

STATE OF HAWAII

DEPARTMENT OF TRANSPORTATION

HIGHWAYS DIVISION

HONOLULU, HAWAII

"AS-BUILT" PLANS

HANA HIGHWAY IMPROVEMENTS

HUELO TOWARDS WAILUA, PHASE I

PROJECT NO. 360A-01-80

DISTRICT OF HANA

ISLAND OF MAUI

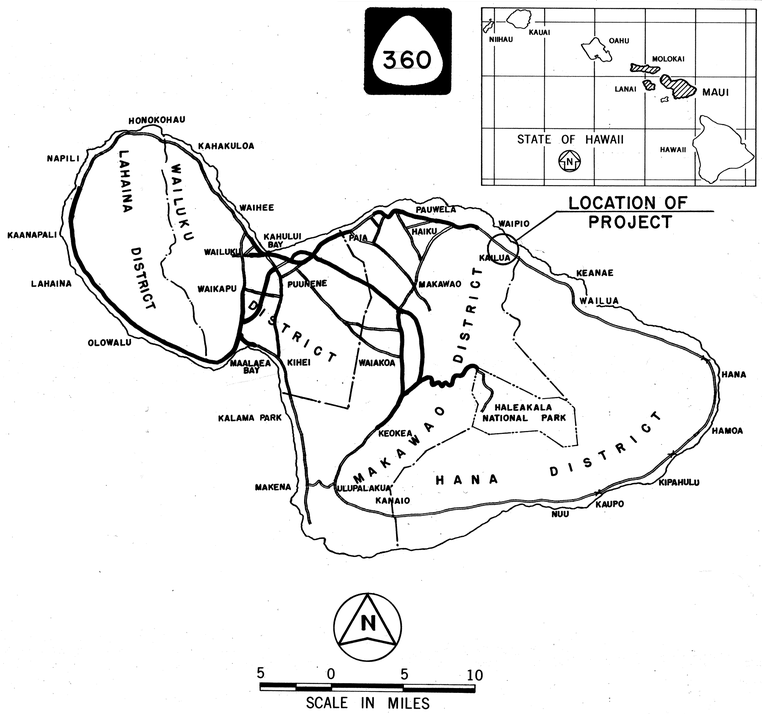

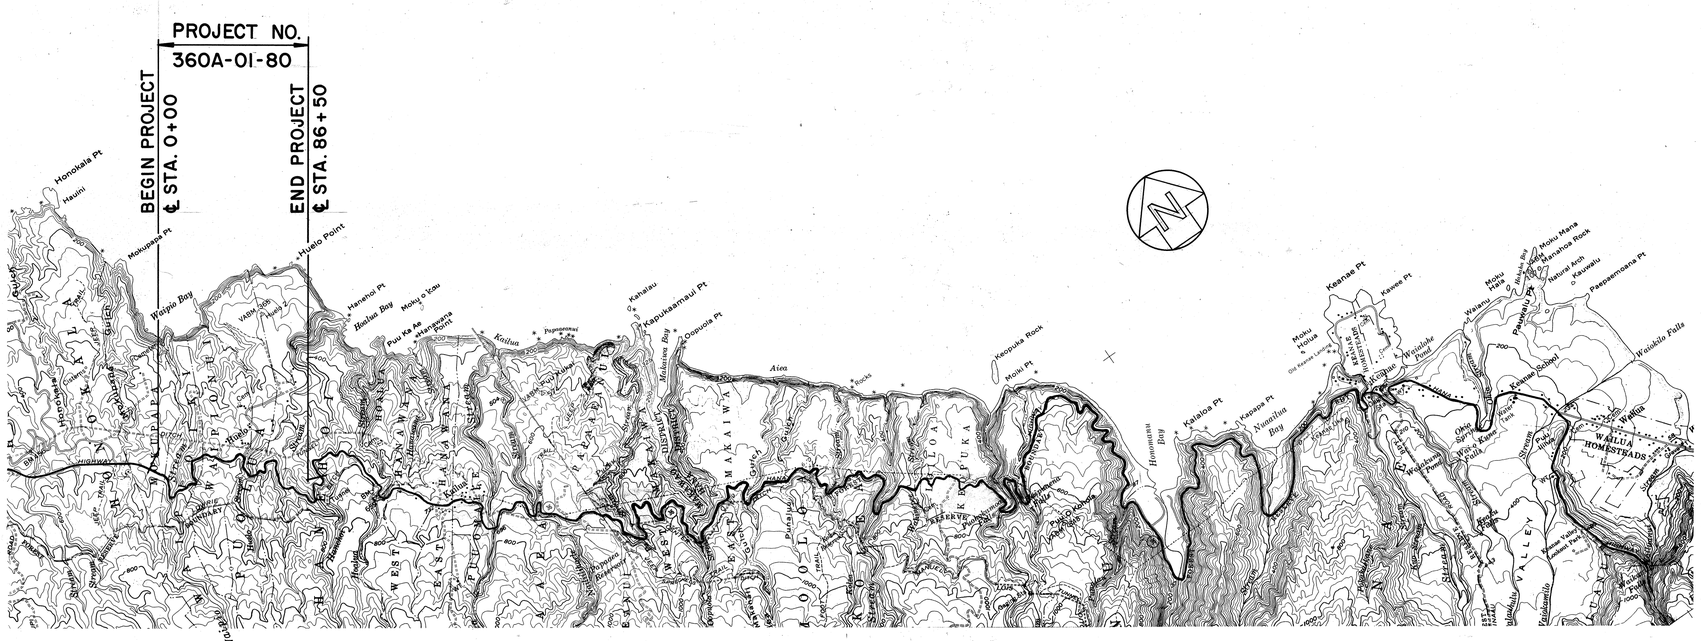
PROJECT NO.
360A-01-80
BEGIN PROJECT
℄ STA. 0+00
END PROJECT
℄ STA. 86+50
Honokalo Pt
Hauiki
Mokupapa Pt
Huelo Point
Waipio Bay
Haneoi Pt
Hualani Bay
Moku o Loa
Puu Ka Ae
Kaulua
Kahalau
Kapukaamauli Pt
Oopuola Pt
Aiea
Molii Pt
Kalalua Pt
Kapaa Pt
Nuualiu Bay
Honomanu Bay
Keanae Pt
Kawee Pt
Moku Hina
Waianu
Waianiha Point
Waianiha Falls
Moku Mana
Kaaratua Rock
Natural Arch
Kawaiu
Paapaemoana Pt
WAILUA HOMESTEADS
