FED. ROAD DIST. NO.	STATE	PROJ. NO.	FISCAL YEAR	SHEET NO.	TOTAL SHEETS
HAWAII	HAW.	360AB-01-09	2014	ADD. 35	47

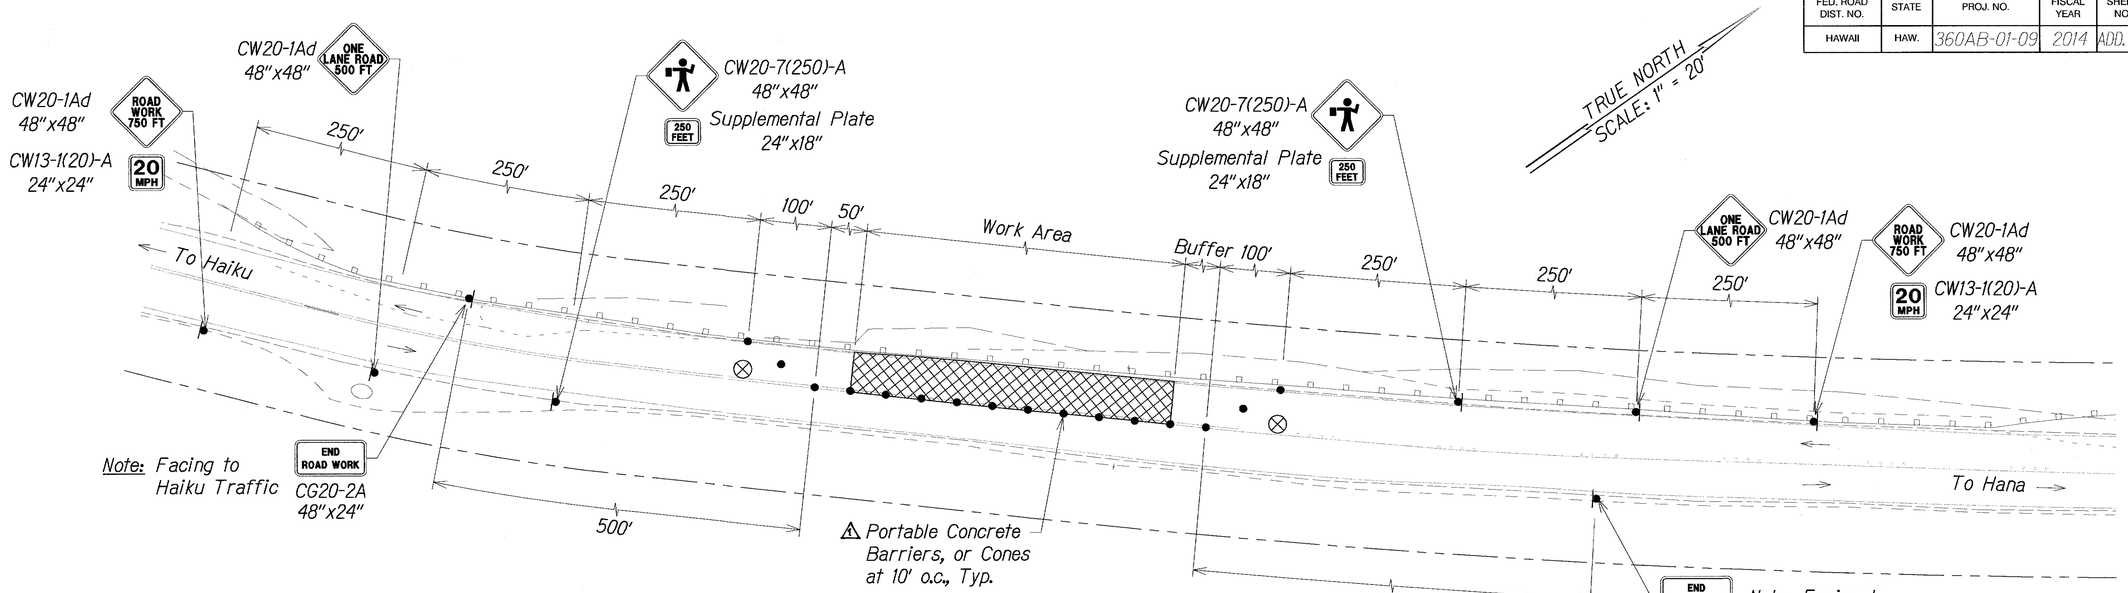

TYPICAL TRAFFIC CONTROL PLAN FOR WORK ON HAIKU BOUND LANE

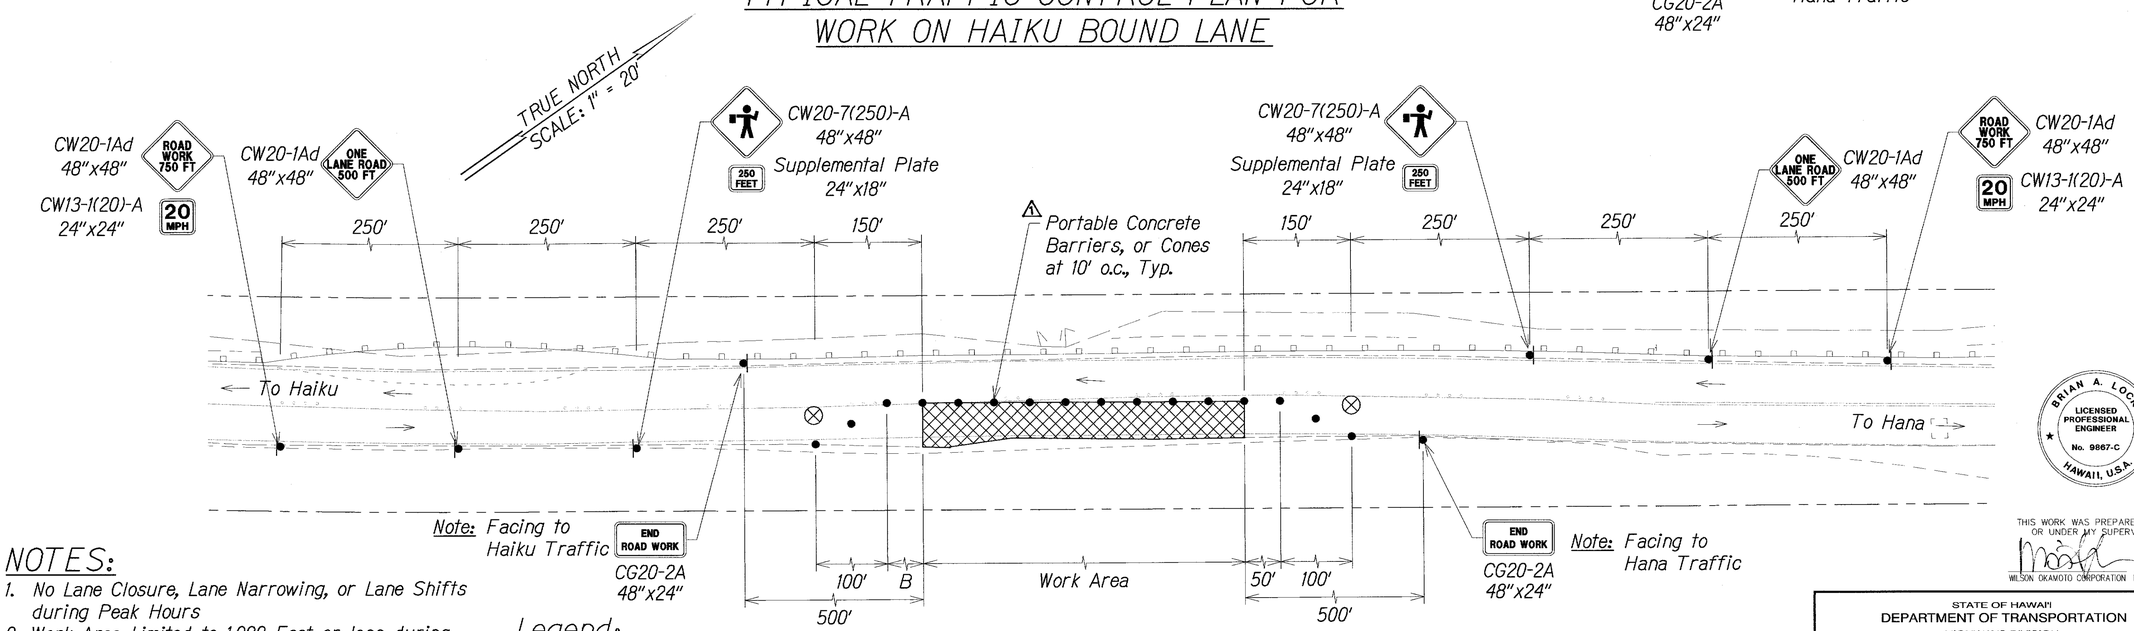

TYPICAL TRAFFIC CONTROL PLAN FOR WORK ON HANA BOUND LANE

NOTES:

1. No Lane Closure, Lane Narrowing, or Lane Shifts during Peak Hours
2. Work Area Limited to 1,000 Feet or less during working hours
3. Place Signs on Makai Side of Road if no Room on Mauka Side
4. Install Advisory Signs According to Section 645 - Work Zone Traffic Control, a Minimum of 500 Feet Before and After the Extents of the Traffic Control.
5. For Portable Concrete Barrier Details See Standard Plans TE-42, TE-42, and Sht. GRD-11

Legend:

- Work Area
- Police Officer
- Cones and Delineators
- Sign
- Direction of Traffic

	DATE	REVISION
1	r6/10/14	REVISED NOTES AND CALLOUTS

BRIAN A. LOCK
LICENSED PROFESSIONAL ENGINEER
No. 9867-C
HAWAII, U.S.A.

THIS WORK WAS PREPARED BY ME OR UNDER MY SUPERVISION.
APRIL 30, 2016
WILSON OKAMOTO CORPORATION LIC. EXP. DATE

STATE OF HAWAII
DEPARTMENT OF TRANSPORTATION
HIGHWAYS DIVISION

TRAFFIC CONTROL PLANS

HANA HIGHWAY
IMPROVEMENTS, PHASE 2A
Huelo to Hana
Project No. 360AB-01-09

Scale: 1" = 20' Date: April 2014

SHEET No. TCP-1 OF 1 SHEETS

ORIGINAL PLAN	SURVEY PLOTTED BY	DATE
	DRAWN BY	
NOTE BOOK	TRACED BY	
	DESIGNED BY	
No.	QUANTITIES BY	
	CHECKED BY	

ADD. 35