


FED. ROAD DIST. NO.	STATE	PROJ. NO.	FISCAL YEAR	SHEET NO.	TOTAL SHEETS
HAWAII	HAW.	377A-02-81M	1981	5	15

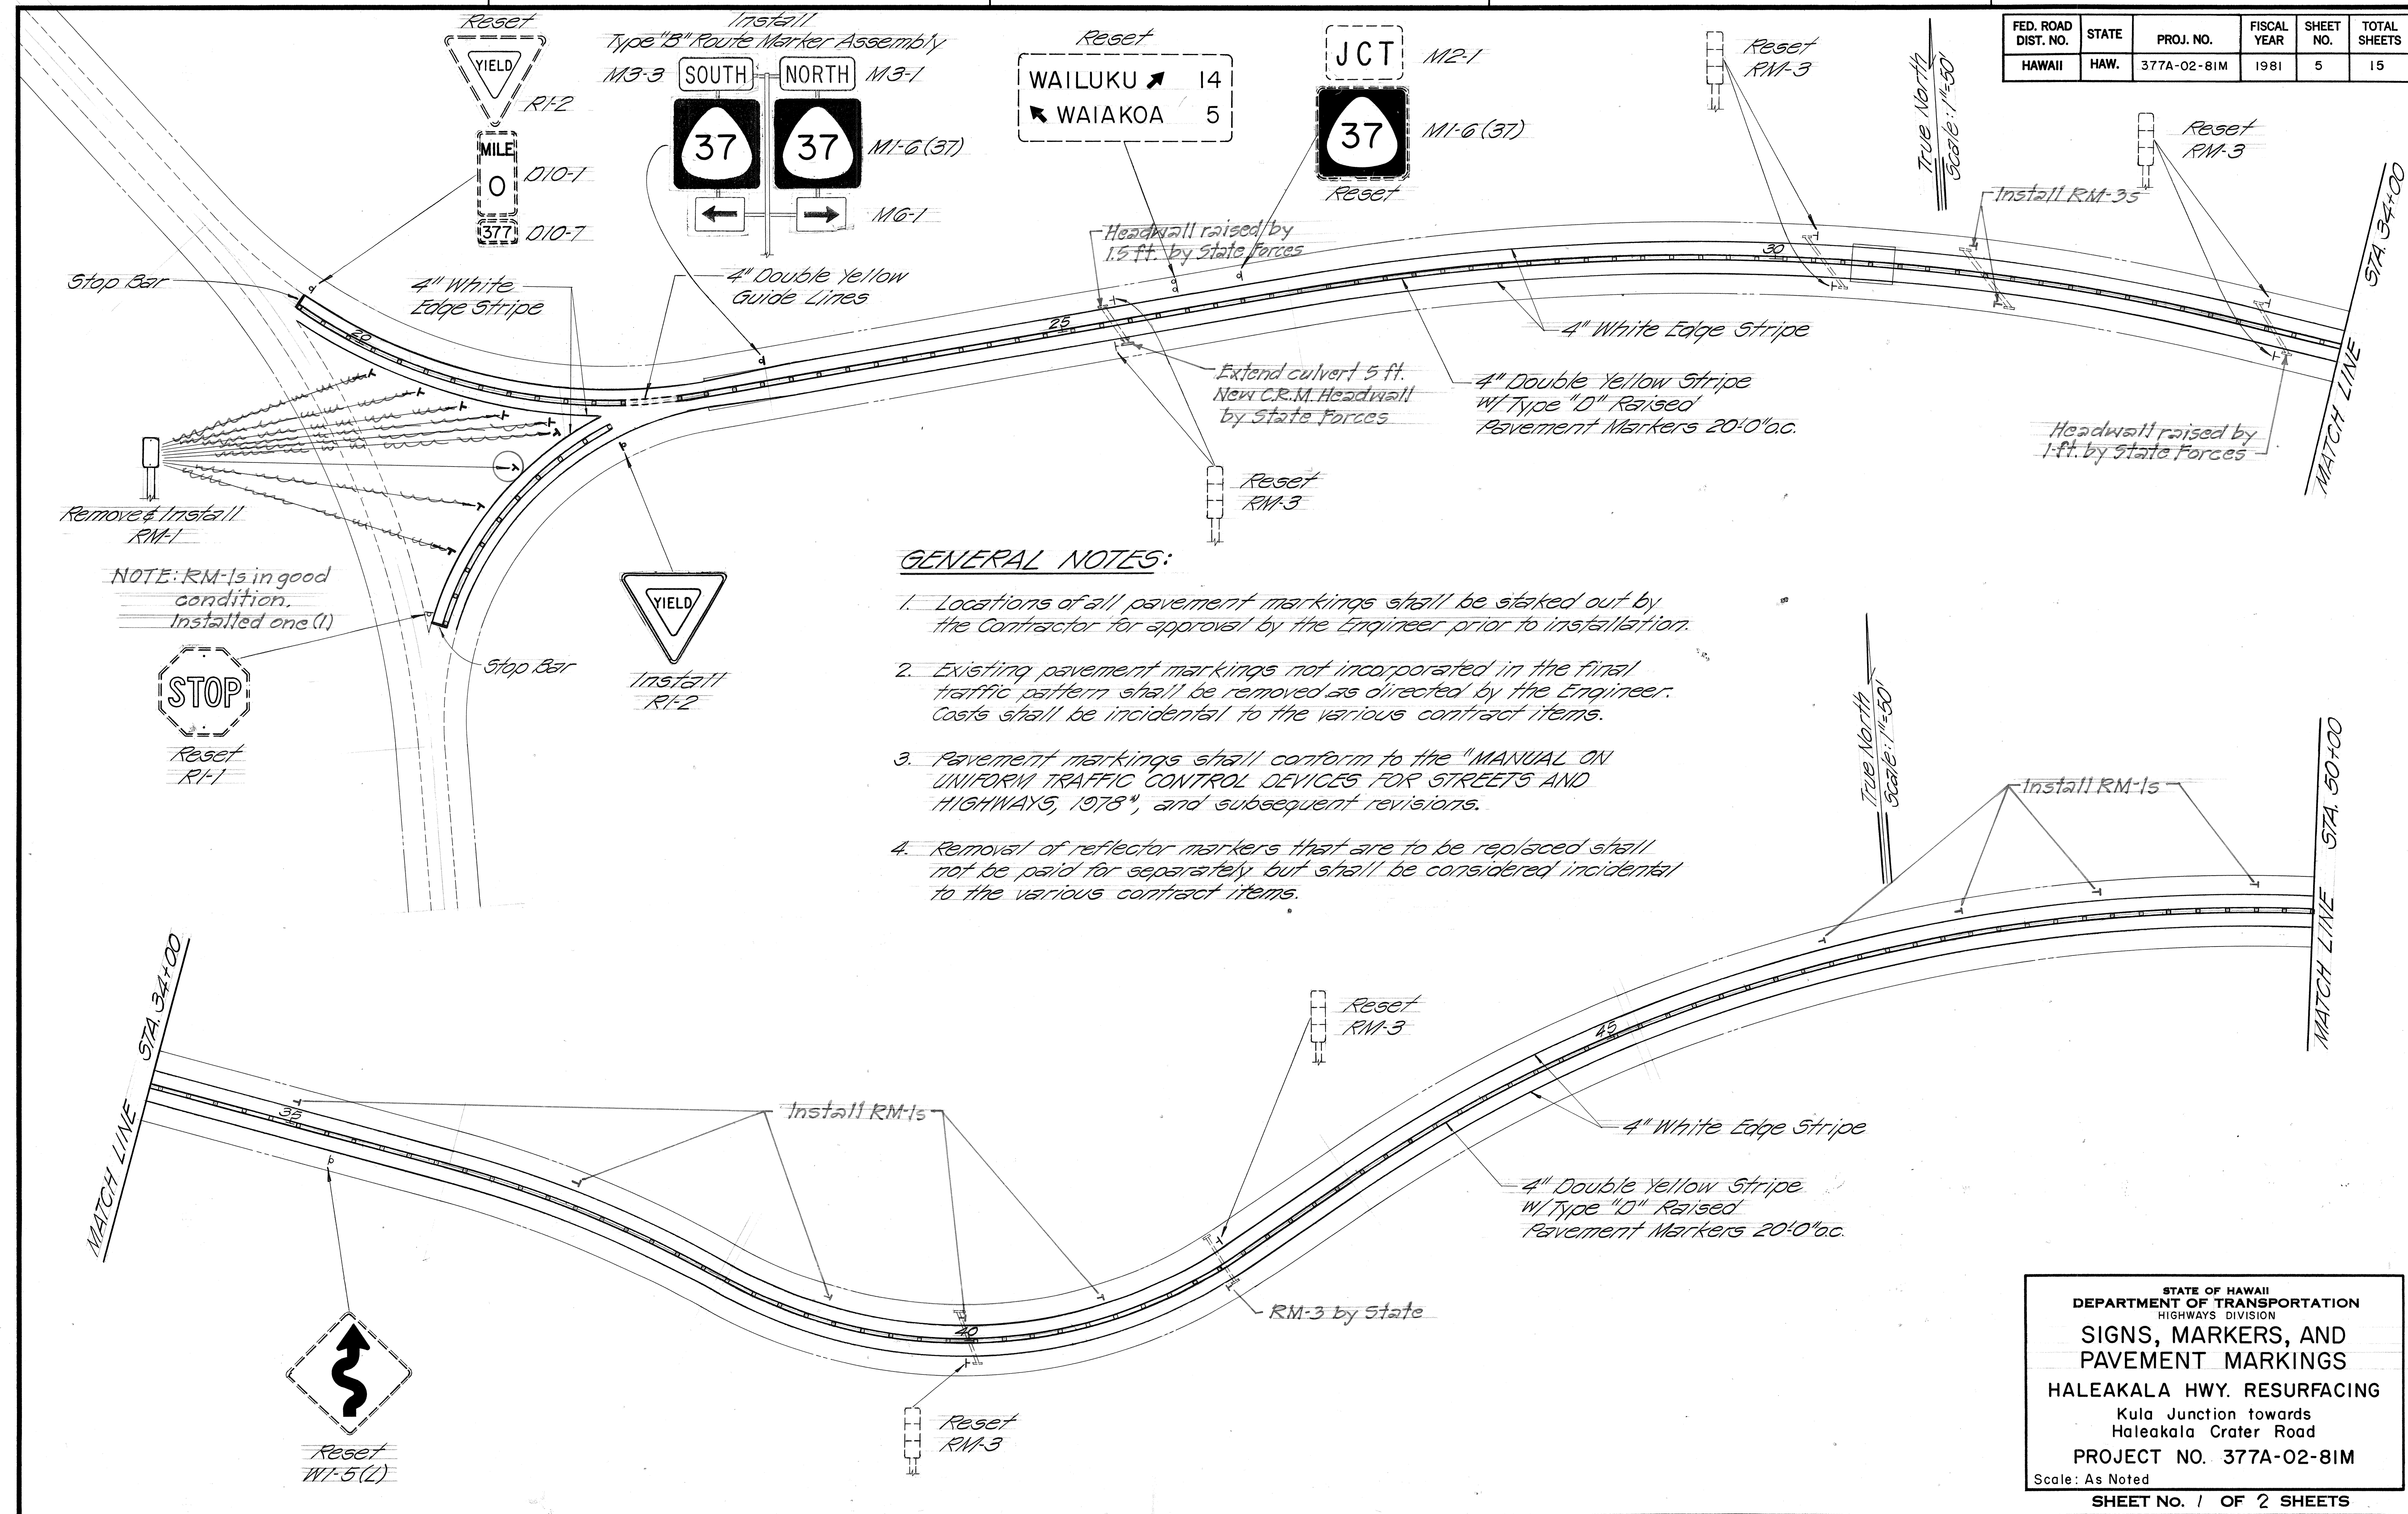

GENERAL NOTES:

1. Locations of all pavement markings shall be staked out by the Contractor for approval by the Engineer prior to installation.
2. Existing pavement markings not incorporated in the final traffic pattern shall be removed as directed by the Engineer. Costs shall be incidental to the various contract items.
3. Pavement markings shall conform to the "MANUAL ON UNIFORM TRAFFIC CONTROL DEVICES FOR STREETS AND HIGHWAYS, 1978", and subsequent revisions.
4. Removal of reflector markers that are to be replaced shall not be paid for separately but shall be considered incidental to the various contract items.

SURVEY PLOTTED BY	DATE
DRAWN BY	
DESIGNED BY	
CHECKED BY	


STATE OF HAWAII
DEPARTMENT OF TRANSPORTATION
HIGHWAYS DIVISION

SIGNS, MARKERS, AND PAVEMENT MARKINGS

HALEAKALA HWY. RESURFACING
Kula Junction towards Haleakala Crater Road
PROJECT NO. 377A-02-81M
Scale: As Noted
SHEET NO. 1 OF 2 SHEETS

FED. ROAD DIST. NO.	STATE	PROJ. NO.	FISCAL YEAR	SHEET NO.	TOTAL SHEETS
HAWAII	HAW.	377A-02-81M	1981	6	15

SIGN SUMMARY		
ITEM NO.	ITEM	QUANT.
621.4100	Reflector Marker with Post RM-1	14 each
621.5100	Regulatory and Warning Sign (10.5p. Ft. or less) with Post	4 each
621.6200	Type "B" Route Marker Assembly	1 each
632.0100	Reset Reflector Marker	10 each
632.1010	Reset Regulatory and Warning Sign	9 each
632.1020	Reset Destination Sign	1 each

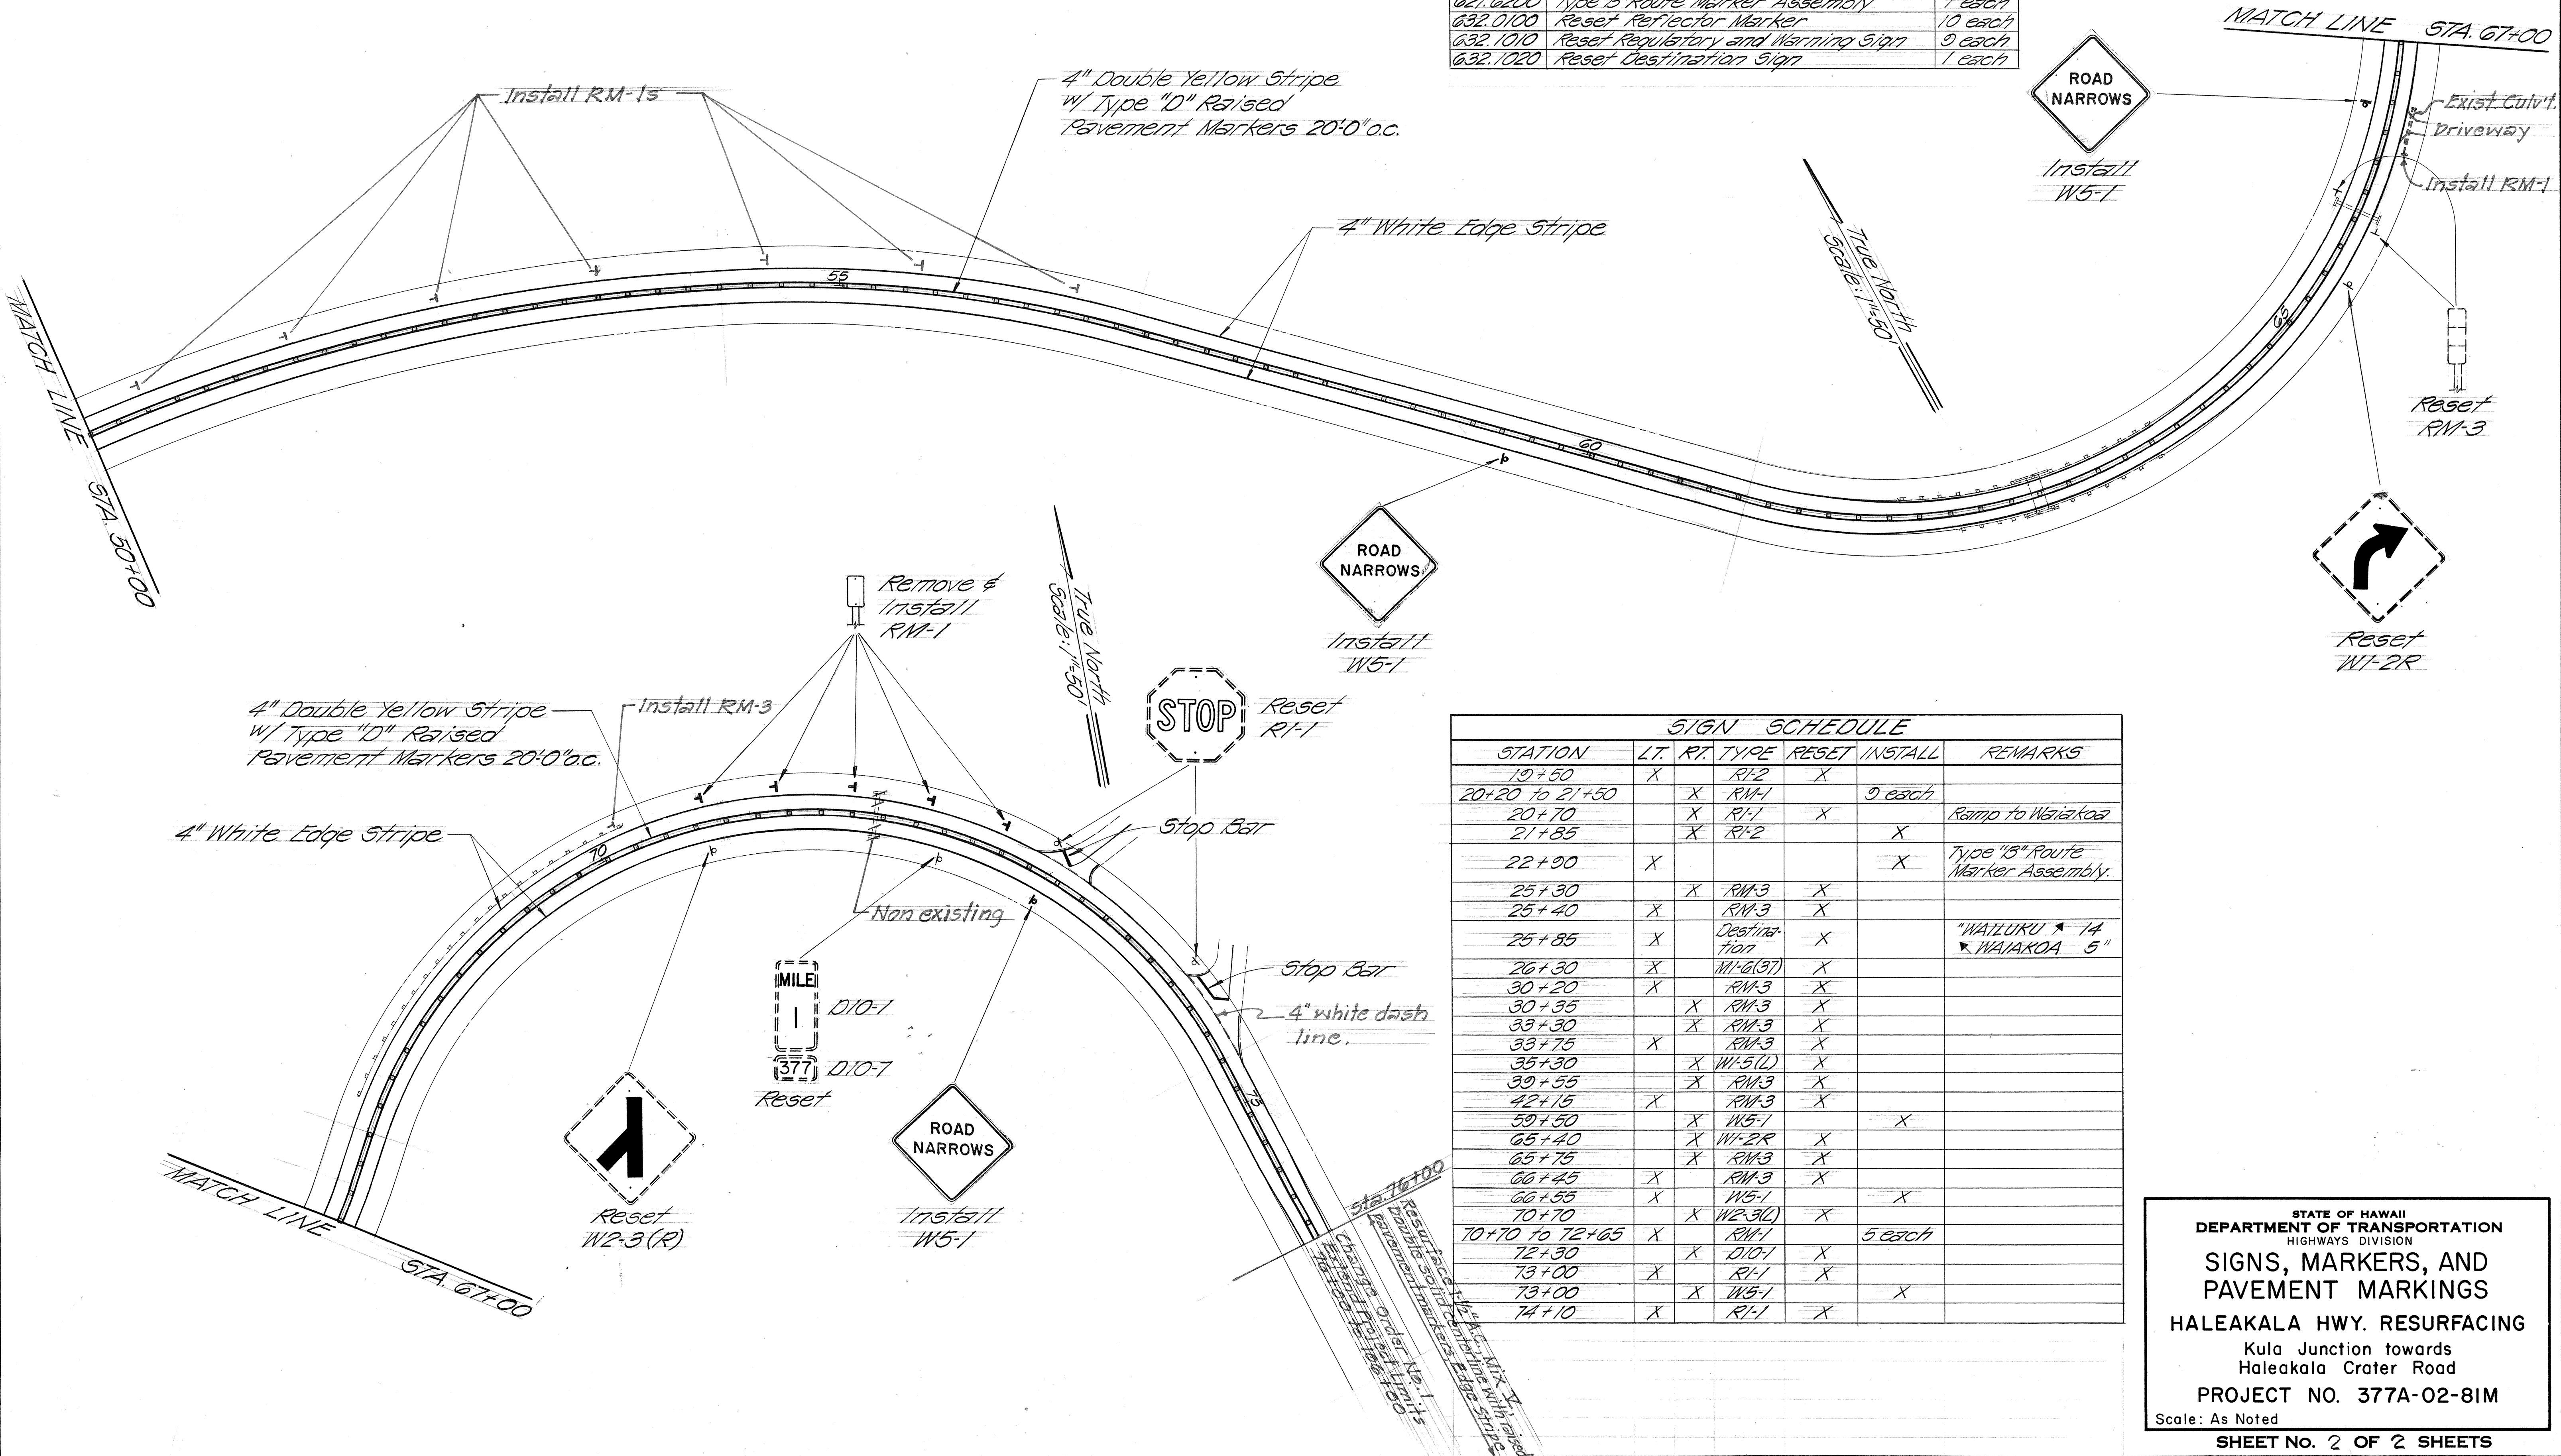

SIGN SCHEDULE						
STATION	LT.	RT.	TYPE	RESET	INSTALL	REMARKS
19+50	X		RI-2	X		
20+20 to 21+50		X	RM-1		9 each	
20+70		X	RI-1	X		Ramp to Waiakoa
21+85		X	RI-2		X	
22+90	X				X	Type "B" Route Marker Assembly
25+30		X	RM-3	X		
25+40	X		RM-3	X		
25+85	X		Destination	X		"WAILUKU" 14 "WAIKOA" 5"
30+20	X		RM-3	X		
30+35		X	RM-3	X		
33+30		X	RM-3	X		
33+75	X		RM-3	X		
35+30		X	W1-5(2)	X		
39+55		X	RM-3	X		
42+15	X		RM-3	X		
59+50		X	W5-1		X	
65+40		X	W1-2R	X		
65+75		X	RM-3	X		
66+45	X		RM-3	X		
66+55	X		W5-1		X	
70+70		X	W2-3(2)	X		
70+70 to 72+65	X		RM-1		5 each	
72+30		X	D10-1	X		
73+00	X		RI-1	X		
73+00		X	W5-1		X	
74+10	X		RI-1	X		

STATE OF HAWAII

DEPARTMENT OF TRANSPORTATION

HIGHWAYS DIVISION

SIGNS, MARKERS, AND PAVEMENT MARKINGS

HALEAKALA HWY. RESURFACING

Kula Junction towards Haleakala Crater Road

PROJECT NO. 377A-02-81M

Scale: As Noted

SHEET NO. 2 OF 2 SHEETS

SURVEY PLOTTED BY

DATE

DRAWN BY

DESIGNED BY

CHECKED BY

ORIGINAL PLAN

NOTE BOOK

No.