FED. ROAD DIST. NO.	STATE	PROJ. NO.	FISCAL YEAR	SHEET NO.	TOTAL SHEETS
HAWAII	HAW.	377A-02-81M	1981	1	15

377

INDEX TO DRAWINGS

SHEET NO.	DESCRIPTION
1	TITLE SHEET
2	TYPICAL SECTIONS
3 - 4	PLANS
5 - 6	SIGNS, MARKERS, AND PAVEMENT MARKINGS
7 - 15	STANDARD DETAILS

STATE OF HAWAII

DEPARTMENT OF TRANSPORTATION

HIGHWAYS DIVISION

HONOLULU, HAWAII

"AS BUILT"

PLANS OF

HALEAKALA HIGHWAY RESURFACING

KULA JUNCTION TOWARDS HALEAKALA CRATER ROAD

PROJECT NO. 377A-02-81M

DISTRICT OF MAKAWAO

ISLAND OF MAUI

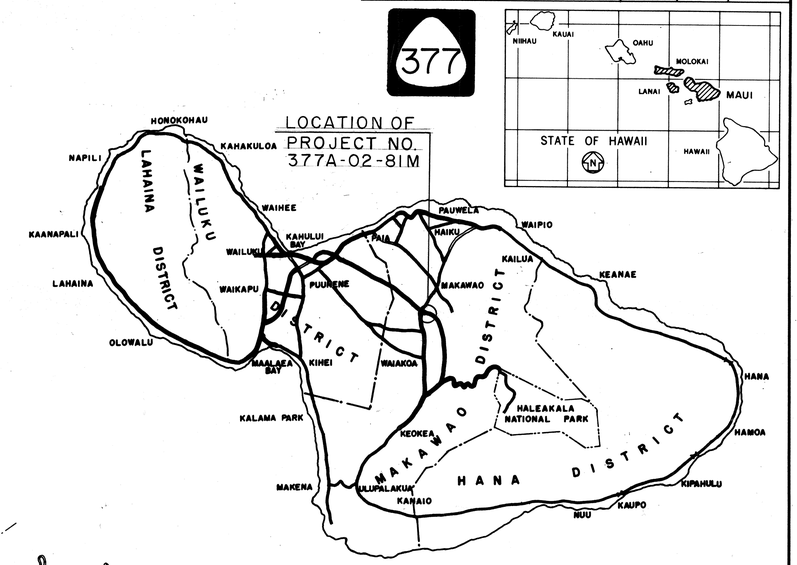

FEDERAL AID PROJECTS PREVIOUSLY CONSTRUCTED OR UNDER CONSTRUCTION

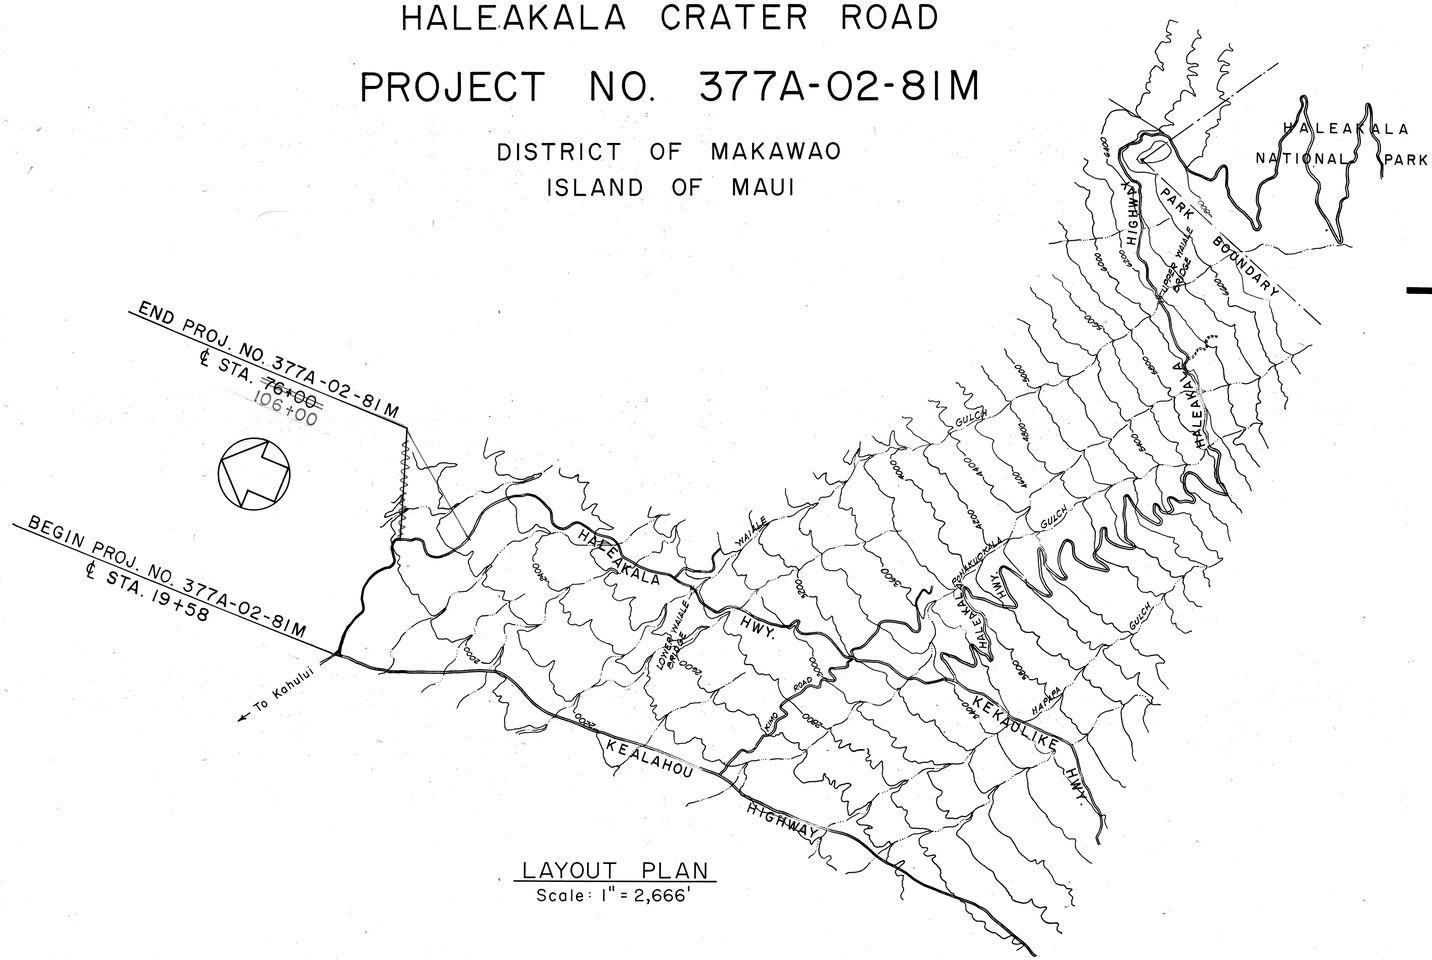

LAYOUT PLAN

Scale: 1" = 2,666'

ALL CHANGES MADE DURING CONSTRUCTION HAVE BEEN INCORPORATED ON THESE PLANS EXCEPT CHANGES IN THE ORIGINAL THEORETICAL QUANTITIES

Stanley F. Koth — RESIDENT ENGINEER

1-22-81 — DATE

DEPARTMENT OF TRANSPORTATION
STATE OF HAWAII

APPROVED:

James R. Carras — DIR. OF TRANSPORTATION

5/21/81 — DATE

UNIT "A"	R. Mikami	548-7534	5/27/81
DESIGNED BY	P. S. & E. BY	PHONE	DATE

C-4-4