FED. ROAD DIST. NO.	STATE	FED. AID PROJ. NO.	FISCAL YEAR	SHEET NO.	TOTAL SHEETS
HAWAII	HAW.	STP-0377(005)	2011	1	24

INDEX TO DRAWINGS

SHEET NO.	DESCRIPTION
1	TITLE SHEET
2	STANDARD PLANS SUMMARY
3	GENERAL NOTES AND LEGEND
4 – 5	WATER POLLUTION & EROSION CONTROL NOTES
6 – 7	TYPICAL SECTIONS AND DETAILS
8	WORK ZONE SIGNING PLAN, NOTES & DETAILS
9	CURB RAMP DETAILS
10	PAVEMENT MARKING LEGEND, NOTES AND SIGN DETAILS
11 – 24	ROADWAY & PAVEMENT MARKING PLANS

STATE OF HAWAII

DEPARTMENT OF TRANSPORTATION

HIGHWAYS DIVISION

HONOLULU, HAWAII

"AS-BUILT"

PLANS FOR

HALEAKALA HIGHWAY PAVEMENT PREVENTIVE MAINTENANCE

KULA JUNCTION TO HALEAKALA CRATER ROAD

FEDERAL-AID PROJECT NO. STP-0377(005)

DISTRICT OF MAKAWAO

ISLAND OF MAUI

PROJECT LOCATION

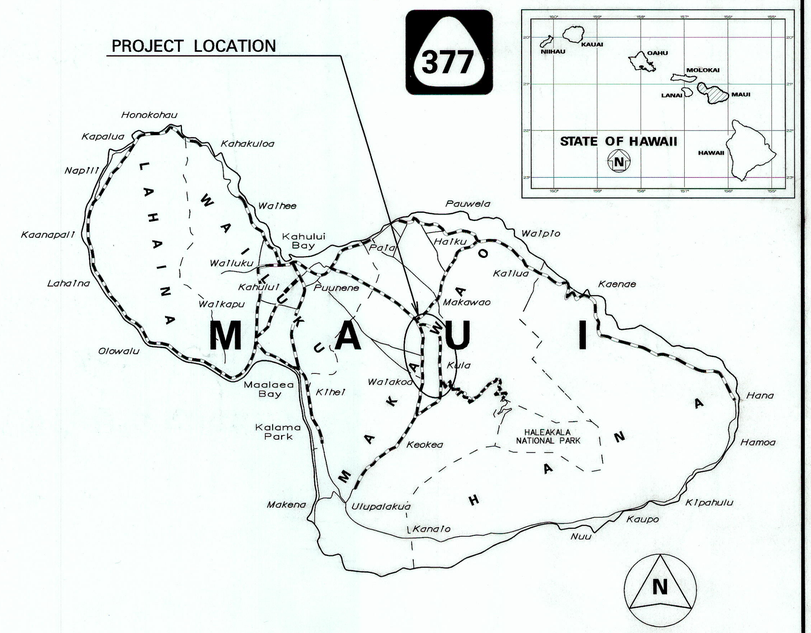

SCALE IN MILES

FEDERAL AID PROJECTS PREVIOUSLY CONSTRUCTED OR UNDER CONSTRUCTION

MILE POST 0.00 TO MILE POST 6.03

CHANGES MADE DURING CONSTRUCTION HAVE BEEN INCORPORATED ON THESE PLANS EXCEPT CHANGES IN THE ORIGINAL THEORETICAL QUANTITIES. FOR ACTUAL QUANTITIES, REFER TO PROJECT LEDGER AND/OR COMPUTATION BOOK.

RESIDENT ENGINEER DATE

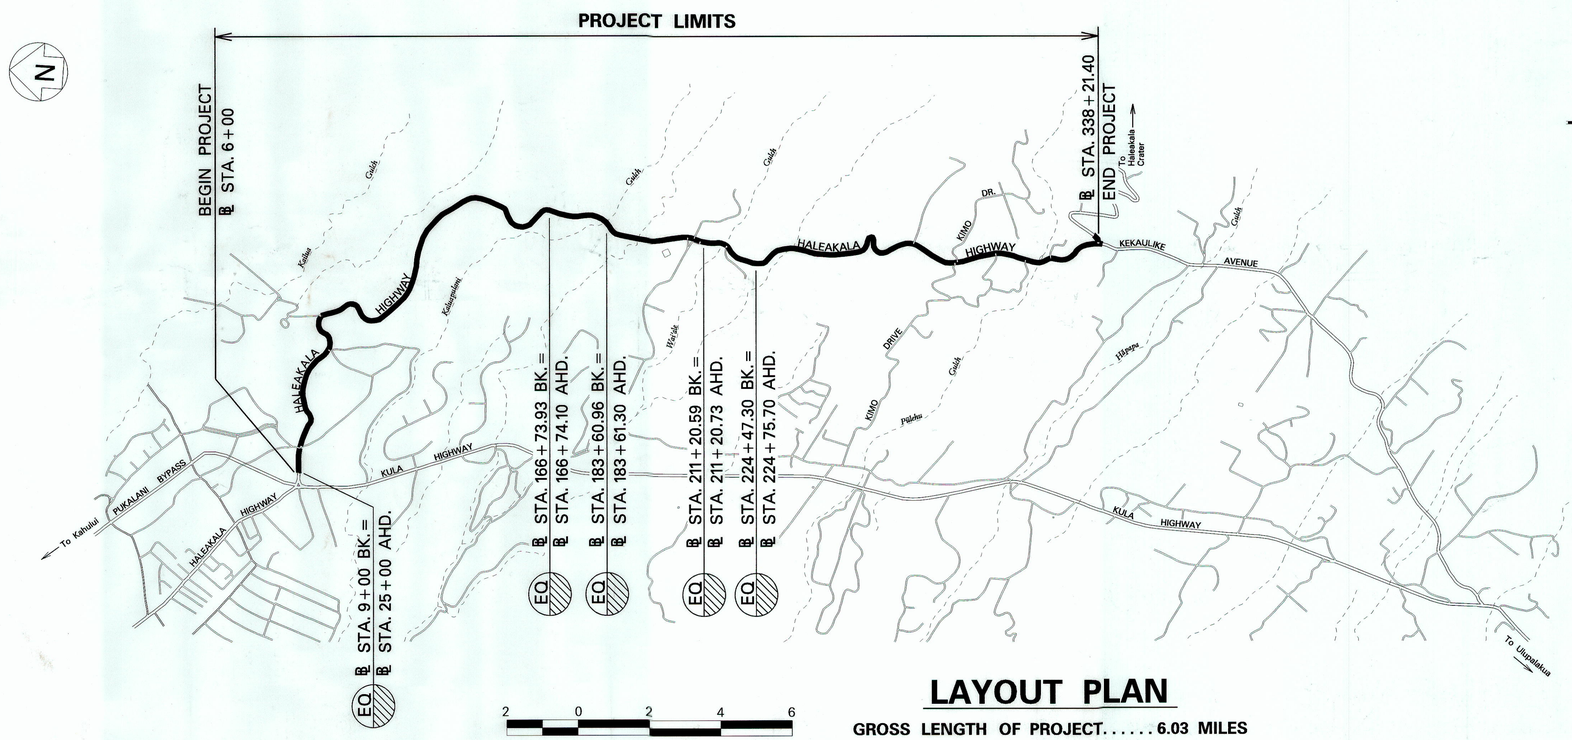

SCALE IN THOUSAND FEET

LAYOUT PLAN

GROSS LENGTH OF PROJECT..... 6.03 MILES

NET LENGTH OF PROJECT..... 6.00 MILES

DESIGN DESIGNATION

ADT (2010)	4,700
ADT (2020)	5,600
DHV	800
DESIGN K	14.5
DESIGN D	55/45
DESIGN T	5.5
T_{24}	3.5

DEPARTMENT OF TRANSPORTATION
STATE OF HAWAII

APPROVED:

DIR. OF TRANSPORTATION — DATE APR 08 2011

HWY-M	HWY-ME	873-3535	OCT., 2010
DESIGNED BY	P. S. & E. BY	PHONE	DATE