FED. ROAD DIST. NO.	STATE	FED. AID PROJ. NO.	FISCAL YEAR	SHEET NO.	TOTAL SHEETS
HAWAII	HAW.	STP-0377(006)	2014	1	38

377

STATE OF HAWAII

DEPARTMENT OF TRANSPORTATION

HIGHWAYS DIVISION

HONOLULU, HAWAII

"AS-BUILT"

PLANS FOR

KEKAULIKE AVENUE RESURFACING

HALEAKALA CRATER ROAD TO KULA HIGHWAY

FEDERAL-AID PROJECT NO. STP-0377(006)

DISTRICT OF MAKAWAO

ISLAND OF MAUI

INDEX TO DRAWINGS

SHEET NO.	DESCRIPTION
1	TITLE SHEET
2	STANDARD PLANS SUMMARY
3	GENERAL NOTES AND LEGEND
4 – 5	WATER POLLUTION AND EROSION CONTROL NOTES
6 – 7	TYPICAL SECTIONS AND DETAILS
8 – 14	GUARDRAIL DETAILS & NOTES
15 – 18	DRAINAGE PLAN & DETAILS
19 – 26	ROADWAY PLANS
27	PAVEMENT MARKING LEGEND, DETAILS & NOTES
28	RUMBLE STRIP DETAILS & NOTES
29	TRAFFIC COUNTING STATION DETAILS
30	WORK ZONE SIGNING PLAN, NOTES & DETAILS
31 – 38	SIGNING AND PAVEMENT MARKING PLANS

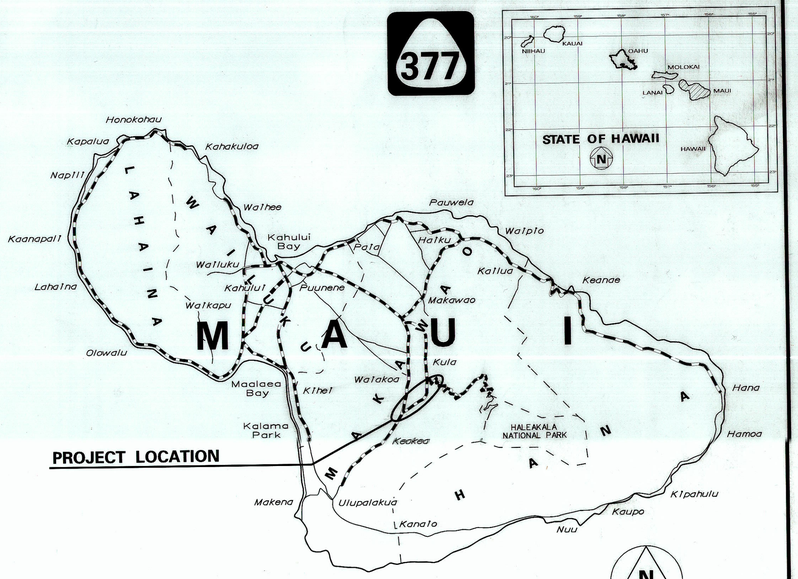

SCALE IN MILES

FEDERAL AID PROJECTS PREVIOUSLY CONSTRUCTED OR UNDER CONSTRUCTION

MILE POST 6.03 TO MILE POST 9.17

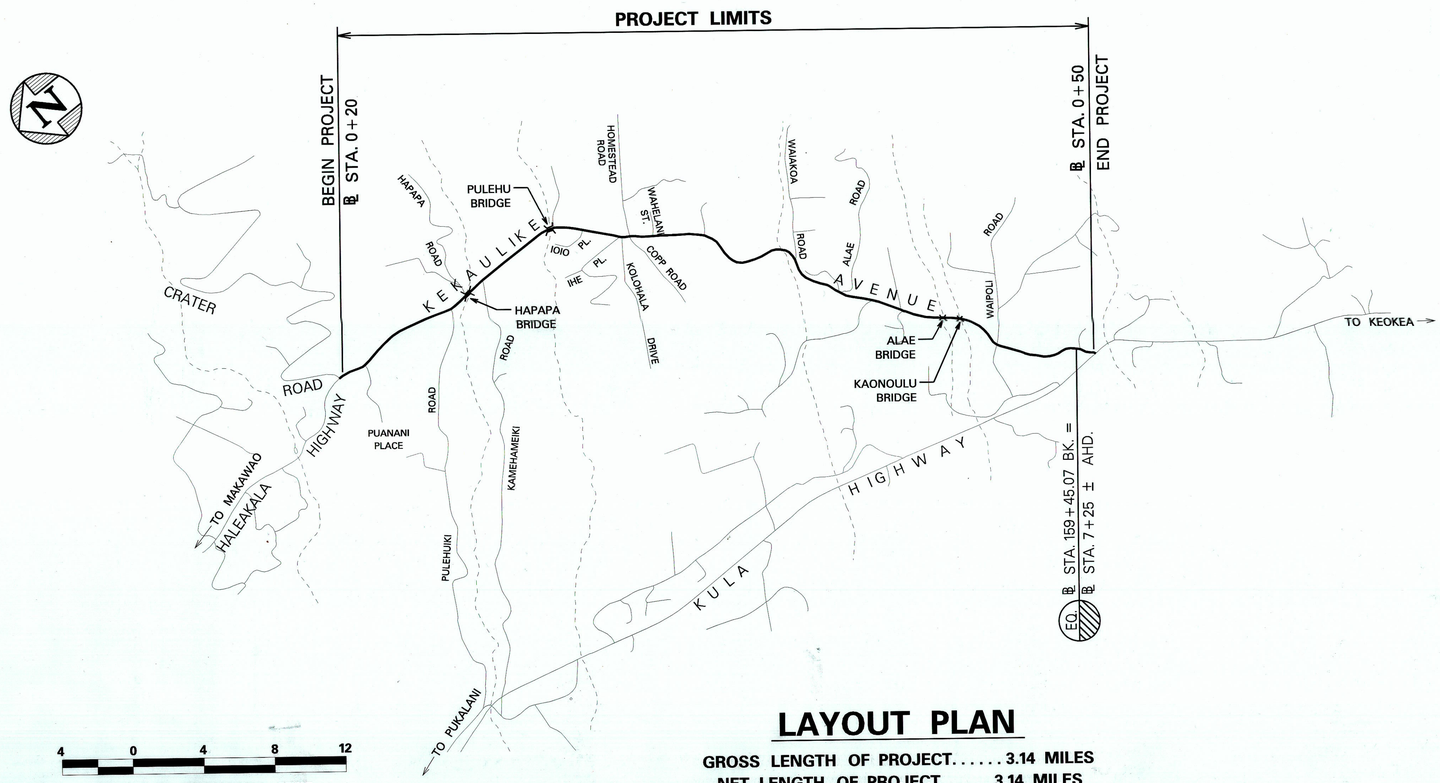

SCALE IN THOUSAND FEET

LAYOUT PLAN

GROSS LENGTH OF PROJECT..... 3.14 MILES

NET LENGTH OF PROJECT..... 3.14 MILES

CHANGES MADE DURING CONSTRUCTION HAVE BEEN INCORPORATED ON THESE PLANS EXCEPT CHANGES IN THE ORIGINAL THEORETICAL QUANTITIES. FOR ACTUAL QUANTITIES, REFER TO PROJECT LEDGER AND/OR COMPUTATION BOOK.

RESIDENT ENGINEER — 9/17/2021 DATE

DEPARTMENT OF TRANSPORTATION
STATE OF HAWAII

APPROVED:

for DIR. OF TRANSPORTATION — 10-17-13 DATE

HWY-M DESIGNED BY — HWY-ME MANAGED BY — 873-3535 PHONE — JULY 2013 DATE