FED. ROAD DIST. NO.	STATE	PROJ. NO.	FISCAL YEAR	SHEET NO.	TOTAL SHEETS
HAWAII	HAW.	378A-03-68	1967	1	25

INDEX TO DRAWINGS	
SHEET NO	DESCRIPTION
1	TITLE SHEET
2 & 3	TYPICAL SECTIONS & DETS.
4 - 6	PLANS
7 - 25	CROSS SECTIONS

STATE OF HAWAII
DEPARTMENT OF TRANSPORTATION
HIGHWAYS DIVISION
HONOLULU, HAWAII

"AS BUILT"

PLANS FOR WIDENING CERTAIN PORTIONS OF

HALEAKALA HIGHWAY

KEKAULIKE HIGHWAY TO HALEAKALA NATIONAL PARK BOUNDARY

PROJECT NO. 378A-03-68

DISTRICT OF MAKAWAO
ISLAND OF MAUI

SCALES

PLAN		1 IN. = 100 FT.
PROFILE	HOR.	1 IN. = — FT.
	VER.	1 IN. = — FT.
X-SECTIONS	HOR.	1 IN. = 10 FT.
	VER.	1 IN. = 10 FT.

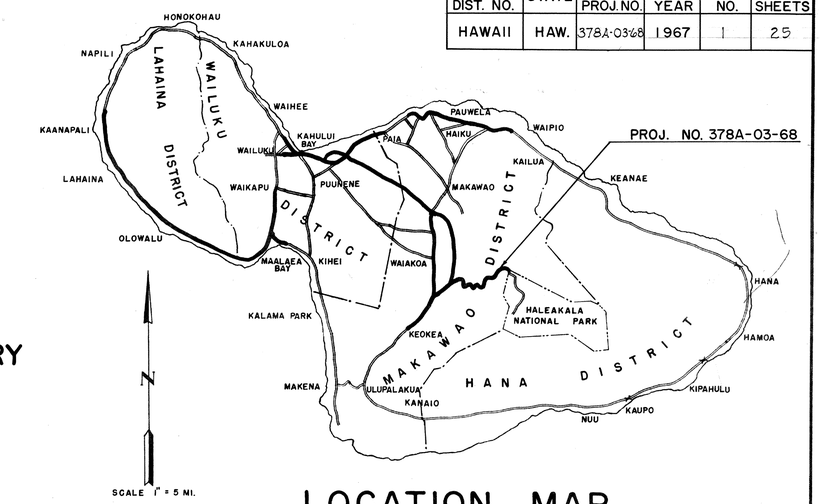

LOCATION MAP

FEDERAL AID PROJECTS PREVIOUSLY CONSTRUCTED OR UNDER CONSTRUCTION

TRUE NORTH
SCALE 1" = 2000'

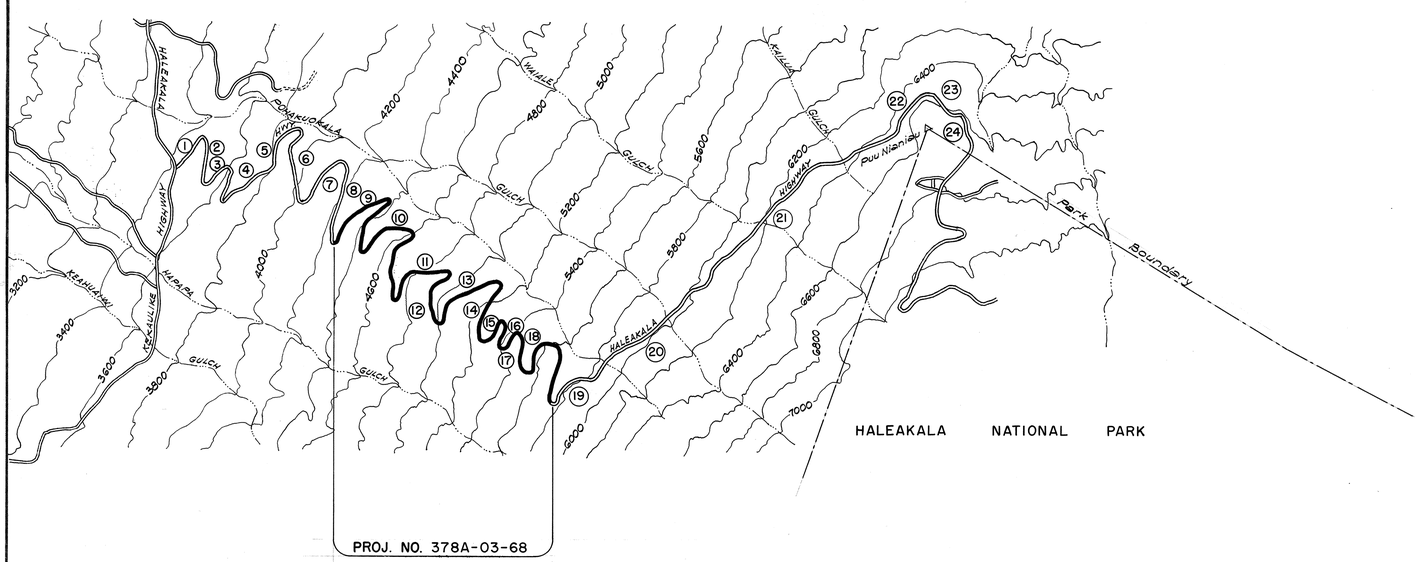

LAYOUT OF PROJECT

LENGTH OF PROJECT	4.138 MILES
LENGTH OF IMPROVEMENTS	3.563 MILES

NOTE:
All changes made during construction have been noted on these tracings in red and checked by:

Manuel J. Silva
PROJECT ENGINEER

Dec. 2, 1968
DATE

APPROVED: DATE 12/4/67

For DIRECTOR OF TRANSPORTATION

R. TERADA

1

DS-3-4