FED. ROAD DIST. NO.	STATE	PROJ. NO.	FISCAL YEAR	SHEET NO.	TOTAL SHEETS
HAWAII	HAW.	377A-01-70	1971	1	29

INDEX TO DRAWINGS	
SHEET NO	DESCRIPTION
1	TITLE SHEET
2	TYPICAL SECTION
3 - 4	PLAN & PROFILE
5	PROJ. INFORMATION SIGN
6 - 12	STANDARD DETAILS
13 - 27	STRUCTURES
13 - 15	POHAKUOKAA BRIDGE
16 - 18	WAIALE BRIDGE
19 - 23	TYPICAL DETAILS
24 - 27	STANDARD DETAILS
28 - 29	CROSS SECTION

STATE OF HAWAII
DEPARTMENT OF TRANSPORTATION
HIGHWAYS DIVISION
HONOLULU, HAWAII

"AS BUILT" PLANS OF

HALEAKALA HIGHWAY BRIDGE WIDENING

(~~POHAKUOKAA~~ POHAKUOKALA AND WAIALE BRIDGES)

PROJECT NO. 377A-01-70

DISTRICT OF MAKAWAO
ISLAND OF MAUI

SCALES

PLAN		1 IN. = 20 FT.
PROFILE	HOR.	1 IN. = 20 FT.
	VER.	1 IN. = 2 FT.
X-SECTIONS	HOR.	1 IN. = 10 FT.
	VER.	1 IN. = 10 FT.

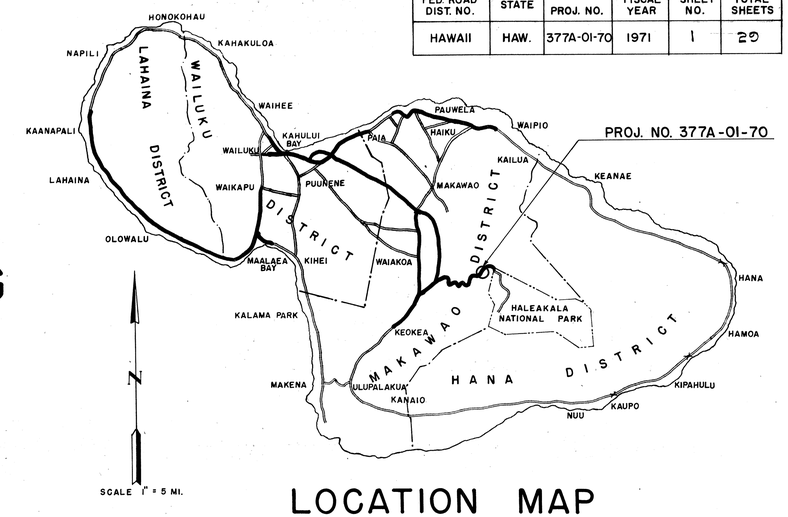

LOCATION MAP

FEDERAL AID PROJECTS PREVIOUSLY CONSTRUCTED OR UNDER CONSTRUCTION

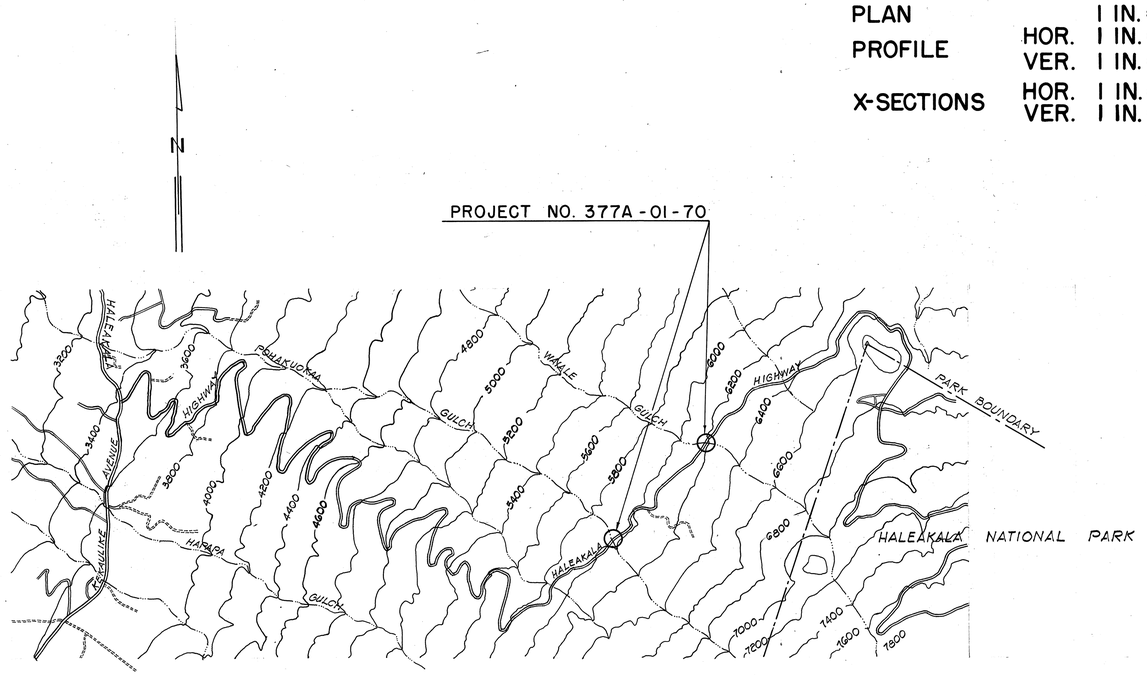

LAYOUT OF PROJECT
SCALE: 1" = 2000'

GROSS LENGTH OF PROJECT	0.162 MI.
BRIDGES OVER 20' SPAN	0.029 MI.
NET LENGTH OF ROADWAY	0.133 MI.

NOTE:
ALL CHANGES MADE DURING CONSTRUCTION HAVE BEEN INCORPORATED ON THESE PLANS IN RED EXCEPT CHANGES IN THE ORIGINAL THEORETICAL QUANTITIES.

George N. Kaya — PROJECT ENGINEER — 9/21/72 DATE

APPROVED: DATE 3/30/71
E. Alvey Wright
for DIRECTOR OF TRANSPORTATION

P.S. & E BY: Ronald Tsuzuki
PHONE: 548-2456

DESIGNED BY: MAUI DISTRICT OFFICE
STATE HIGHWAYS DIVISION
DATE: JUNE 1970

DD-A-3-5