FED. ROAD DIST. NO.	STATE	FED. AID PROJ. NO.	FISCAL YEAR	SHEET NO.	TOTAL SHEETS
HAWAII	HAW.	S-0380(5)	1970	1	44

INDEX TO DRAWINGS	
SHEET NO	DESCRIPTION
1	TITLE SHEET
2 - 3	TYPICAL SECTIONS
* 4	BORROW PIT SITE No. 1
5 - 14	PLAN AND PROFILE
15 - 16	SUPERELEVATION DIAGRAMS
17 - 22	TRAFFIC SIGN, LANDSCAPING, AND PAVEMENT MARKERS
23	DESTINATION SIGN DETAILS
24	HIGHWAY LIGHTING SYSTEM
25 - 45	MISCELLANEOUS AND STANDARD DETAILS

* SHEET No. 4 HAS BEEN DELETED

STATE OF HAWAII
DEPARTMENT OF TRANSPORTATION
HIGHWAYS DIVISION
HONOLULU, HAWAII

"AS BUILT" PLANS OF

KAHULUI AIRPORT - MAALAEA HIGHWAY

(PUUNENE AVENUE TO MAALAEA)

FEDERAL AID SECONDARY PROJ. NO. S-0380(5)

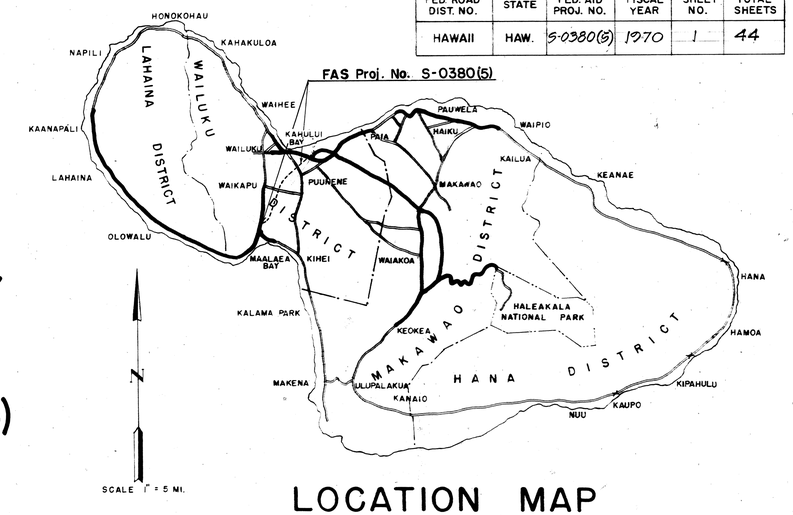

LOCATION MAP

FEDERAL AID PROJECTS PREVIOUSLY CONSTRUCTED OR UNDER CONSTRUCTION

SCALES

PLAN		1 IN. = 100 FT.
PROFILE	HOR.	1 IN. = 100 FT.
	VER.	1 IN. = 10 FT.
X-SECTIONS	HOR.	1 IN. = 10 FT.
	VER.	1 IN. = 10 FT.

DISTRICT OF WAILUKU
ISLAND OF MAUI

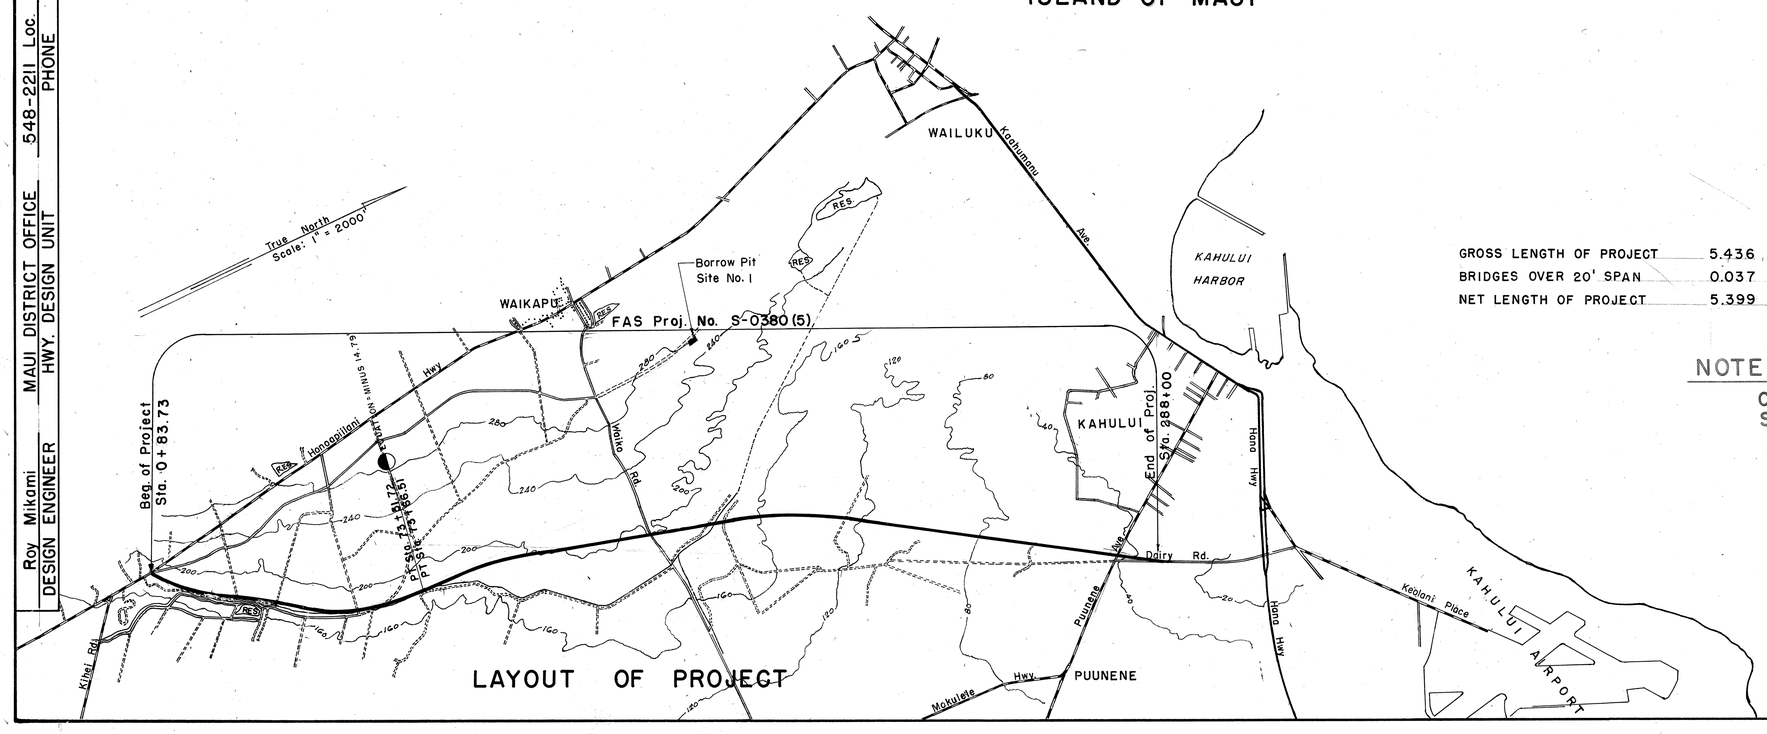

LAYOUT OF PROJECT

GROSS LENGTH OF PROJECT	5.436	MILES
BRIDGES OVER 20' SPAN	0.037	MILES
NET LENGTH OF PROJECT	5.399	MILES

DESIGN CLASSIFICATION

CONTROL OF ACCESS = PARTIAL	
ADT (1970)	1300
ADT (1990)	2500
DHV	11%
D	60/40
T	3%
T 24	6%
V	60 M.P.H.

NOTE:

CHANGES MADE DURING CONSTRUCTION HAVE BEEN SHOWN IN RED AND BY SUPPLEMENTAL PLAN SHEETS.

Manuel J. Silva
PROJECT ENGINEER

DATE

DEPARTMENT OF TRANSPORTATION
STATE OF HAWAII

APPROVED:

for E. Alvey Wright 9/25/70
DIRECTOR OF TRANSPORTATION DATE

Roy Mikami
DESIGN ENGINEER

MAUI DISTRICT OFFICE
HWY. DESIGN UNIT

548-2211 Loc.
PHONE

SEPT. 1970
DATE