

BASELINE CURVE DATA


$\Delta = 34^{\circ}-21'-30''$
 $L = 505.22'$

WEST LANE CURVE DATA




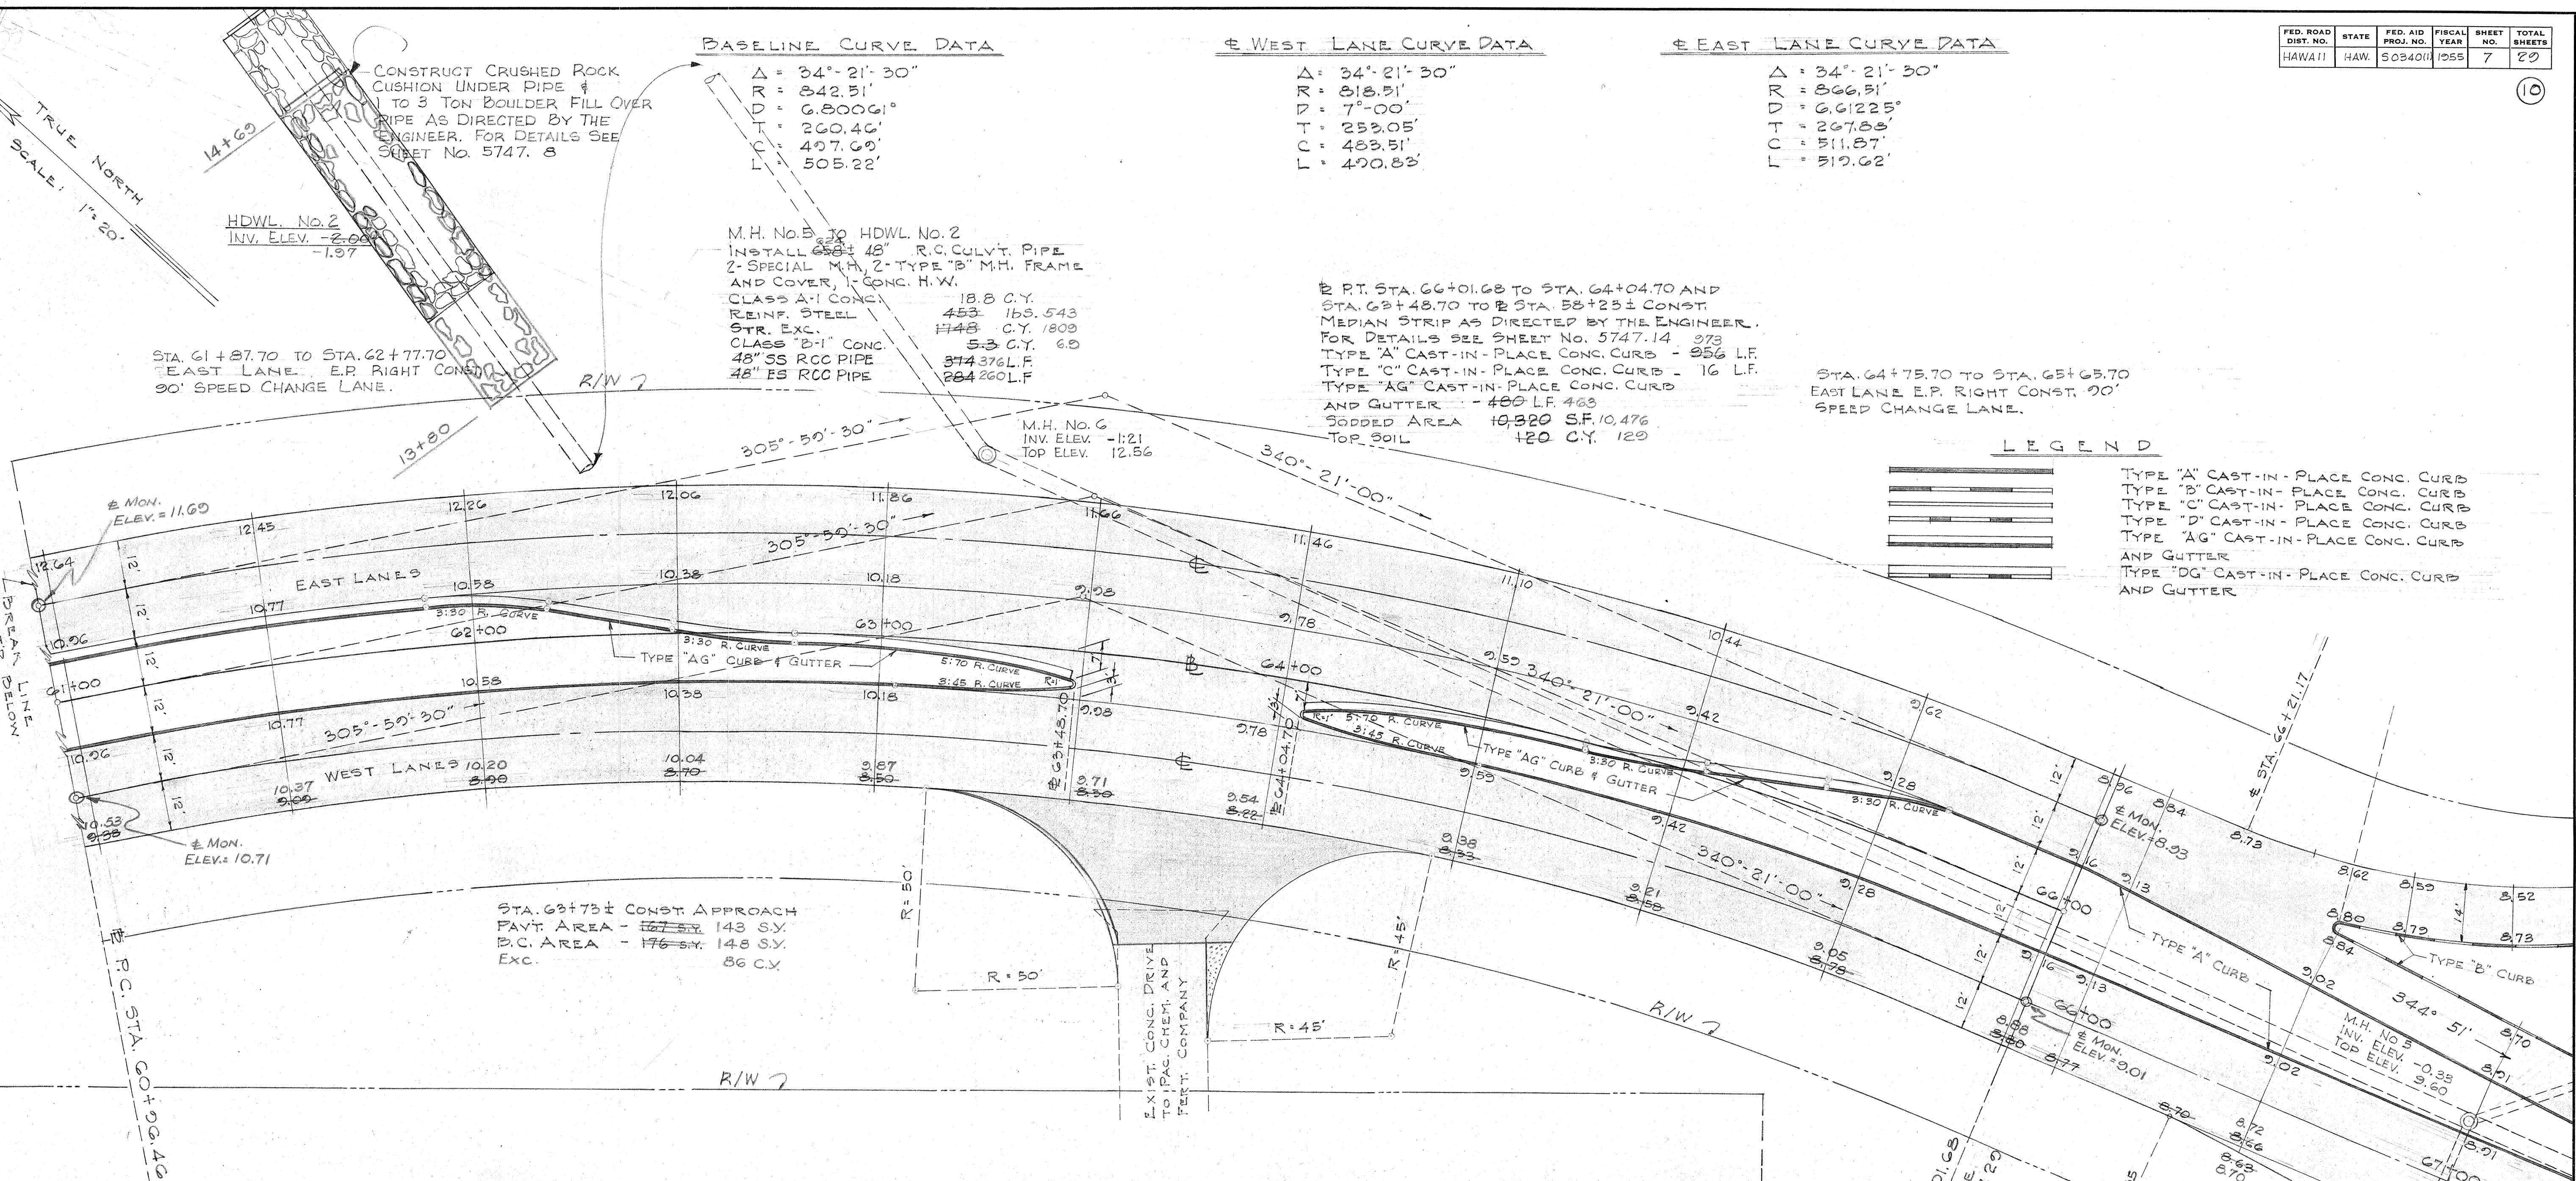

LEGEND

- TYPE "A" CAST-IN-PLACE CONC. CURB
- TYPE "B" CAST-IN-PLACE CONC. CURB
- TYPE "C" CAST-IN-PLACE CONC. CURB
- TYPE "D" CAST-IN-PLACE CONC. CURB
- TYPE "AG" CAST-IN-PLACE CONC. CURB
- AND GUTTER
- TYPE "DG" CAST-IN-PLACE CONC. CURB
- AND GUTTER

STA. 63+75 ± CONST. APPROACH
 PAVT. AREA - 143 S.Y.
 B.C. AREA - 176 S.Y.
 EXC. - 86 C.Y.

EXIST. CONC. DRIVE
 TO PAC. CHEM. AND
 PET. COMPANY

NOTE:
 FOR LAYOUT AND DETAILS
 OF INTERSECTION SEE
 SHEETS Nos. 5740, 45, 6, 7
 FOR LAYOUT AND DETAILS
 OF DRAINAGE SYSTEM SEE
 SHEET No. 5747, 8, 9

TERRITORIAL HIGHWAY DEPARTMENT
TERRITORY OF HAWAII
DETAILS
OF
MEDIAN OPENING
AND
CONNECTION
PROJ. No. 50340(1)
SCALE: 1"=20' **MAR. 1955**

SHEET No. 1 OF 1 SHEETS

5747.7

SURVEY PLOTTED BY: _____
 DESIGNED BY: _____
 TRACED BY: _____
 QUANTITIES BY: _____
 CHECKED BY: _____
 ORIGINAL PLAN No. _____
 NOTE BOOK No. _____