FED. ROAD DIST. NO.	STATE	PROJ. NO.	FISCAL YEAR	SHEET NO.	TOTAL SHEETS
HAWAII	HAW.	HWY-0-02-75	1977	1	5

INDEX TO DRAWINGS

SHEET NO.	DESCRIPTION
1	LOCATION PLANS
2	WAIANAE OFFICE PLAN & PLOT PLAN
3	SECTION & ELEVATIONS
4	~~WAIHAWA~~ WAHIAWA OFFICE PLAN & PLOT PLAN
5	SECTION & ELEVATIONS

STATE OF HAWAII

DEPARTMENT OF TRANSPORTATION

LAND TRANSPORTATION FACILITIES DIVISION

HONOLULU, HAWAII

"AS BUILT"

PLANS FOR CONSTRUCTION OF OFFICE BUILDINGS AT WAIANAE AND WAHIAWA BASEYARDS

PROJECT NO. HWY.-0-02-75

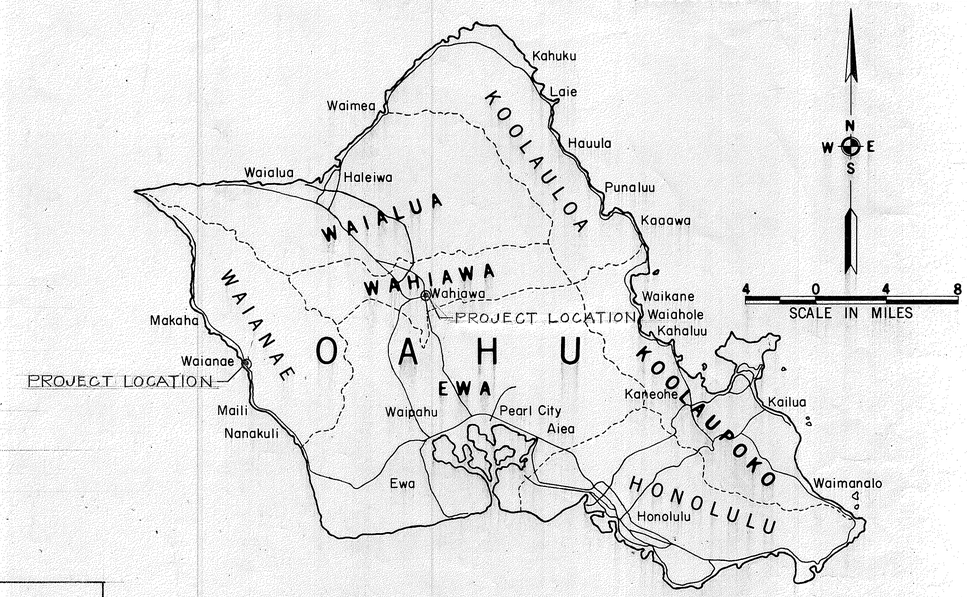

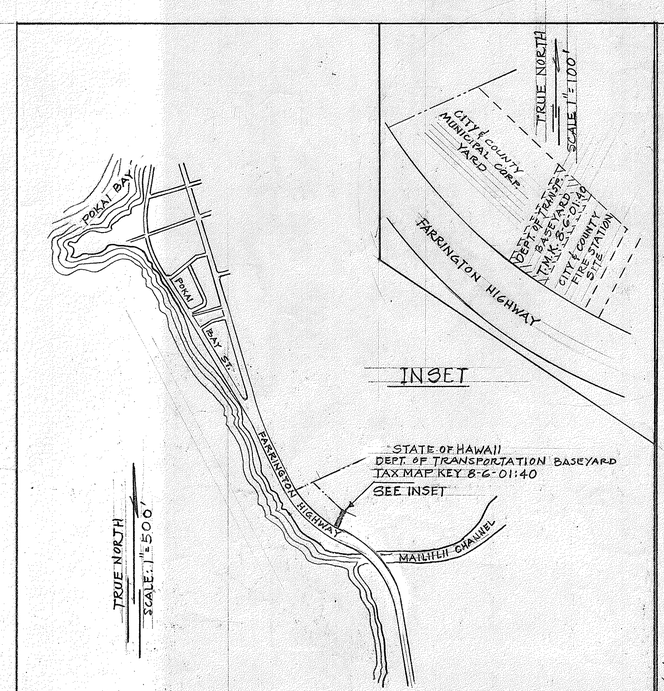

WAIANAE BASEYARD
LOCATION PLAN

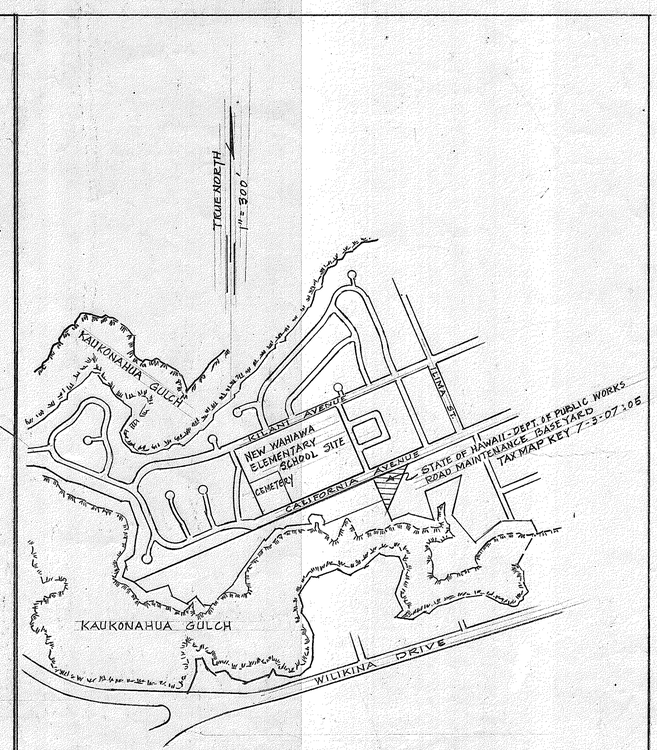

WAHIAWA BASEYARD
LOCATION PLAN

ALL CHANGES MADE DURING CONSTRUCTION HAVE BEEN INCORPORATED ON THESE PLANS IN RED EXCEPT CHANGES IN THE ORIGINAL THEORETICAL QUANTITIES. FOR ACTUAL QUANTITIES, REFER TO PROJECT LEDGER AND/OR COMPUTATION BOOK.

Leo Jonas — RESIDENT ENGINEER — 6/23/81 DATE

LT-DB	A. Nishimura	548-7537	May, 1977
DESIGNED BY	P. S. & E. BY	PHONE	DATE

DEPARTMENT OF TRANSPORTATION
STATE OF HAWAII

APPROVED: for R. Higashionna — DIR. OF TRANSPORTATION — 7/29/77 DATE

SHEET No. 1 OF 5 SHEETS