INDEX TO DRAWINGS	
SHEET NO.	DESCRIPTION
1	TITLE SHEET
2	STANDARD PLANS SUMMARY
3	GENERAL NOTES AND LEGEND
4 – 5	WATER POLLUTION AND EROSION CONTROL NOTES
6	DEMOLITION PLAN
7	GENERAL SITE PLAN
8	SITE LAYOUT PLAN
9	GRADING & DRAINAGE PLAN
10	UTILITIES PLAN
11	SECOND STREET WALKWAY PLAN
12	SEWER LINE PROFILE
13 – 14	SITE SECTIONS
15 – 16	DRYING BEDS LAYOUT
17 – 18	MISCELLANEOUS DETAILS
19	WALKWAY DETAILS
20	ACCESS ROAD LAYOUT
21	TRAFFIC & EROSION CONTROL PLAN
22	GENERAL NOTES AND TYPICAL DETAILS
23 – 24	DRYING BED FOUNDATION PLAN FACILITY
25 – 26	SECTIONS
27	DETAILS
28	NOTES & SCHEDULES
29	ELECTRICAL SITE DEMOLITION PLAN
30 – 32	ELECTRICAL SITE PLAN
33	ONE–LINE DIAGRAM
34	ELECTRICAL DETAILS

STATE OF HAWAII

DEPARTMENT OF TRANSPORTATION

HIGHWAYS DIVISION

HONOLULU, HAWAII

"AS-BUILT"

PLANS FOR

PEARL CITY DRYING BED FACILITY

PROJECT NO. HWY–O–01–08

DISTRICT OF HONOLULU

ISLAND OF OAHU

FED. ROAD DIST. NO.	STATE	PROJ. NO.	FISCAL YEAR	SHEET NO.	TOTAL SHEETS
HAWAII	HAW.	HWY–O–01–08	2010	1	34

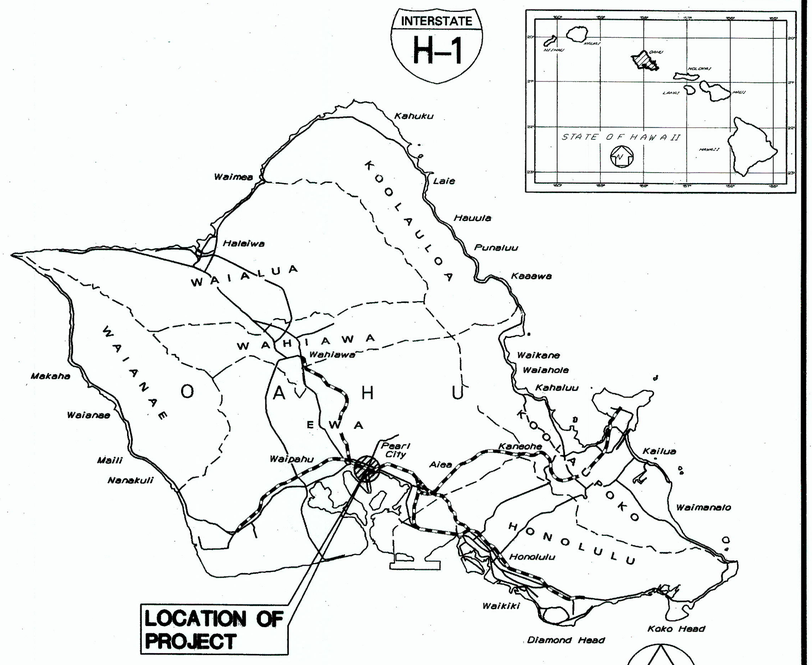

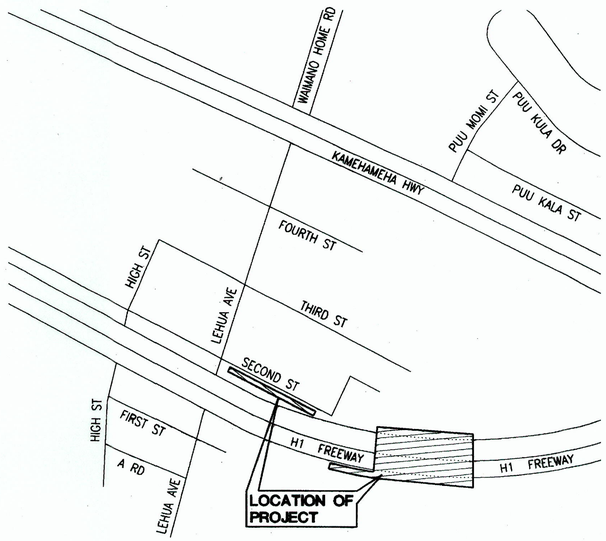

LAYOUT PLAN

SCALE: 1"= 200'

MITSUNAGA & ASSOC. — DESIGNED BY

HWY–DS — MANAGED BY

692–7544 — PHONE

5/2010 — DATE

CHANGES MADE DURING CONSTRUCTION HAVE BEEN INCORPORATED ON THESE PLANS EXCEPT CHANGES IN THE ORIGINAL THEORETICAL QUANTITIES. FOR ACTUAL QUANTITIES, REFER TO PROJECT LEDGER AND/OR COMPUTATION BOOK.

RESIDENT ENGINEER — DATE 6/4/14

DEPARTMENT OF TRANSPORTATION
STATE OF HAWAII

APPROVED:

DIR. OF TRANSPORTATION — DATE 5-11-10