


FED ROAD DIST. NO.	STATE	FED AID PROJ. NO.	FISCAL YEAR	SHEET NO.	TOTAL SHEETS
HAWAII	HAW.	SN-PAF D-1(2)	1944	2	2

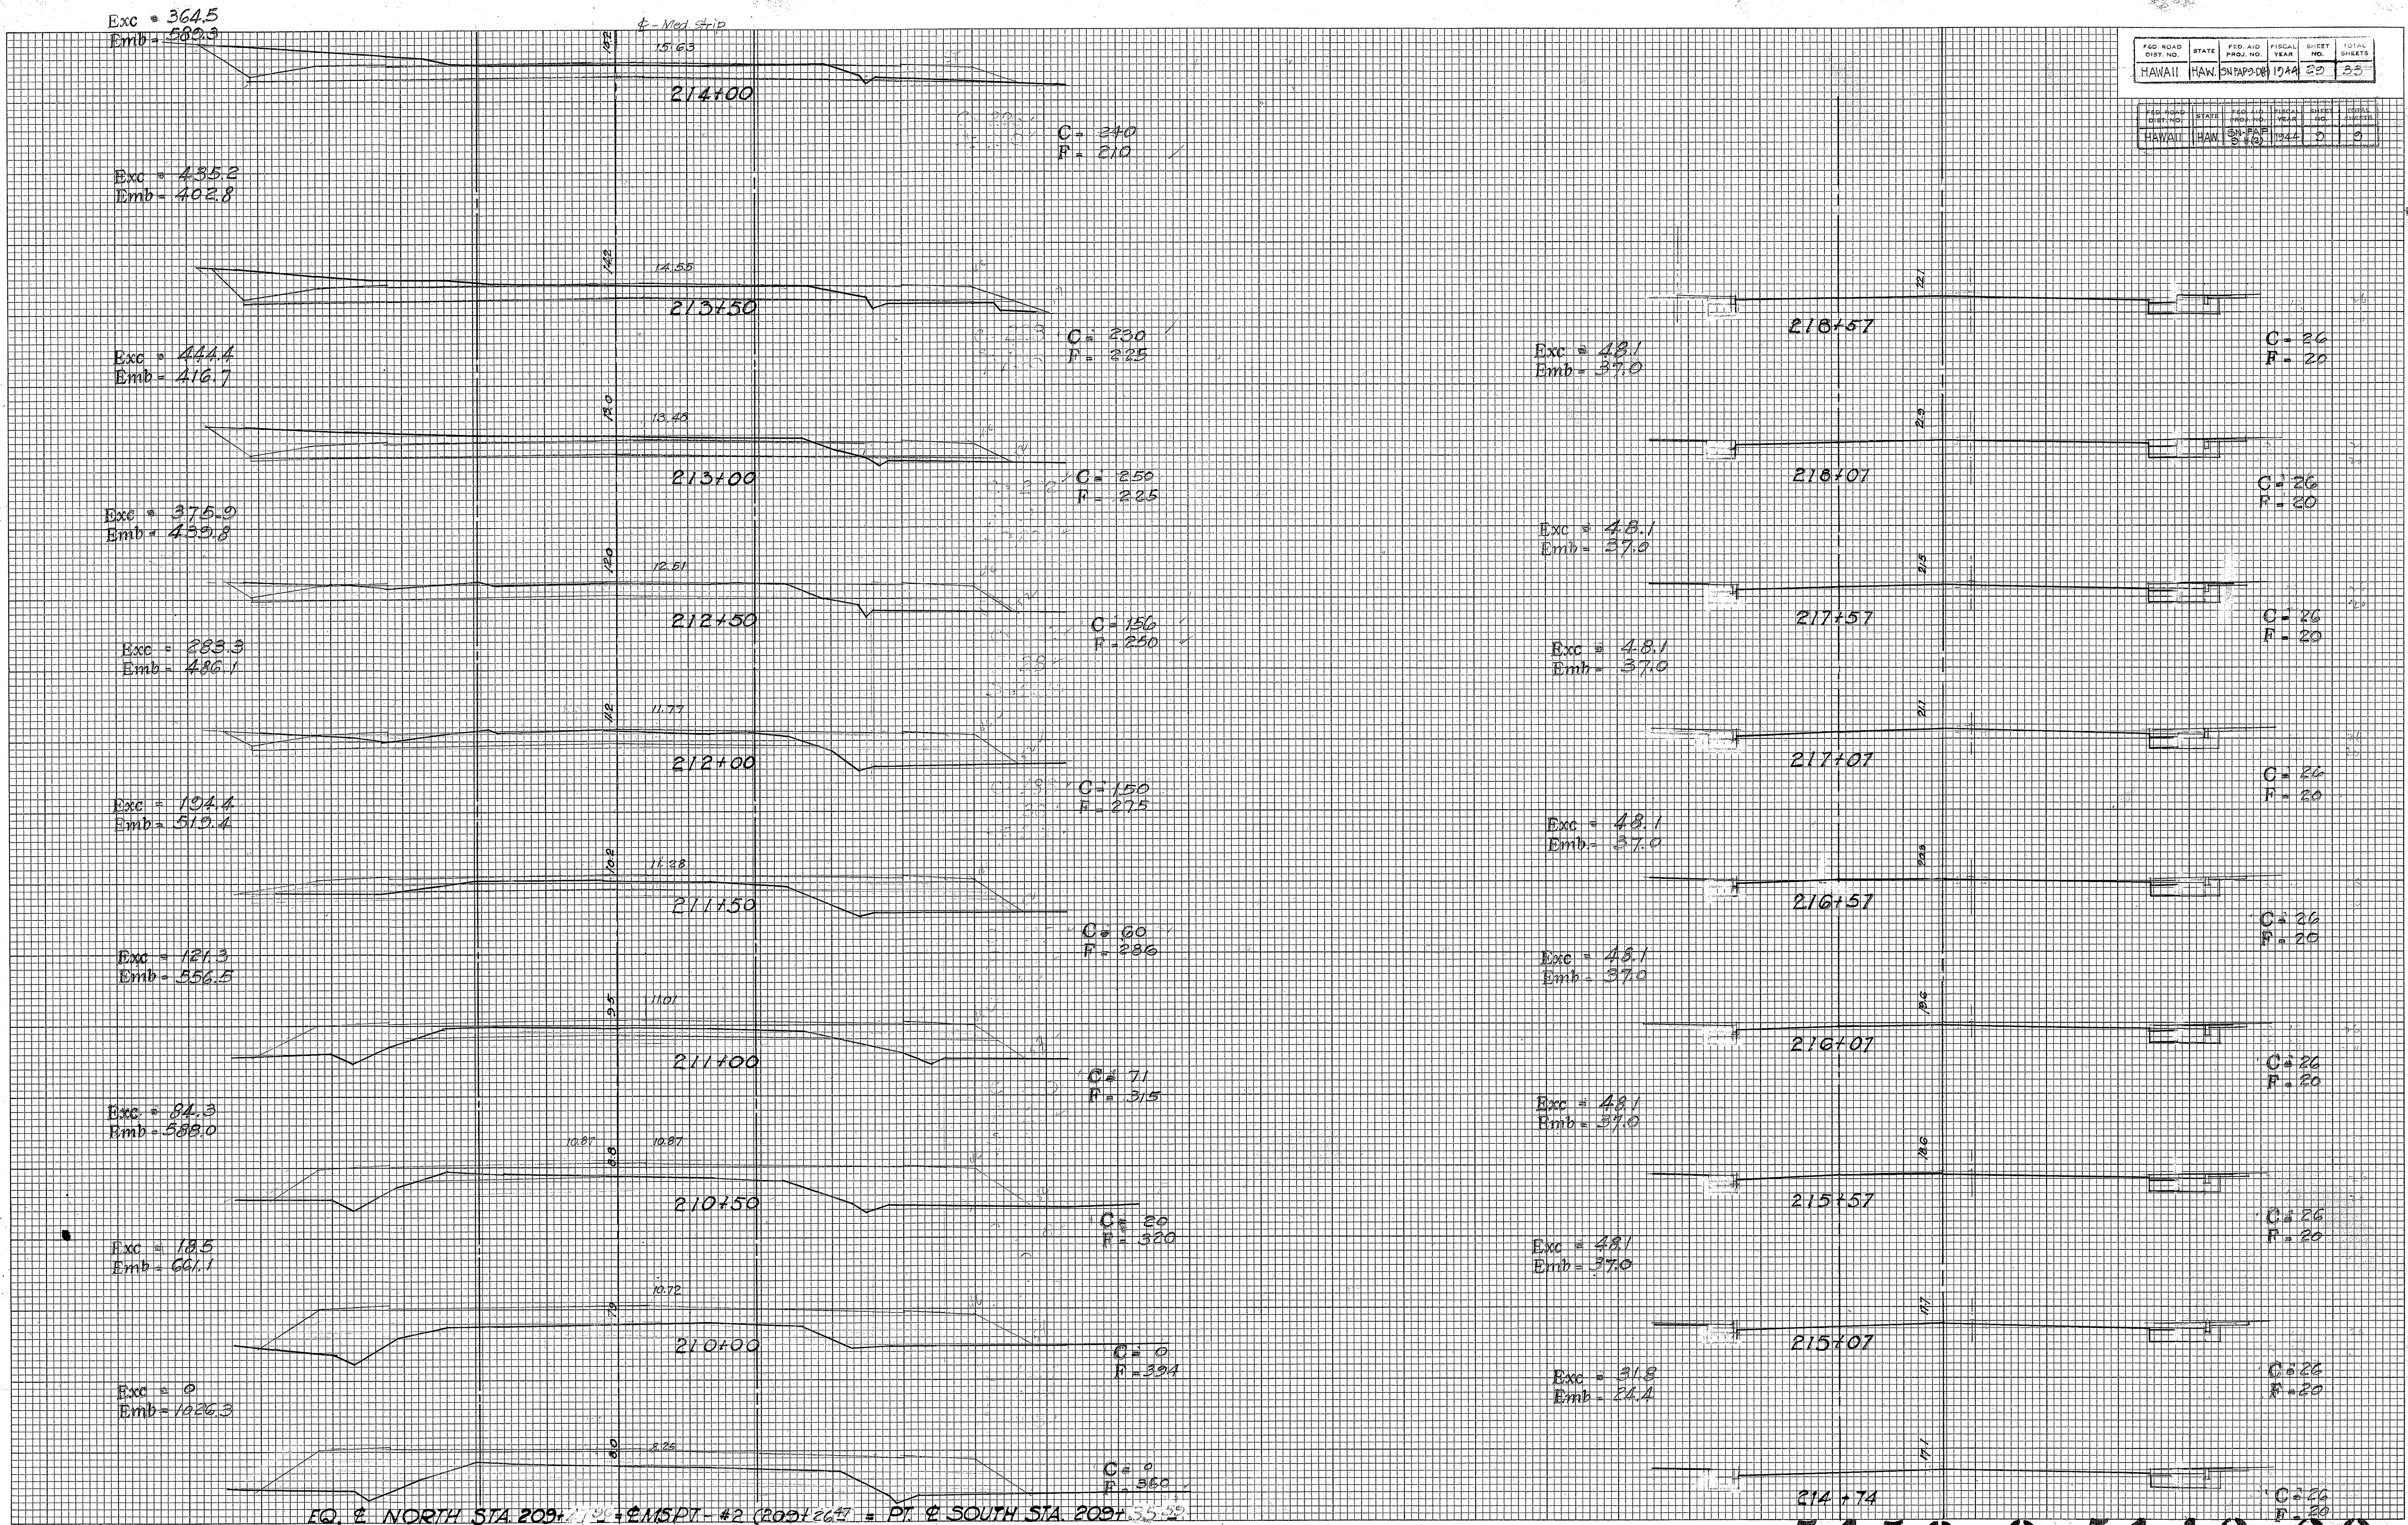

5159.9 5142.29