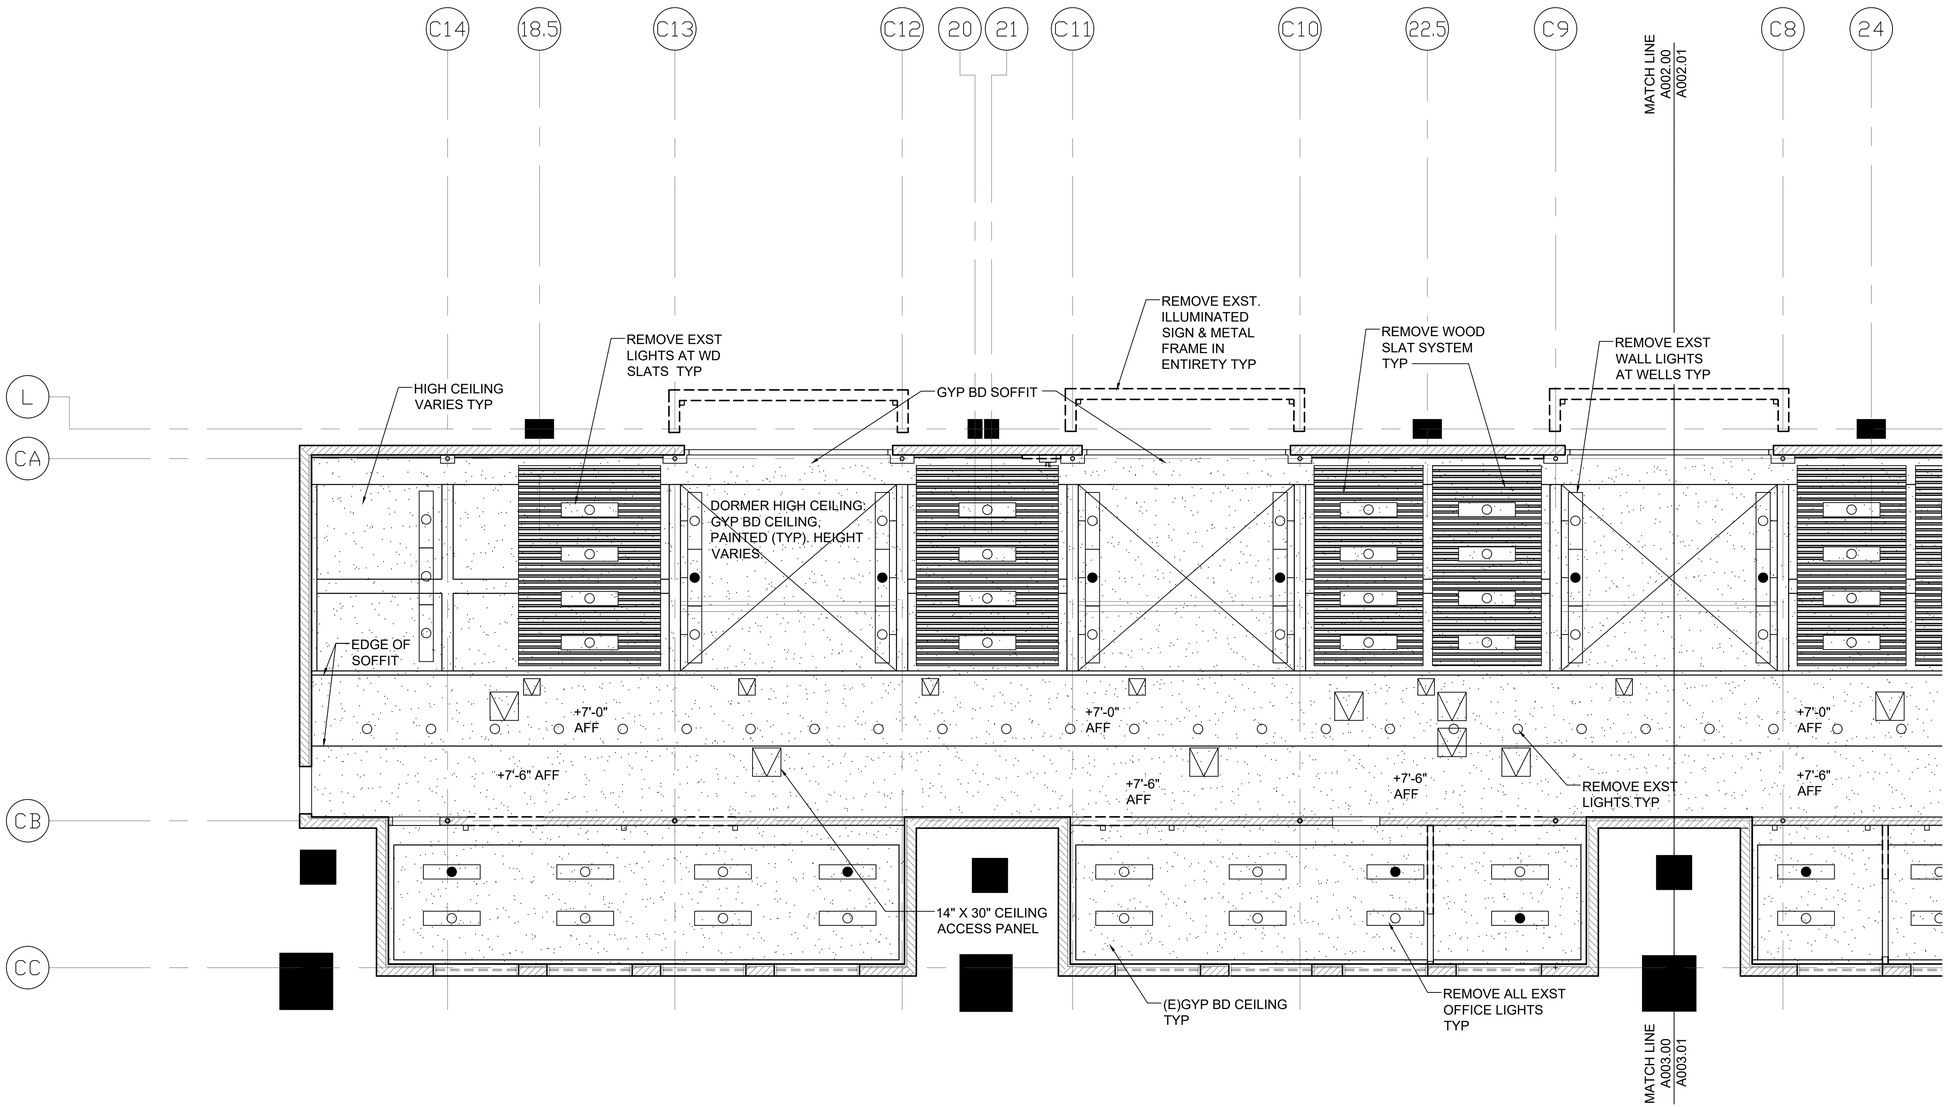

1 A003 EXISTING REFLECTED CEILING PLAN

SCALE: 3/16"= 1'-0"

1' 0 2' 4' 6' 10'

Airports Division

DEPARTMENT OF TRANSPORTATION
STATE OF HAWAII

LLOYD M. HIGA
LICENSED PROFESSIONAL ARCHITECT
No.AR-6093
HAWAII, U.S.A.

04/30/24
Licensed Expiration Date

This work was prepared by me or under my supervision.

DSGN.	DRWN.	CHKD.	APPD.

NO.	DATE	REVISIONS

DATE

PROJECT TITLE :

NEW PASS AND ID OFFICE

AT
DANIEL K. INOUYE INTERNATIONAL AIRPORT
HONOLULU, OAHU, HAWAI'I

PROJECT NO.:

CO1322-63

SHEET TITLE:

EXISTING REFLECTED CEILING PLAN

DATE :
12/21/22

SHEET :
11 OF 100 SHEETS

DWG. NO.
A003

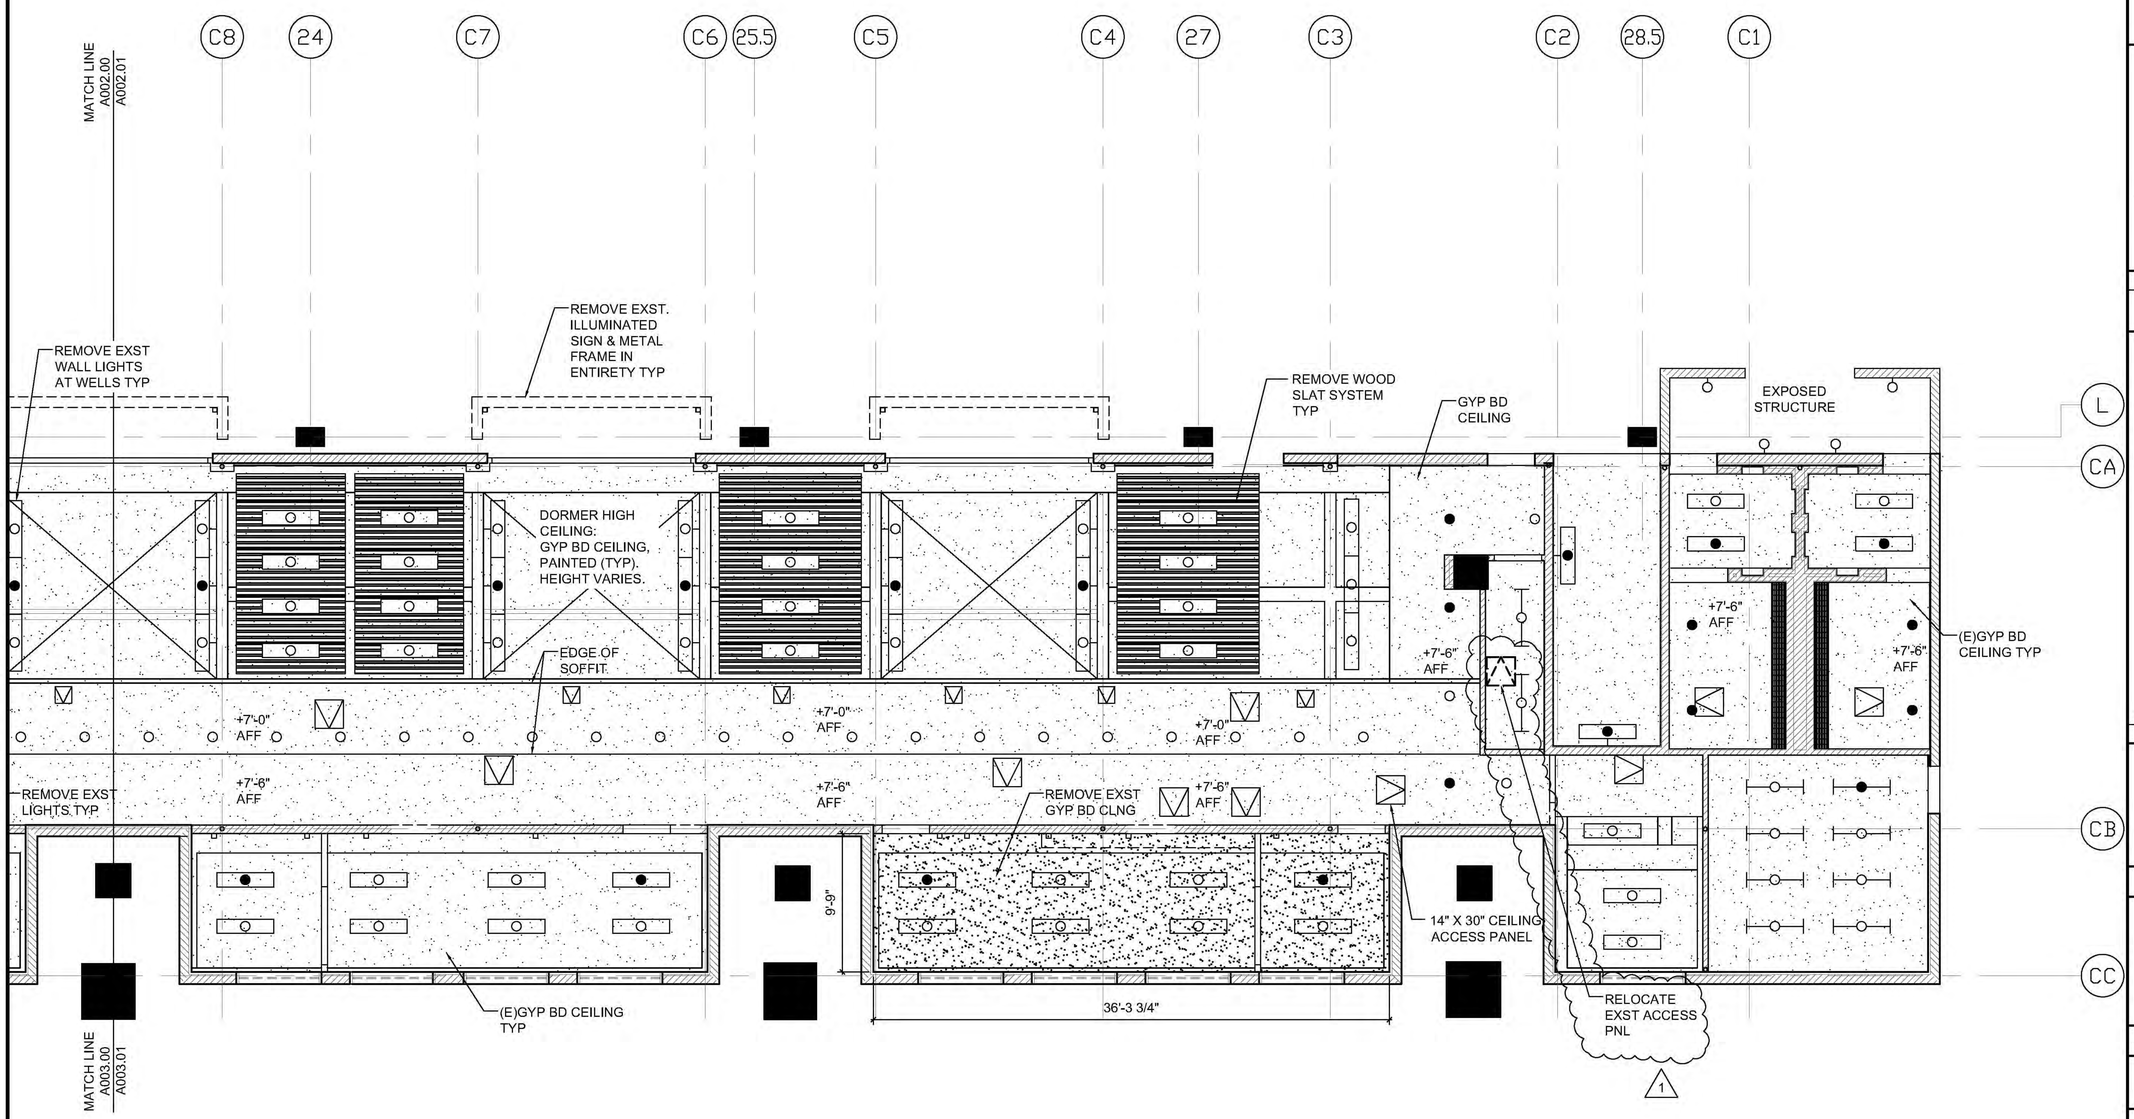

1 A003.1 EXISTING REFLECTED CEILING PLAN

SCALE: 3/16"= 1'-0"

1'0 2' 4' 6' 10'

STATE OF HAWAII 1959

Airports Division

DEPARTMENT OF TRANSPORTATION
STATE OF HAWAII

LLOYD M. HIGA
LICENSED PROFESSIONAL ARCHITECT
No.AR-6093
HAWAII, U.S.A.

04/30/24
Licensed Expiration Date

This work was prepared by me or under my supervision.

DSGN.	DRWN.	CHKD.	APPD.

NO.	DATE	REVISIONS
1	03/10/23	ADDENDUM #2

DATE

PROJECT TITLE :

NEW PASS AND ID OFFICE

AT
DANIEL K. INOUYE INTERNATIONAL AIRPORT
HONOLULU, OAHU, HAWAI'I

PROJECT NO.:

CO1322-63

SHEET TITLE:

EXISTING REFLECTED CEILING PLAN

DATE :
12/21/22

SHEET :
12 OF 100 SHEETS

DWG. NO.
A003.1