FED. ROAD DIST. NO.	STATE	FED. AID PROJ. NO.	FISCAL YEAR	SHEET NO.	TOTAL SHEETS
HAWAII	HAW				

INDEX TO DRAWINGS

SHT. NO.	DESCRIPTION
1.	Location Drawing
REPAIRS TO KALUANUI BRIDGE	
2.	Repair Details
3.	Existing Concrete Bridge Drawing
REPAIRS TO MOANALUA BRIDGE	
4.	Repair Details

STATE OF HAWAII
DEPARTMENT OF TRANSPORTATION
HIGHWAYS DIVISION

HONOLULU, HAWAII

"AS BUILT"

PLANS OF REPAIRS TO KALUANUI BRIDGE, KAMEHAMEHA HIGHWAY

DISTRICT OF KOOLAULOA, AND

PLANS OF REPAIRS TO MOANALUA BRIDGE, NIMITZ HIGHWAY

DISTRICT OF HONOLULU

PROJ. NO. BD04-021 UNIT 1

ISLAND OF OAHU

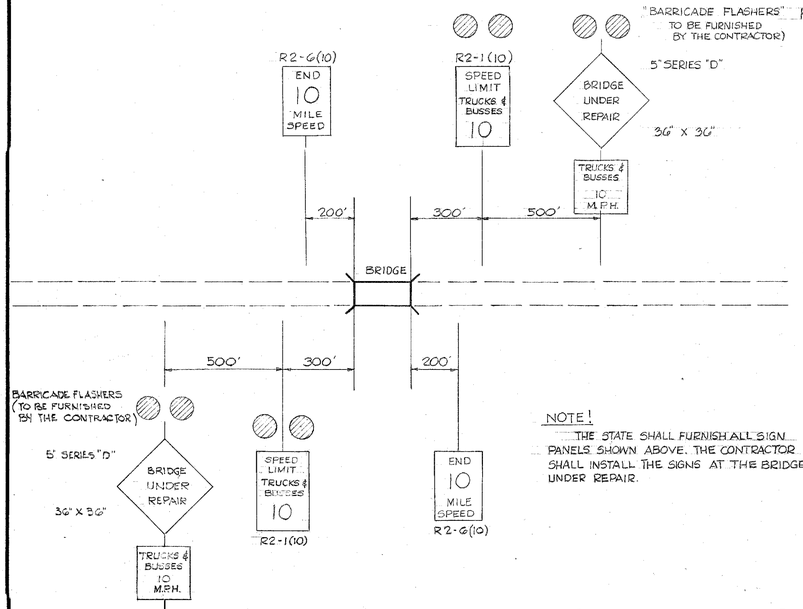

NOTE!
THE STATE SHALL FURNISH ALL SIGN PANELS SHOWN ABOVE. THE CONTRACTOR SHALL INSTALL THE SIGNS AT THE BRIDGE UNDER REPAIR.

TRAFFIC SIGN LAYOUT DURING CONSTRUCTION

FOR KALUANUI BRIDGE (NO SCALE)

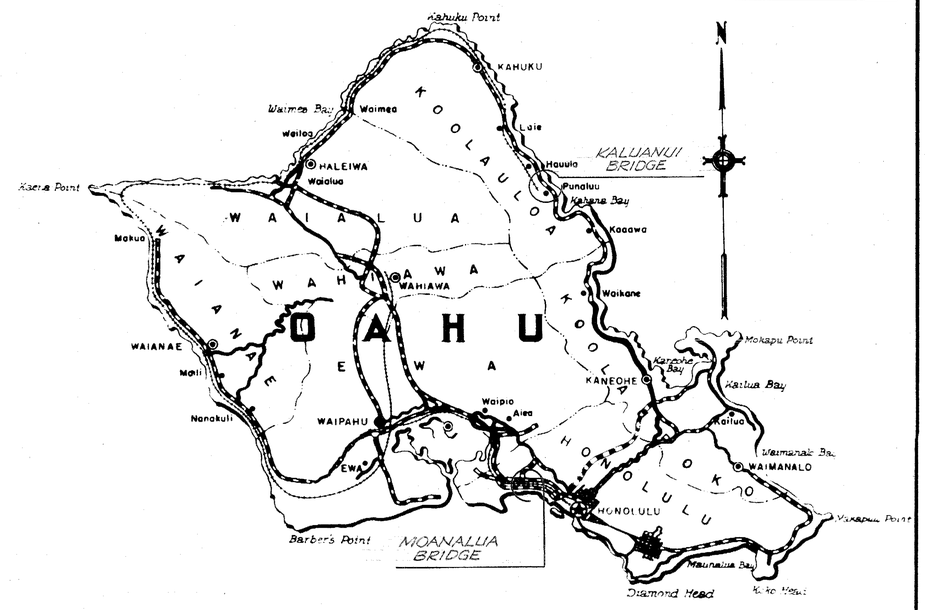

Federal Aid Projects Previously Constructed Or Under Construction

NOTE: ALL CHANGES MADE DURING CONSTRUCTION ARE SHOWN IN RED ON THESE TRACINGS AND CHECKED BY:

Ray T. Kanuha
PROJECT ENGINEER

2/28/67
DATE

APPROVED: DATE 11 Dec 66
Lujio Matsuda
DIRECTOR OF TRANSPORTATION

SHEET No. 1 OF 4 SHEETS

ORIGINAL PLAN	SURVEY PLOTTED BY	DATE
	DESIGNED BY	
	DRAWN BY	
NOTE BOOK	TRACED BY	
	QUANTITIES CHECKED BY	
No.	CHECKED BY	

D-8-4