INDEX TO DRAWINGS	
SHEET NO.	DESCRIPTION
1	TITLE SHEET
2	PLAN - KALANIANAOLE HIGHWAY
3	PLAN - LIKELIKE HIGHWAY
4 - 9	STANDARD DETAILS
10 - 11	BARRICADES

FED. ROAD DIST. NO.	STATE	FED. AID PROJ. NO.	FISCAL YEAR	SHEET NO.	TOTAL SHEETS
HAWAII	HAW.	ROS-0300(4)U2	1981	1	11

STATE OF HAWAII

DEPARTMENT OF TRANSPORTATION

HIGHWAYS DIVISION

AS - BUILT

PLANS FOR

LIKELIKE HIGHWAY

AND

KALANIANAOLE HIGHWAY

UPGRADING OF GUARD RAILS AT VARIOUS LOCATIONS

FEDERAL AID PROJECT NO. ROS-0300(4), UNIT 2

DISTRICTS OF HONOLULU AND KOOLAUPOKO

ISLAND OF OAHU

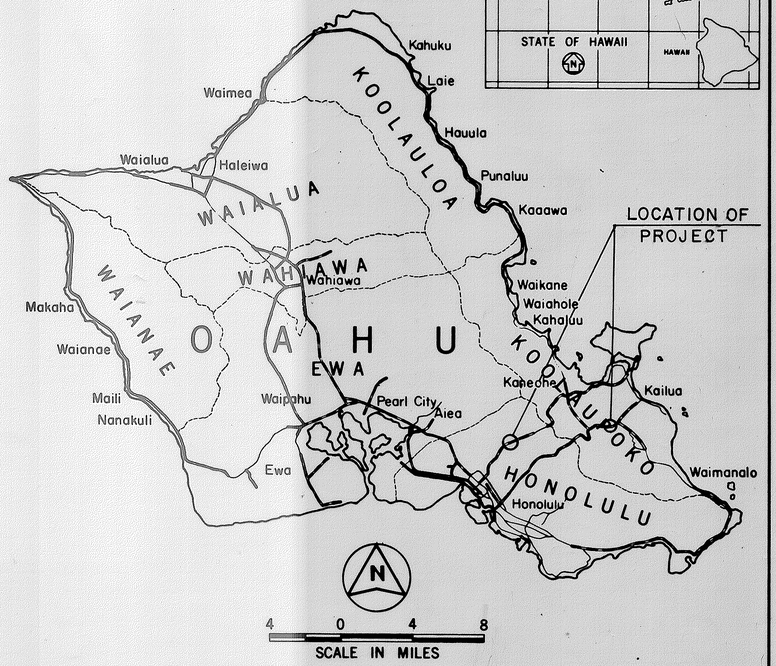

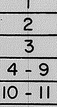

FEDERAL AID PROJECTS PREVIOUSLY CONSTRUCTED OR UNDER CONSTRUCTION

ALL CHANGES MADE DURING CONSTRUCTION HAVE BEEN INCORPORATED ON THESE PLANS EXCEPT CHANGES IN THE ORIGINAL THEORETICAL QUANTITIES.

Dan E. Clenbrights — RESIDENT ENGINEER

11-13-81 — DATE

LIKELIKE HIGHWAY DESIGN DESIGNATION

ADT (1977) 40,204
ADT (1985) 32,039
ADT (1995) 39,839
V. . . . . 45 MPH

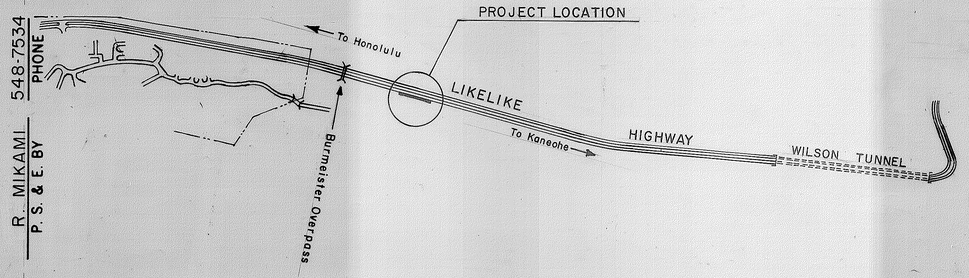

LAYOUT PLAN

SCALE IN MILES

0 1.0 2.0

2" = 1 MILE

KALANIANAOLE HIGHWAY DESIGN DESIGNATION

ADT (1979) 40,050
ADT (1999) 42,250
DHV. 4,900
D. 75/25
T. 4%
V. . . . . 45 MPH

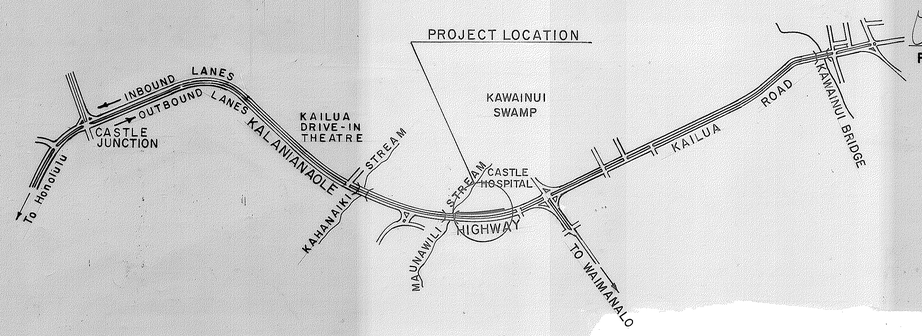

LAYOUT PLAN

SCALE IN MILES

0 0.5 1.0

4" = 1 MILE

DEPARTMENT OF TRANSPORTATION STATE OF HAWAII	
APPROVED:	
Ryoichi Higashionna	Jan 12, 81
DIR. OF TRANSPORTATION	DATE

UNIT A	
DESIGNED BY	R. MIKAMI
	P. S. & E. BY
PHONE	548-7534
DATE	1/12/81

D-5-5