FED. ROAD DIST. NO.	STATE	PROJ. NO.	FISCAL YEAR	SHEET NO.	TOTAL SHEETS
HAWAII	HAW.	83B-01-70 80B-04-70 804A-01-70	1970	1	9

INDEX TO DRAWINGS

SHEET NO.	DESCRIPTION
1	TITLE SHEET
2-6	LAYOUT PLAN
7-8	MISCELLANEOUS DETAILS
9	PROJECT INFORMATION SIGN

STATE OF HAWAII
DEPARTMENT OF TRANSPORTATION
HIGHWAYS DIVISION
HONOLULU, HAWAII

"AS BUILT" PLANS FOR

INSTALLATION OF HIGHWAY LIGHTS

ALONG KAMEHAMEHA HIGHWAY
SUNSET BEACH VICINITY
PROJECT NO. 83B-01-70
DISTRICT OF KOOLAULOA

ALONG KAMEHAMEHA HIGHWAY
WHITMORE AVENUE TO KAMANANUI ROAD AND INCLUDING WEED JUNCTION NO. 1
PROJECT NO. 80B-04-70
DISTRICT OF WAHIAWA

WHITMORE BOULEVARD STREET LIGHTS
DOLE HAY PLANT TO WHITMORE VILLAGE
PROJECT NO. 804A-01-70
DISTRICT OF WAHIAWA

ISLAND OF OAHU

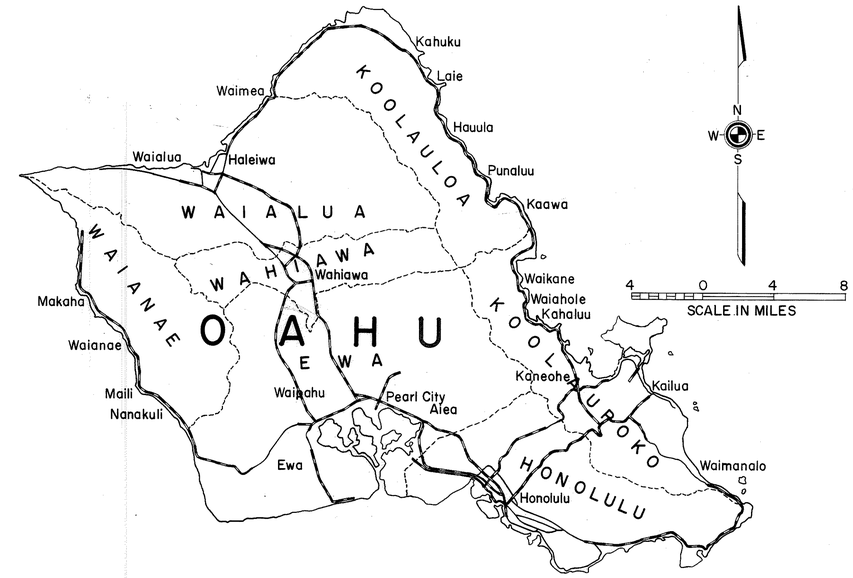

Federal Aid Projects Previously Constructed or Under Construction

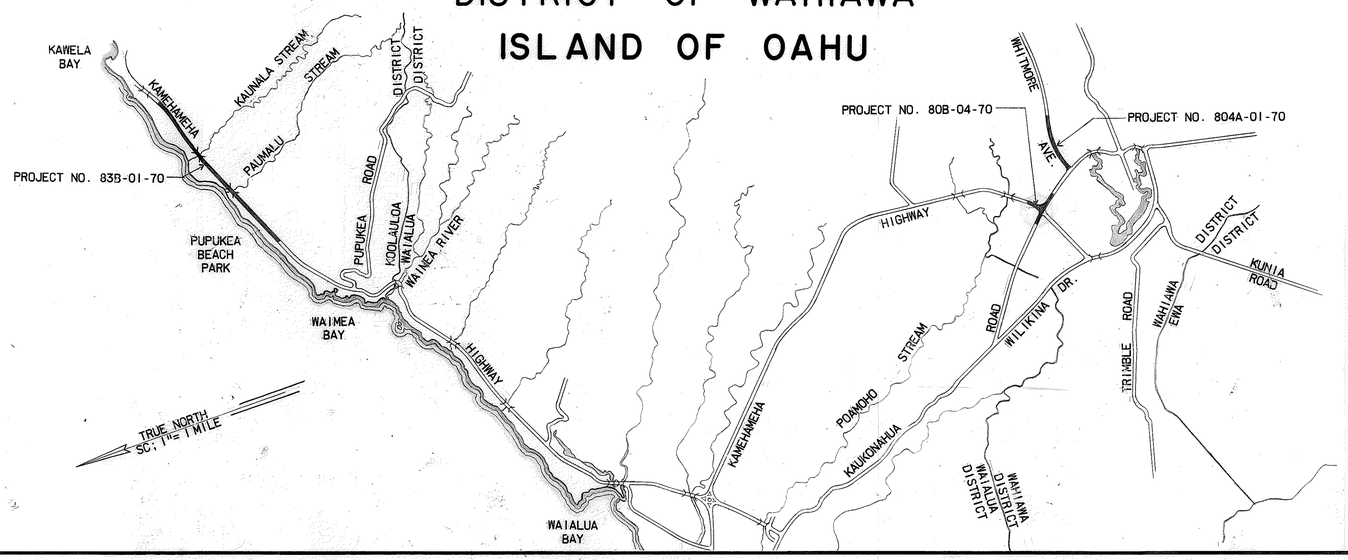

NOTE:

ALL CHANGES MADE DURING CONSTRUCTION HAVE BEEN NOTED IN RED ON THESE TRACINGS AND CHECKED BY:

Albert S. C. Chong
PROJECT ENGINEER

Oct. 11, 1972
DATE

ALBERT S. C. CHONG
REGISTERED PROFESSIONAL ENGINEER
No. 1003
HAWAII, U.S.A.

THIS WORK WAS PREPARED BY ME OR UNDER MY SUPERVISION
Albert S. C. Chong
Albert S. C. Chong, PE

DEPARTMENT OF TRANSPORTATION
STATE OF HAWAII
APPROVED:
E. Alvey Wright 12/31/70
for DIR. OF TRANSPORTATION DATE

L. Char January, 1971

D-4-2