FED. ROAD DIST. NO.	STATE	FED. AID PROJ. NO.	FISCAL YEAR	SHEET NO.	TOTAL SHEETS
HAWAII	HAW.	F9(34) 3rd Unit	1950	1	4

TERRITORY OF HAWAII
TERRITORIAL HIGHWAY DEPARTMENT
HONOLULU, OAHU, T. H.

PLANS OF
INSTALLATION OF TRAFFIC CONTROL SIGNALS
AT INTERSECTION OF
FEDERAL AID ROUTE NO. 1
AT
PEARL HARBOR JUNCTION
FEDERAL AID PROJECT NO. F 9 (34) 3RD UNIT
DISTRICT OF HONOLULU
ISLAND OF OAHU

INDEX TO DRAWINGS

SHEET NO.	DESCRIPTION
1	Title Sheet
2	Layout Plan
3	Wiring Diagram
4	Misc. Details

CONVENTIONAL SIGNS

Centerline
Boundary Lines
Fences (Named)
Existing Roadways
Circular Culvert
Box Culvert
Bridge
Telephone Pole
Electric Power Pole
Water Main
Storm Drain
Concrete Drop Intake
Standard Catch Basin
Standard Manhole
Sewer Manhole
Telephone Manhole
Fire Hydrant
Tree (Large, named)
Railroad

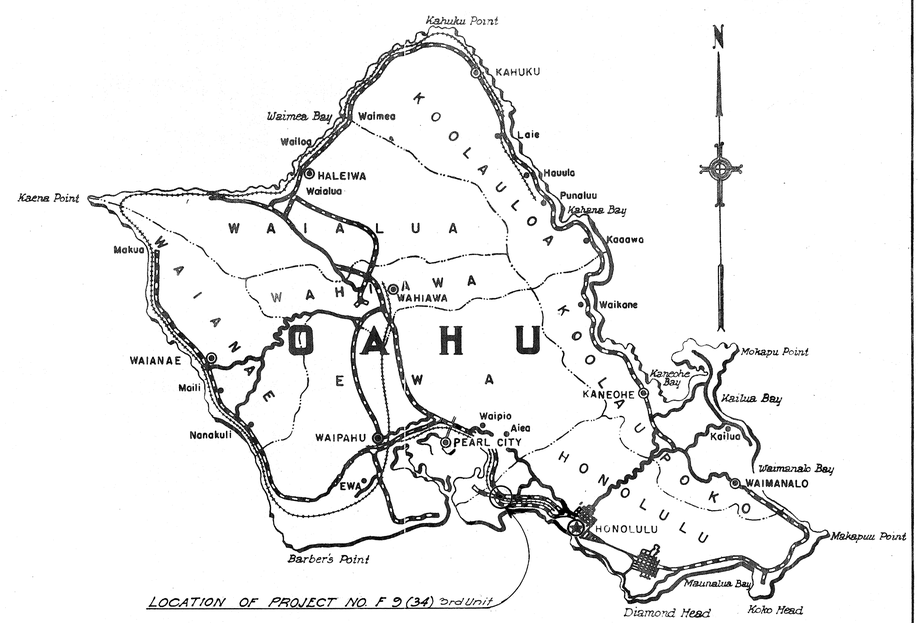

LOCATION OF PROJECT NO. F 9 (34) 3rd Unit

Federal Aid Projects Previously Constructed Or Under Construction

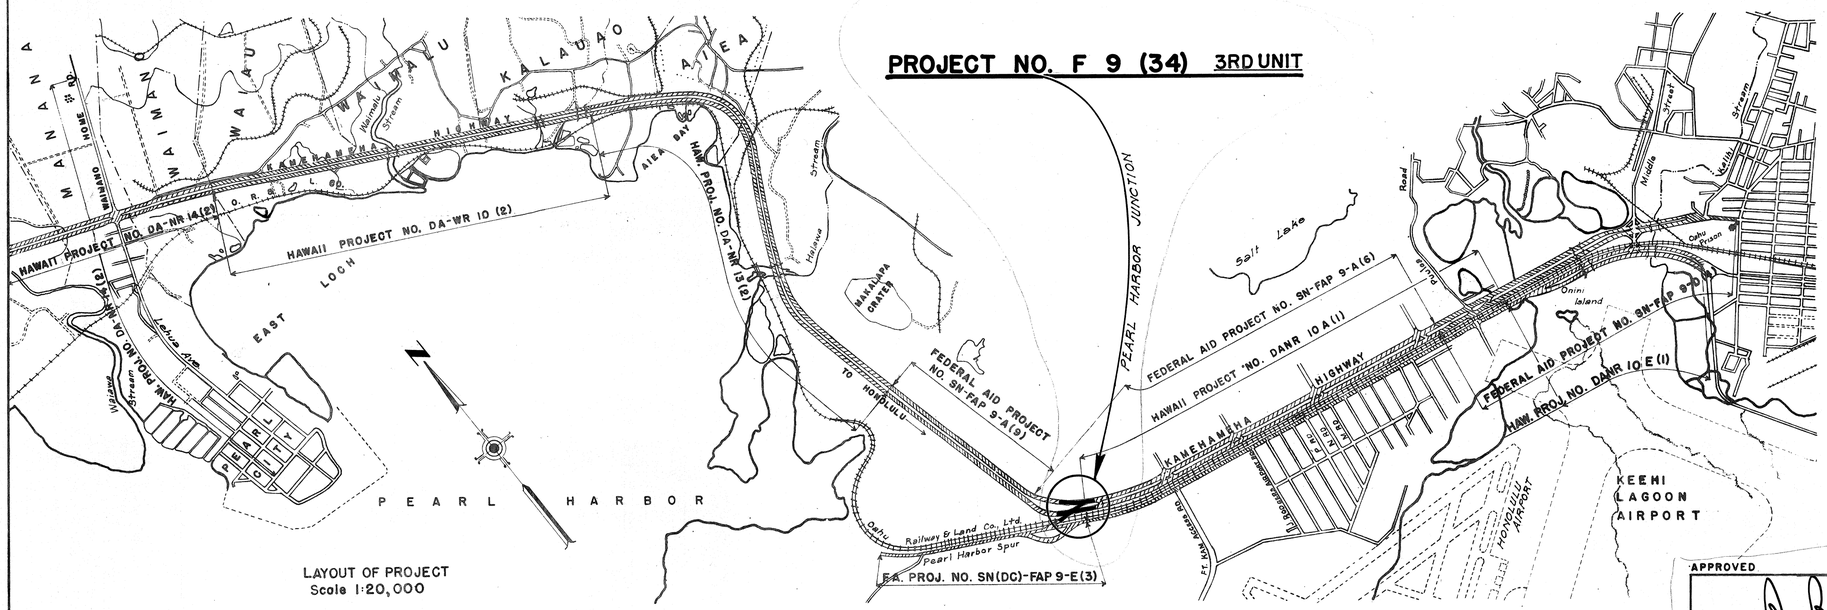

LAYOUT OF PROJECT
Scale 1:20,000

Note: All changes made during construction are shown in red ink.

Contract was completed by Arada Electric Co. on Sept. 11, 1950

L. C. Pitts
Section Engineer
Hwy.

ORIGINAL PLAN	SURVEY PLOTTED BY	DATE
	TRACED BY	
	DRAWN BY	
NOTE BOOK	TYPE OF PLAN	
	QUANTITIES CHECKED BY	
No.	CHECKED BY	

APPROVED DATE 6-10-50
TERRITORIAL HIGHWAY ENGINEER

DEPARTMENT OF COMMERCE
BUREAU OF PUBLIC ROADS
RECOMMENDED FOR APPROVAL:
[redacted] [redacted]
DISTRICT ENGINEER DATE
APPROVED:
[redacted] [redacted]
DIVISION ENGINEER DATE

5490.1