FED. ROAD DIST. NO.	STATE	PROJ. NO.	FISCAL YEAR	SHEET NO.	TOTAL SHEETS
HAWAII	HAW.	HWY-0-01-72	1972	41	43

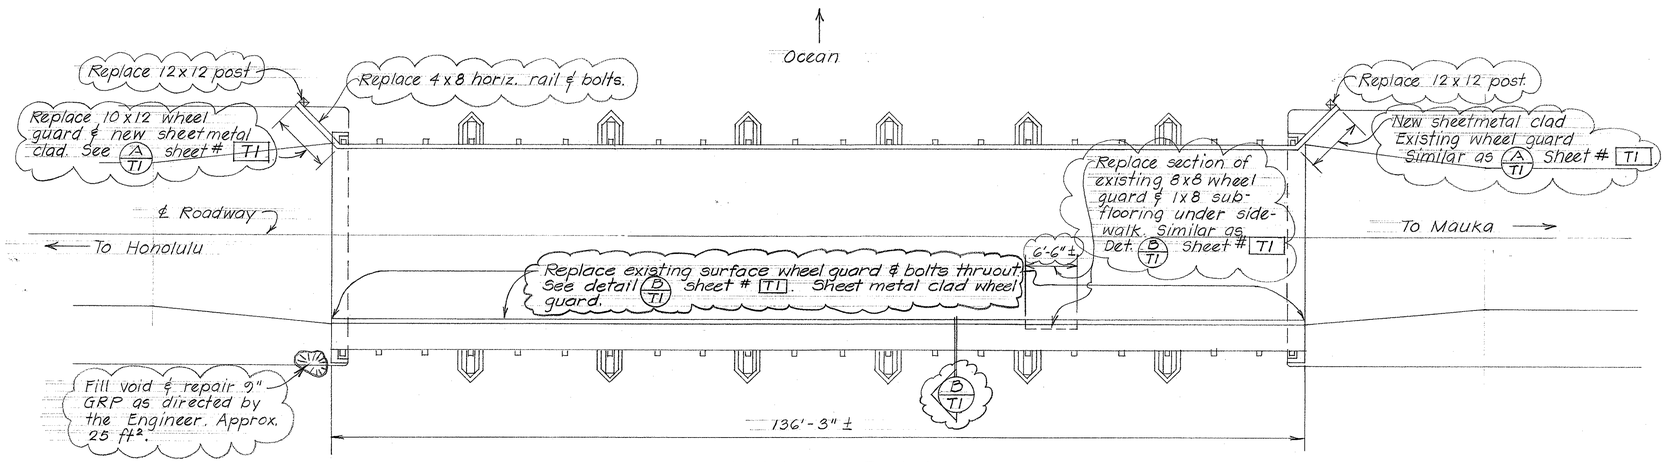

LAYOUT PLAN

ITEMS OF REPAIR AND ESTIMATED QUANTITIES

ITEM Nº	DESCRIPTION	UNIT	QUANTITY
~~649.15~~	~~Timber for repairs or rehabilitation of Makaha Bridge #4~~	~~MFBM~~	~~0.95~~
649.25	Preservative treatment of Makaha Bridge #4	L.S.	Lump Sum
649.35	Painting of Makaha Bridge #4	L.S.	Lump Sum
~~612.14~~	~~Grouted rubble paving (repairs) for Makaha Bridge #4~~	~~S.F.~~	~~1.0~~

NOTE: Refer to Typical Detail sheet # T-1 for notes and additional details.

STATE OF HAWAII
DEPARTMENT OF TRANSPORTATION
HIGHWAYS DIVISION

REHABILITATION & REPAIRS TO EXISTING MAKAHA #4

PROJ. Nº HWY-0-01-72 NOV., 1971

SHEET No. / OF / SHEETS

41 1

ORIGINAL PLAN	SURVEY PLOTTED BY	DATE
	DRAWN BY	"
	TRACED BY	"
NOTE BOOK	DESIGNED BY	"
	QUANTITIES BY	"
No.	CHECKED BY	"

PRINTED ON NO. 1000H CLEARPRINT