FED. ROAD DIST. NO.	STATE	FED. AID PROJ. NO.	FISCAL YEAR	SHEET NO.	TOTAL SHEETS
HAWAII	HAW.	I-H1-1(143):15	1976	7	11

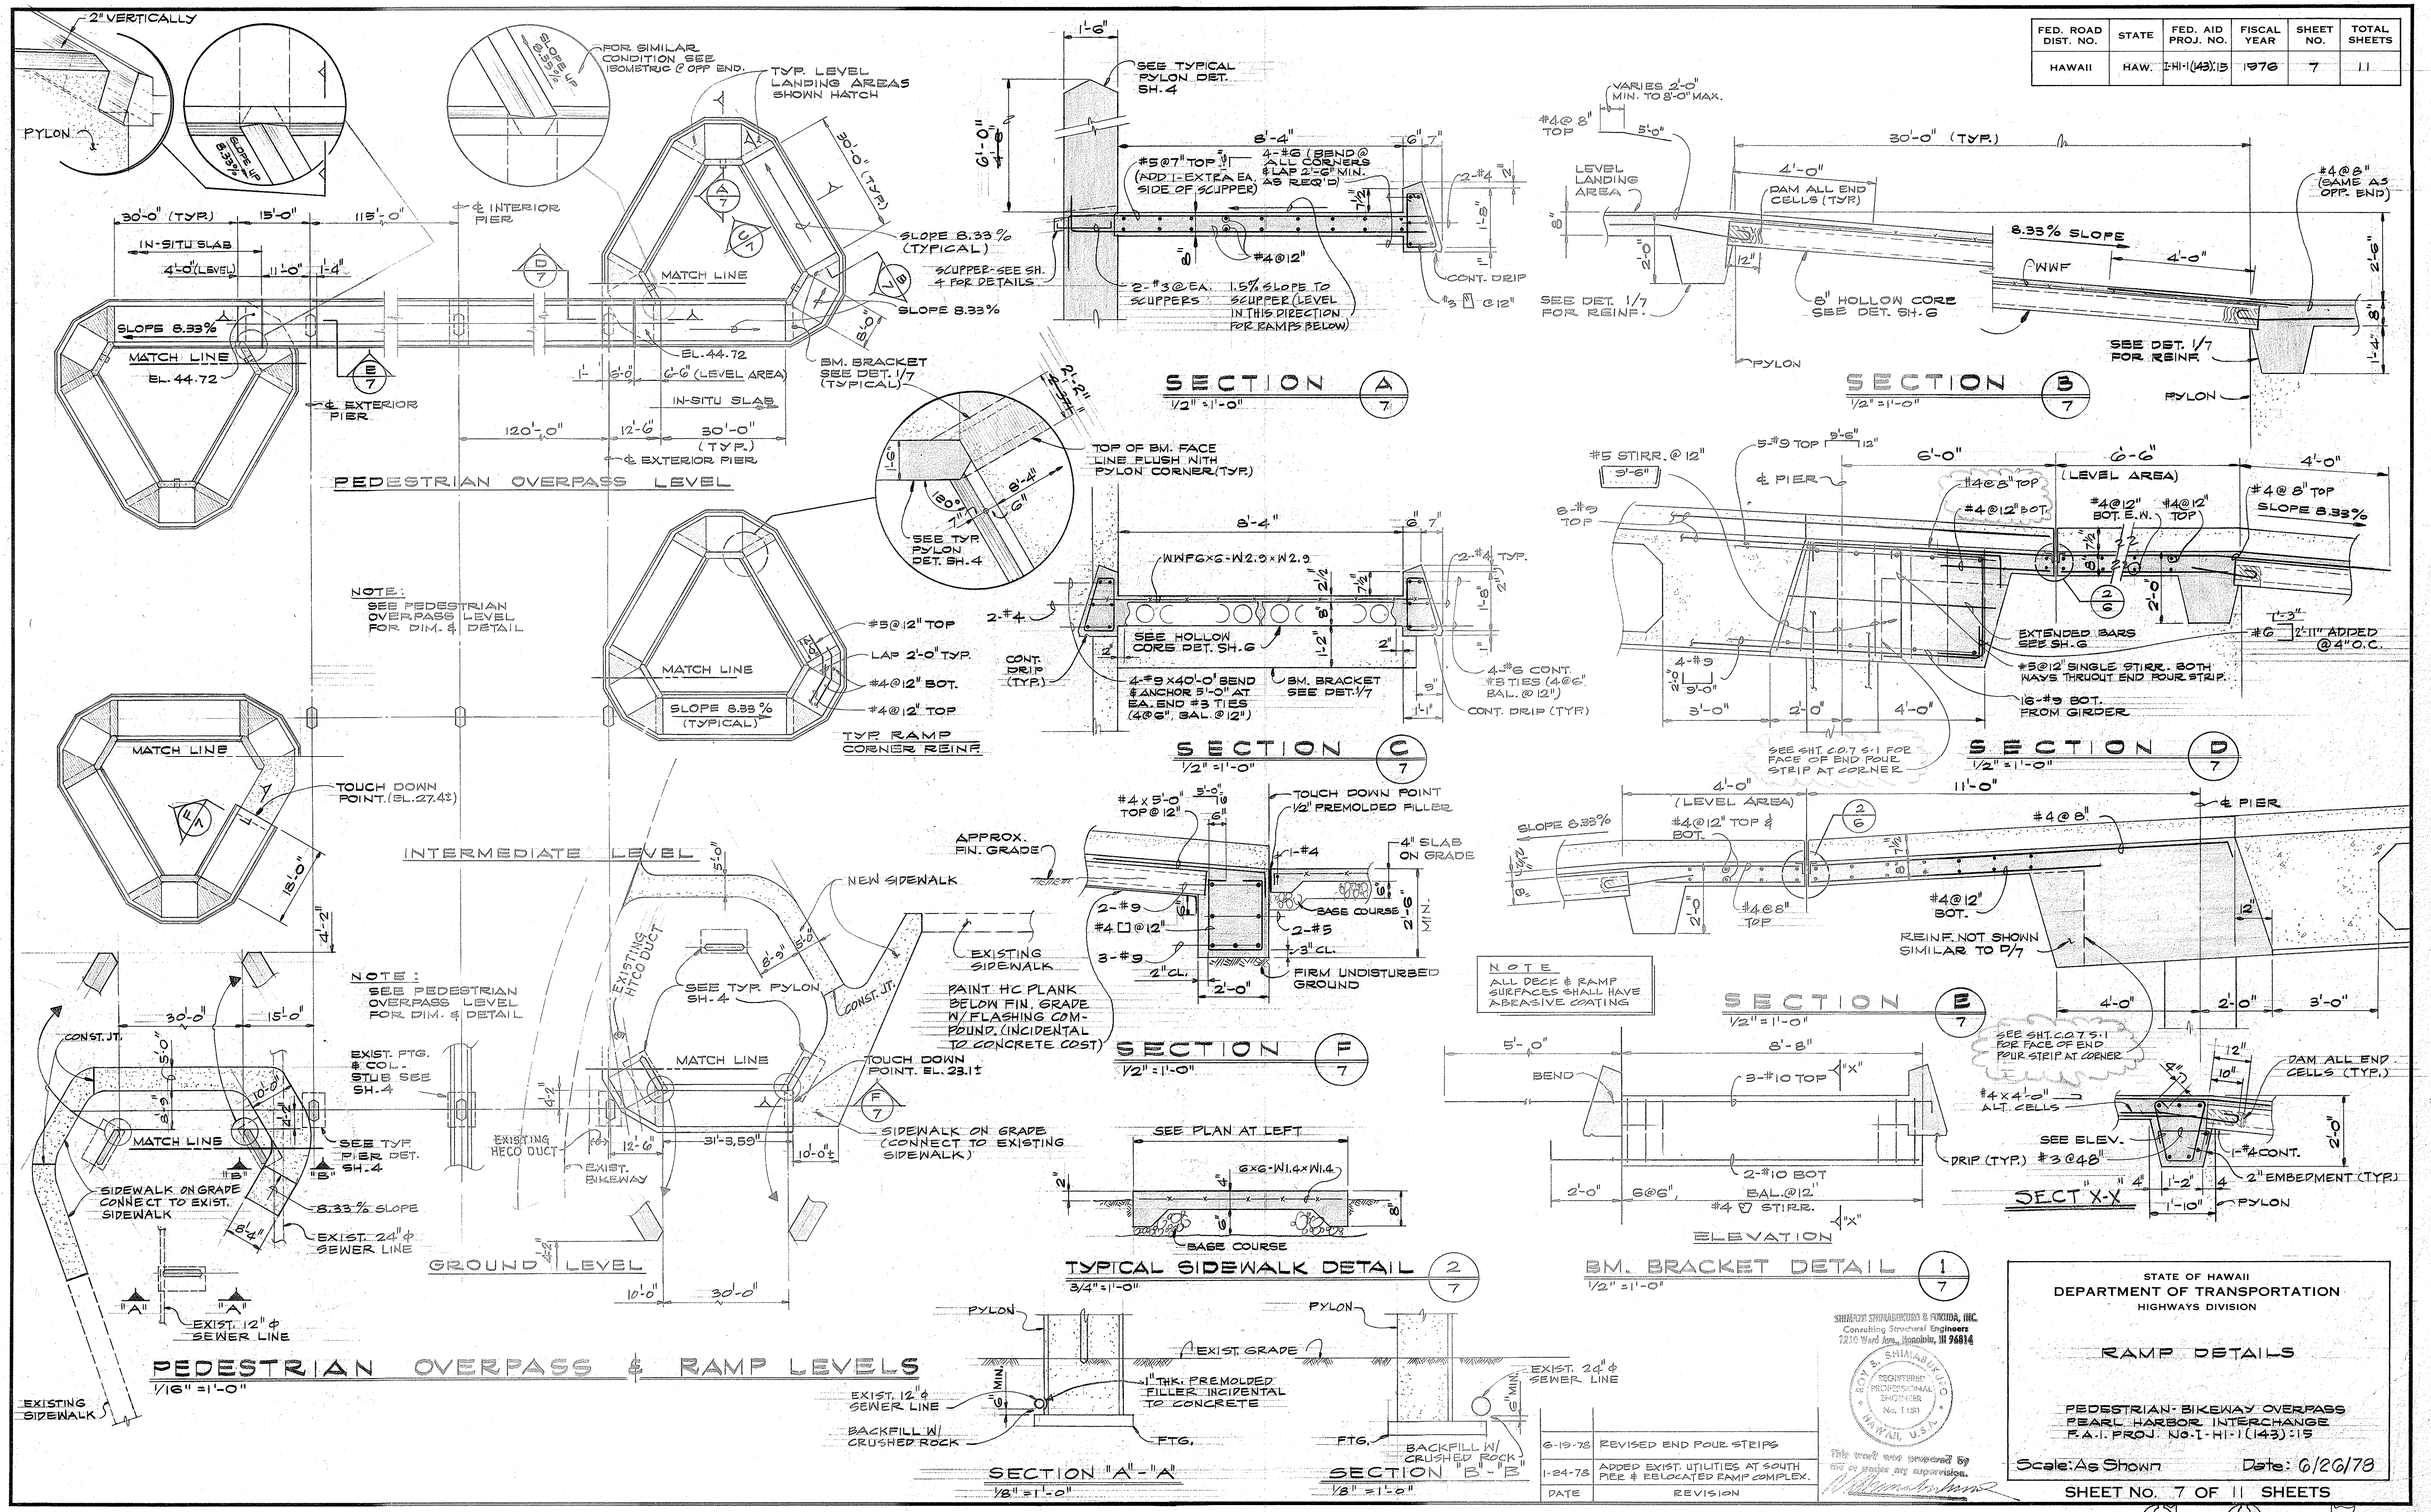

DATE	REVISION
6-19-78	REVISED END POUR STRIPS
1-24-78	ADDED EXIST. UTILITIES AT SOUTH PIER & RELOCATED RAMP COMPLEX.

SHIMAZU STRUCTURES & FURUTA, INC.
Consulting Structural Engineers
1210 Ward Ave., Honolulu, HI 96814

REGISTERED PROFESSIONAL ENGINEER No. 1150 HAWAII, U.S.A.

This work was prepared by me or under my supervision.

STATE OF HAWAII
DEPARTMENT OF TRANSPORTATION
HIGHWAYS DIVISION

RAMP DETAILS

PEDESTRIAN-BIKEWAY OVERPASS
PEARL HARBOR INTERCHANGE
F.A.I. PROJ. NO. I-H1-1(143):15

Scale: As Shown Date: 6/26/78

SHEET No. 7 OF 11 SHEETS

ORIGINAL PLAN		DATE
	SURVEY PLOTTED BY	
	DRAWN BY	
	TRACED BY	
	DESIGNED BY	
NOTE BOOK	QUANTITIES BY	
No.	CHECKED BY	

PRINTED ON NO. 1000H CLEARPRINT