FED. ROAD DIST. NO.	STATE	FED. AID PROJ. NO.	FISCAL YEAR	SHEET NO.	TOTAL SHEETS
HAWAII	HAW.	I-HI-1(172)16	1981	1	24

INDEX TO DRAWINGS

SHEET NO.	DESCRIPTION
T-1	TITLE SHEET
L-1 to L-8	DRIP SYSTEM
L-9	IRRIGATION, LEGEND & NOTES
L-10	IRRIGATION DETAILS
L-11 to L-13	SPRINKLER SUMMARY
L-14 to L-17	PAVING & EARTH WORK
L-18	PAVING & EARTH WORK DETAILS
L-19 to L-22	PLANTING PLANS
L-23	PLANTING DETAILS

STATE OF HAWAII

DEPARTMENT OF TRANSPORTATION
HIGHWAYS DIVISION

HONOLULU, HAWAII

"AS BUILT"
PLANS FOR
CONSTRUCTION OF A PORTION OF

INTERSTATE ROUTE H-1

AIRPORT INTERCHANGE
ROADWAY LANDSCAPING
FEDERAL AID INTERSTATE PROJECT I-HI-1(172):16

DISTRICT OF HONOLULU
ISLAND OF OAHU

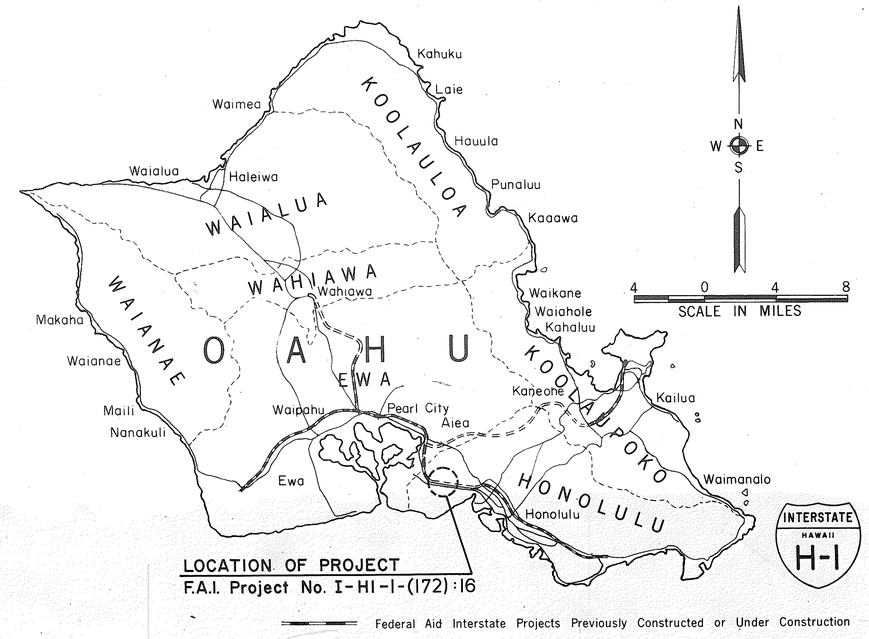

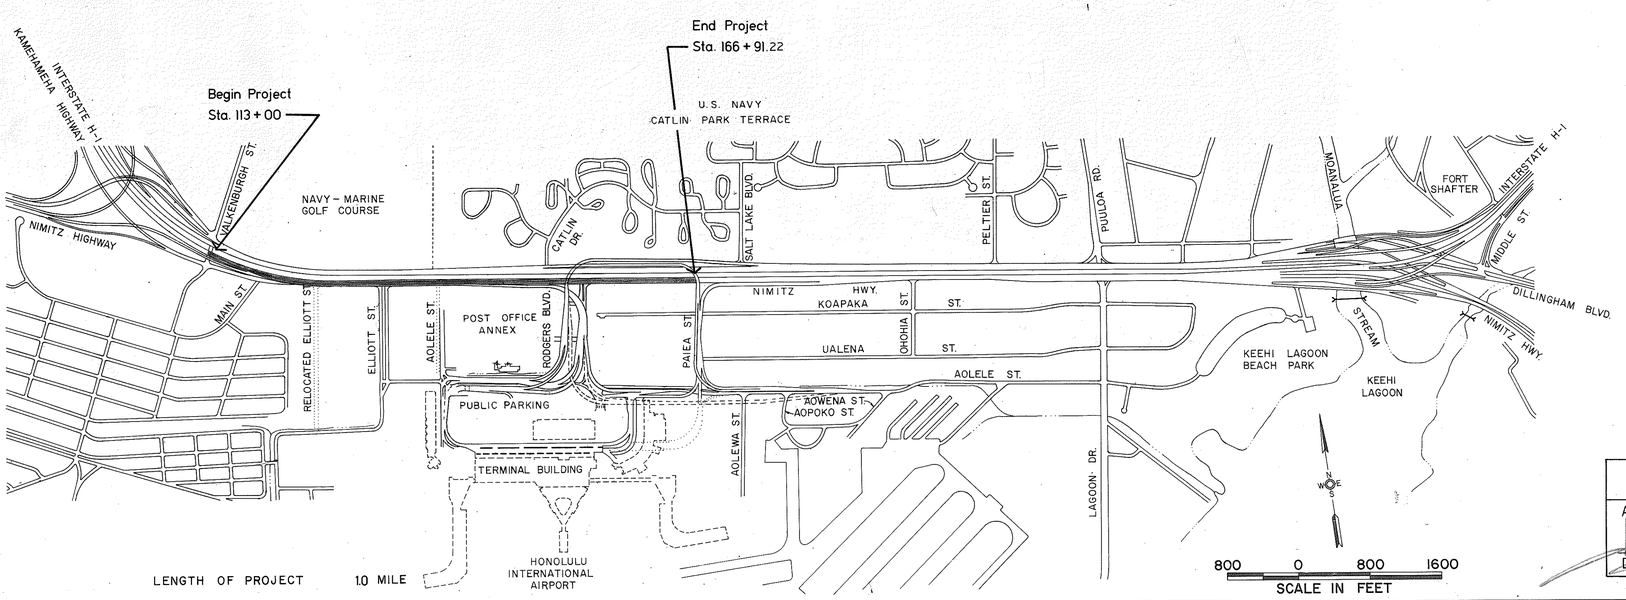

LENGTH OF PROJECT 1.0 MILE

CHANGES MADE DURING CONSTRUCTION HAVE BEEN INCORPORATED ON THESE PLANS EXCEPT CHANGES IN THE ORIGINAL THEORETICAL QUANTITIES. FOR ACTUAL QUANTITIES, REFER TO PROJECT LEDGER AND/OR COMPUTATION BOOK.

Robert Y. Muronaka 7/25/84
RESIDENT ENGINEER DATE

DEPARTMENT OF TRANSPORTATION FEDERAL HIGHWAY ADMINISTRATION	
APPROVED:	
DIVISION ADMINISTRATOR	9.28.81 DATE

DEPARTMENT OF TRANSPORTATION STATE OF HAWAII	
APPROVED:	
DIR. OF TRANSPORTATION	9/28/81 DATE