FED. ROAD DIST. NO.	STATE	FED. AID PROJ. NO.	FISCAL YEAR	SHEET NO.	TOTAL SHEETS
HAWAII	HAW.	I-HI-1(164):16	1981	1	30

INDEX TO DRAWINGS

SHEET NO.	DESCRIPTION
T-1	TITLE SHEET
L-1 to L-6	IRRIGATION PLANS
L-7 to L-10	DRIP IRRIGATION PLANS
L-11	IRRIGATION LEGEND & DETAILS
L-12	IRRIGATION DETAILS
L-13 to L-14	SPRINKLER SUMMARY
L-15 to L-21	PAVING & EARTHWORK PLANS
L-22	PAVING DETAILS
L-23 to L-28	PLANTING PLANS
L-29	PLANTING LIST DETAILS

STATE OF HAWAII

DEPARTMENT OF TRANSPORTATION
HIGHWAYS DIVISION

HONOLULU, HAWAII

"AS BUILT"

PLANS FOR

CONSTRUCTION OF A PORTION OF

INTERSTATE ROUTE H-1

AIRPORT INTERCHANGE
ROADWAY LANDSCAPING
FEDERAL AID INTERSTATE PROJECT I-HI-1(164):16

DISTRICT OF HONOLULU
ISLAND OF OAHU

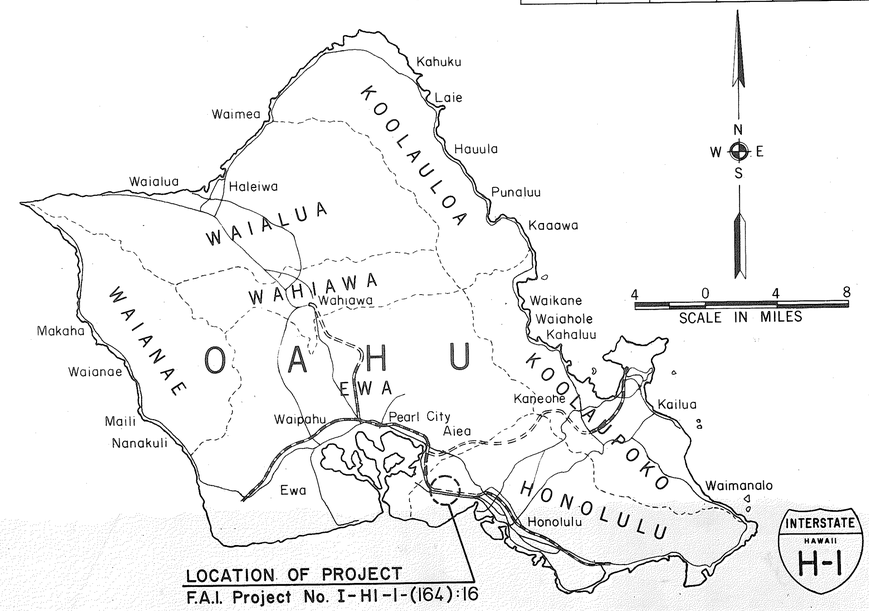

CHANGES MADE DURING CONSTRUCTION HAVE BEEN INCORPORATED ON THESE PLANS EXCEPT CHANGES IN THE ORIGINAL THEORETICAL QUANTITIES. FOR ACTUAL QUANTITIES, REFER TO PROJECT LEDGER AND/OR COMPUTATION BOOK.

Robert J. Munnake — 9-25-84
RESIDENT ENGINEER — DATE

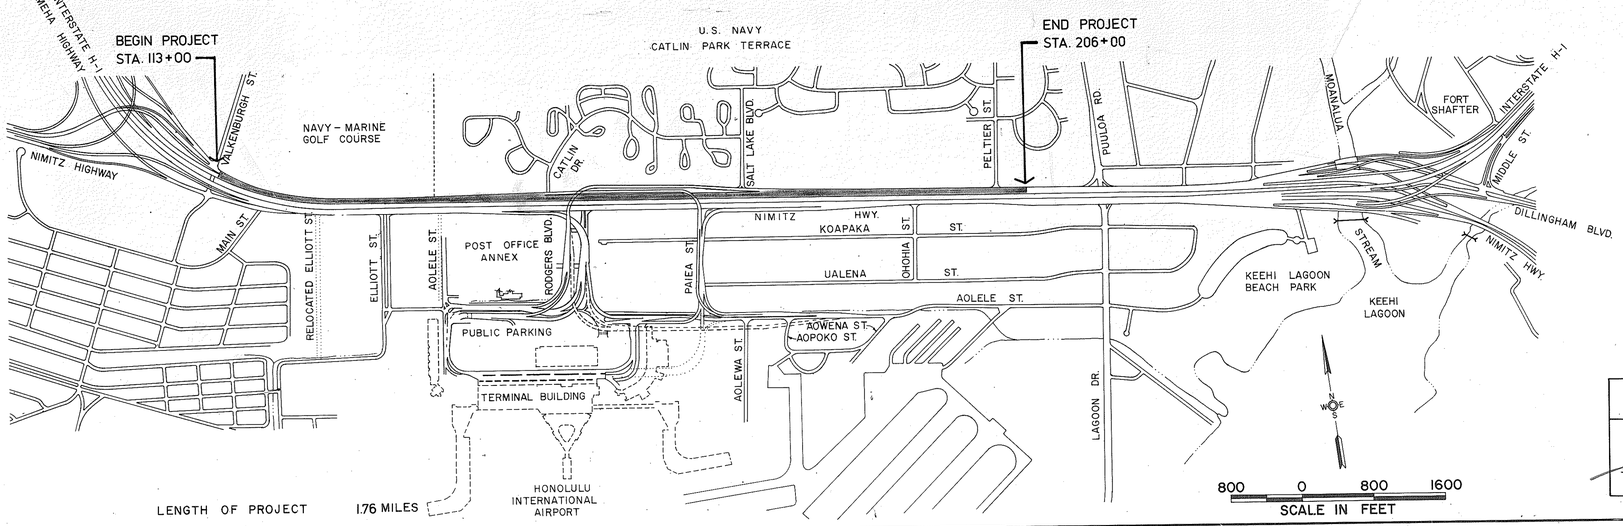

DEPARTMENT OF TRANSPORTATION FEDERAL HIGHWAY ADMINISTRATION	
APPROVED:	
DIVISION ADMINISTRATOR	9-28-84 DATE

DEPARTMENT OF TRANSPORTATION STATE OF HAWAII	
APPROVED:	
DIR. OF TRANSPORTATION	9/26/84 DATE

C-6-1

DD-C-6-1