FED. ROAD DIST. NO.	STATE	FED. AID PROJ. NO.	FISCAL YEAR	SHEET NO.	TOTAL SHEETS
HAWAII	HAW.	I-IR-H1-(173)-16	1982	1	22

INDEX TO DRAWINGS

SHEET NO.	DESCRIPTION
1	TITLE SHEET
2	PARTIAL IRRIGATION & WIRING DIA.
3	PARTIAL IRRIGATION & WATERING SCHED.
4	PARTIAL IRRIGATION
5	PARTIAL IRRIGATION
6	PARTIAL DRIP IRRIGATION
7	PARTIAL DRIP IRRIGATION
8	PARTIAL DRIP IRRIGATION
9	PARTIAL DRIP IRRIGATION
10	IRRIGATION LEGEND & DETAILS
11	IRRIGATION DETAILS
12	SUMMARY SHEET
13	PAVING & EARTHWORK
14	PAVING & EARTHWORK
15	PAVING & EARTHWORK
16	PAVING & EARTHWORK
17	PAVING & EARTHWORK DETAILS
18	PARTIAL PLANTING
19	PARTIAL PLANTING
20	PARTIAL PLANTING
21	PARTIAL PLANTING
22	PLANT LIST & DETAILS

STATE OF HAWAII

DEPARTMENT OF TRANSPORTATION
HIGHWAYS DIVISION

HONOLULU, HAWAII

"AS BUILT"
PLANS FOR

CONSTRUCTION OF A PORTION OF

INTERSTATE ROUTE H-1

AIRPORT INTERCHANGE
ROADWAY EROSION CONTROL AND LANDSCAPING

FEDERAL AID INTERSTATE PROJECT I-IR-H1-1(173):16

DISTRICT OF HONOLULU
ISLAND OF OAHU

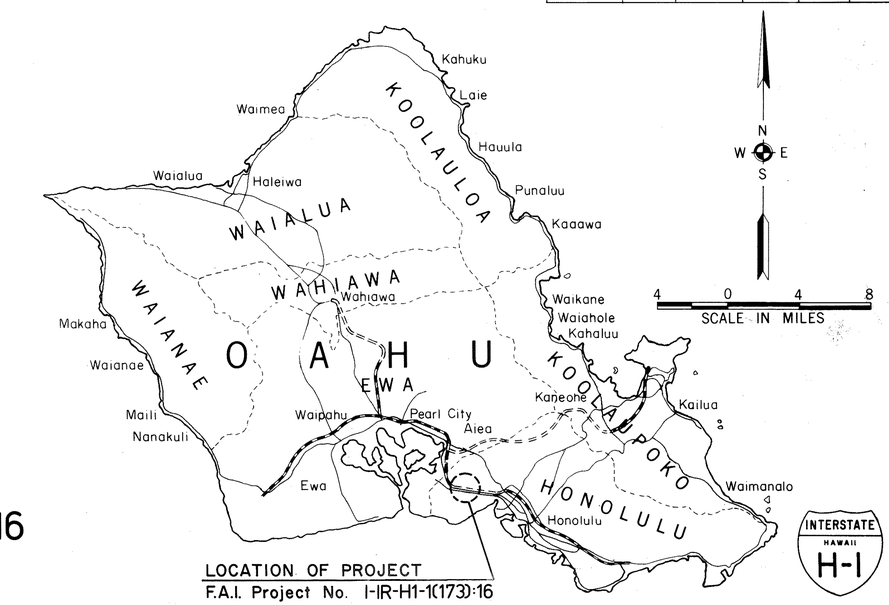

CHANGES MADE DURING CONSTRUCTION HAVE BEEN INCORPORATED ON THESE PLANS EXCEPT CHANGES IN THE ORIGINAL THEORETICAL QUANTITIES. FOR ACTUAL QUANTITIES, REFER TO PROJECT LEDGER AND/OR COMPUTATION BOOK.

Kelvin Akagawa
for RESIDENT ENGINEER

2-11-86
DATE

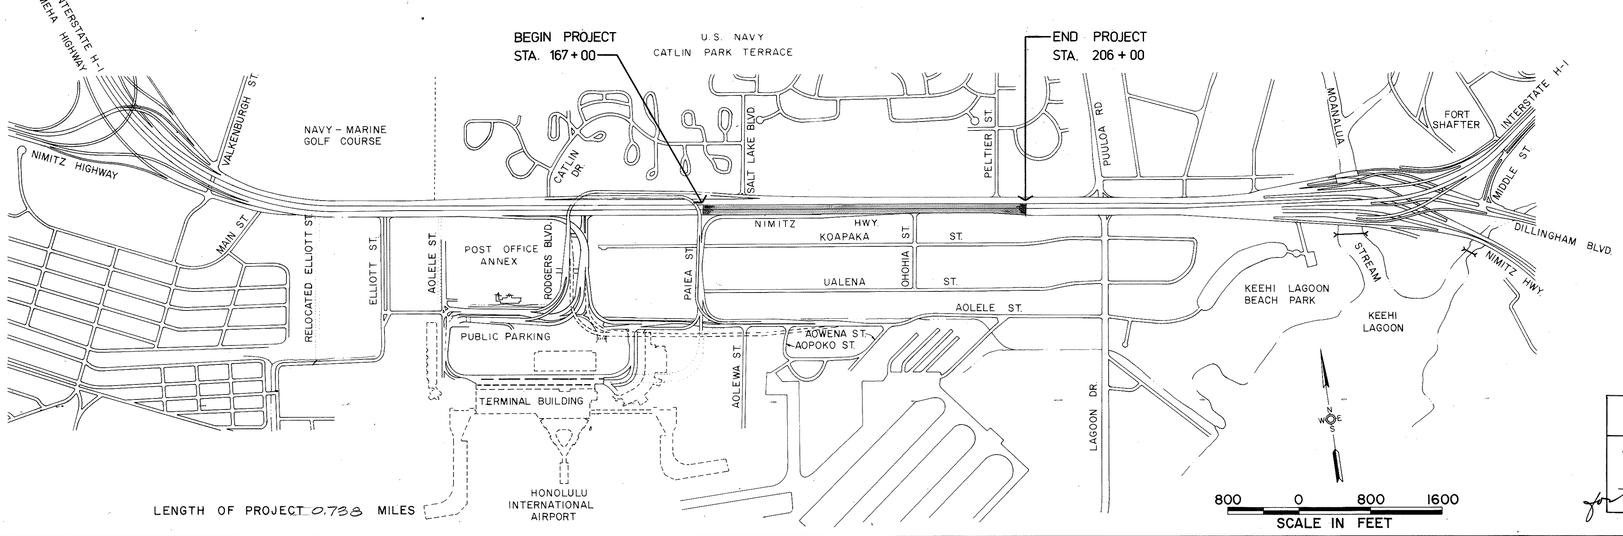

LENGTH OF PROJECT 0.738 MILES

DEPARTMENT OF TRANSPORTATION FEDERAL HIGHWAY ADMINISTRATION	
APPROVED:	
for DIVISION ADMINISTRATOR	3/23/83 DATE

DEPARTMENT OF TRANSPORTATION STATE OF HAWAII	
APPROVED:	
DIR. OF TRANSPORTATION	8/17/82 DATE

C-6-2