



FED. ROAD DIST. NO.	STATE	FED. AID PROJ. NO.	FISCAL YEAR	SHEET NO.	TOTAL SHEETS
HAWAII	HAW.	IR-H-1(186)	1987	70	97

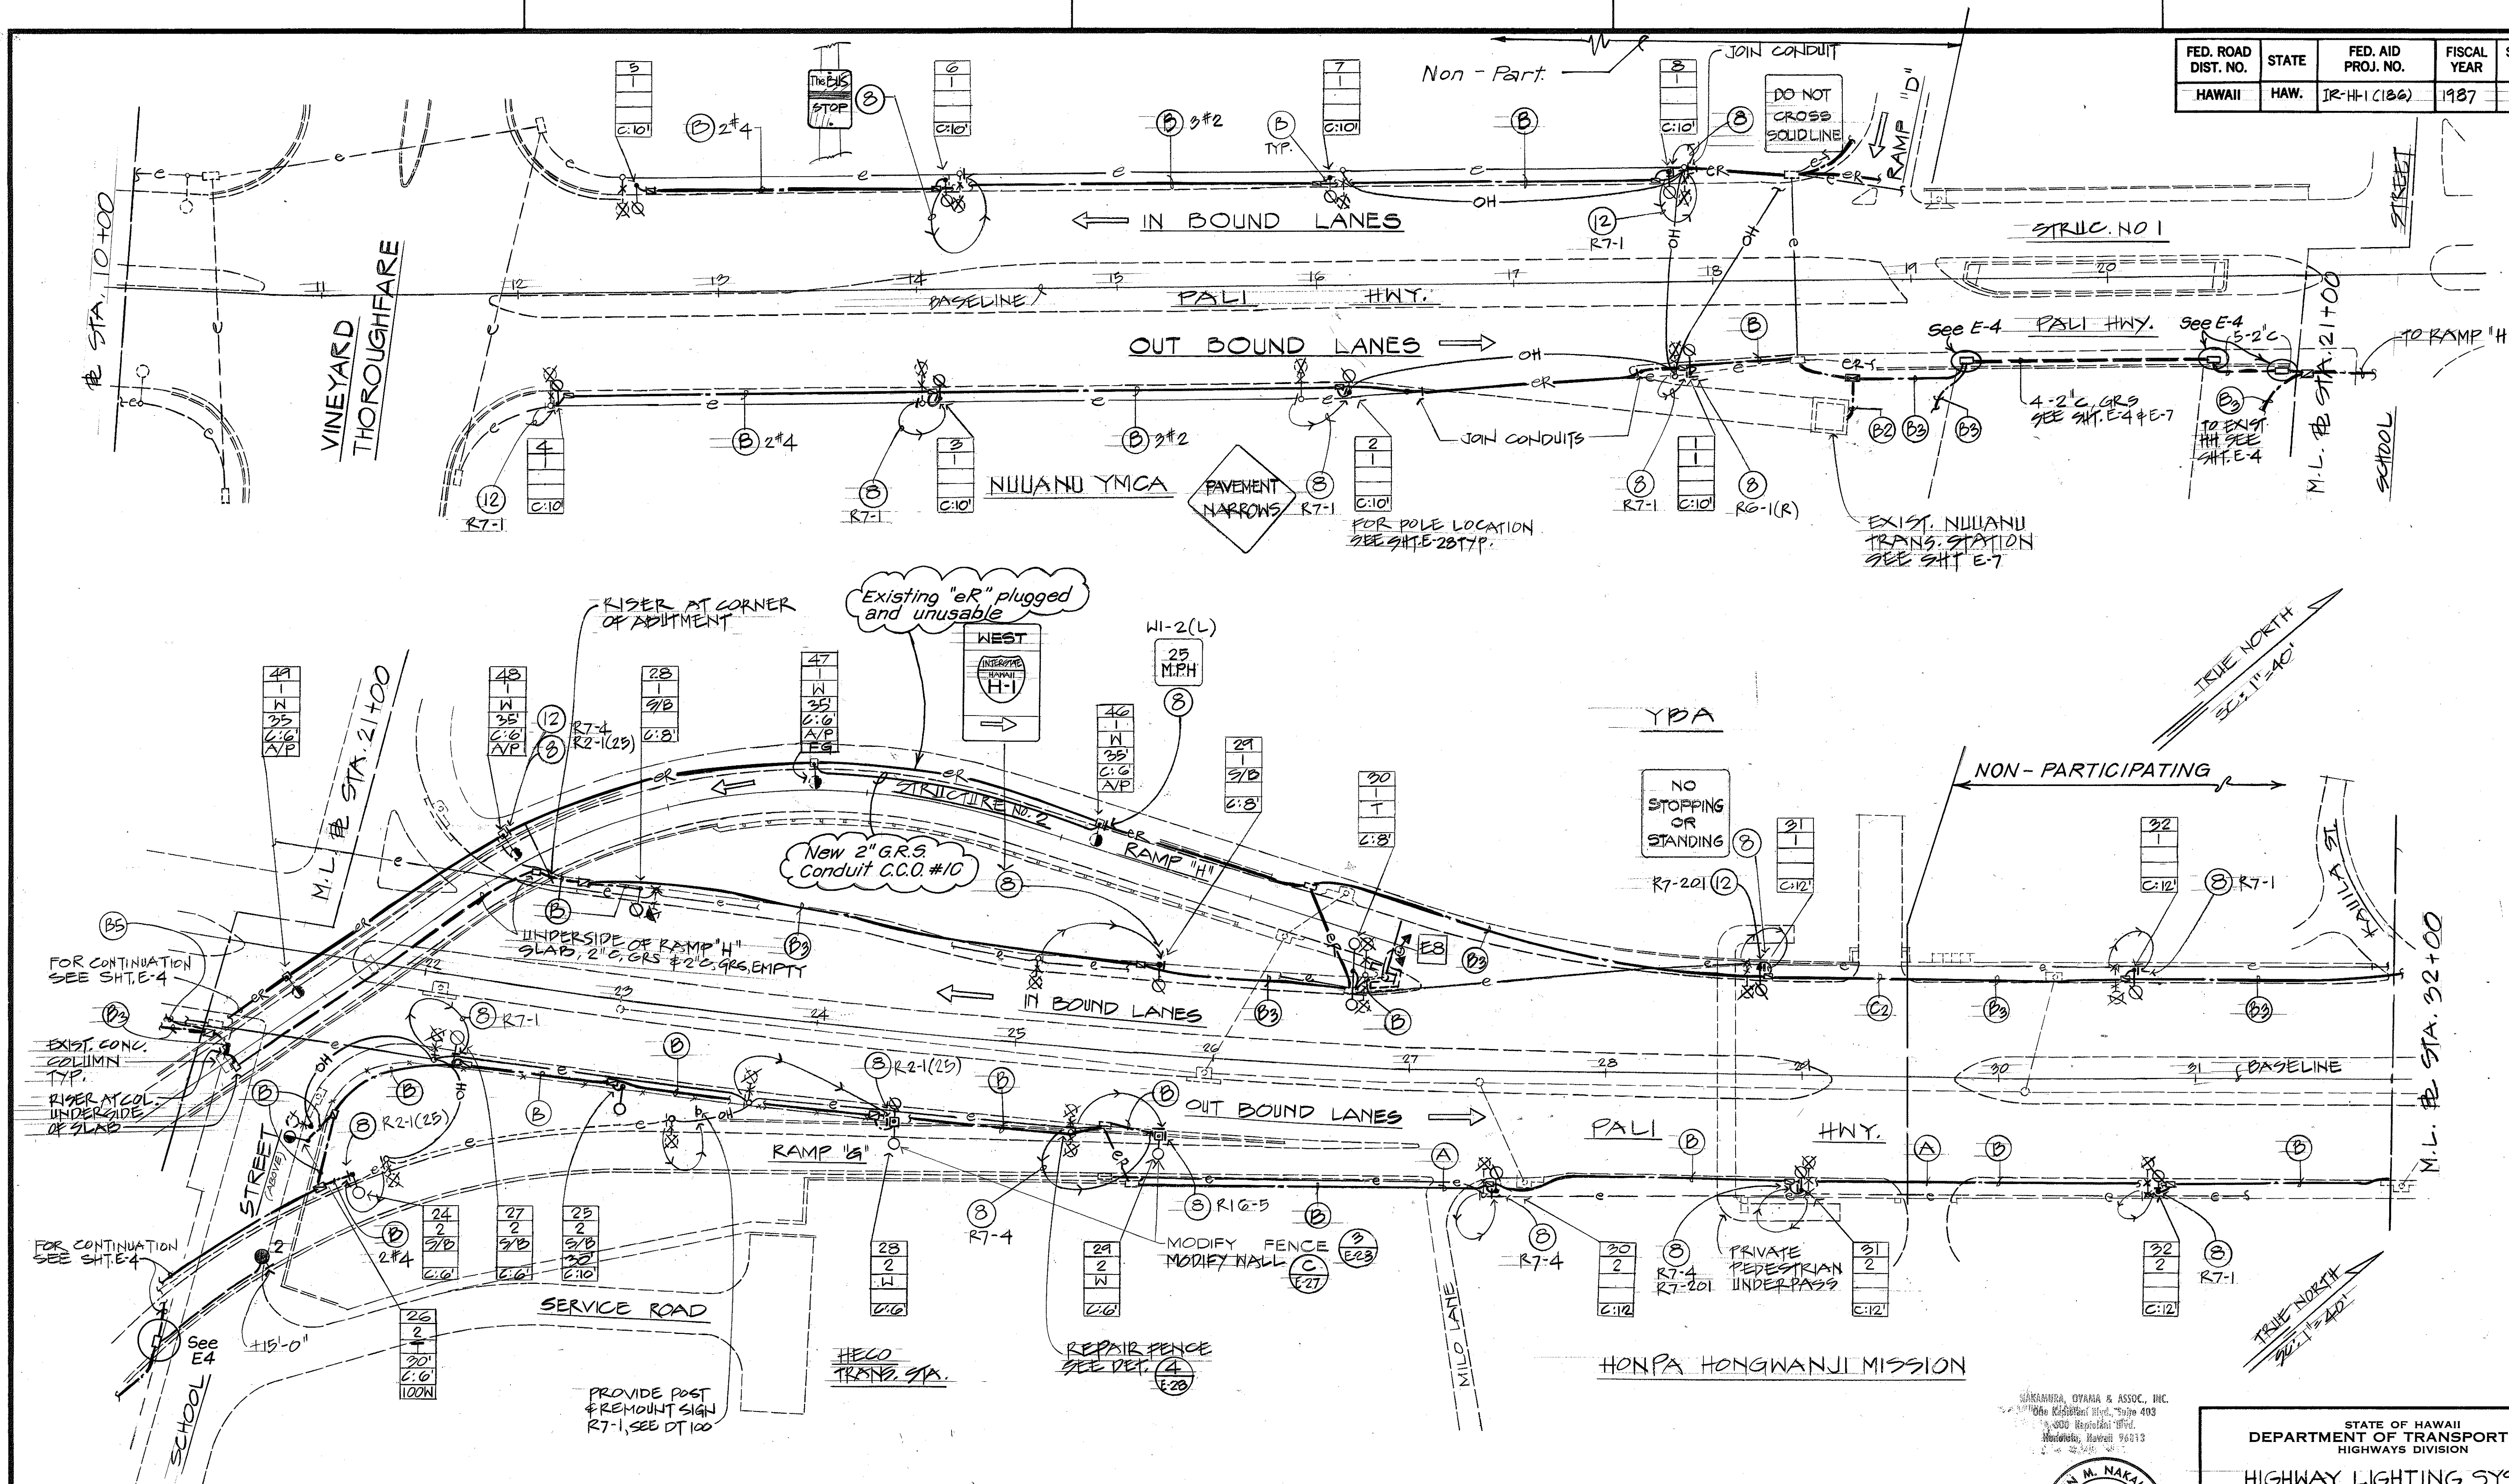

NOTE FOR STATE USE ONLY
 Federal Aid Non-Participating Areas for Pali Hwy.
 a. Vineyard Blvd to Ramp "P" (Sta. 18+00)
 b. Ramp "H" Taper (Sta. 27+50) to Pauoa Rd.

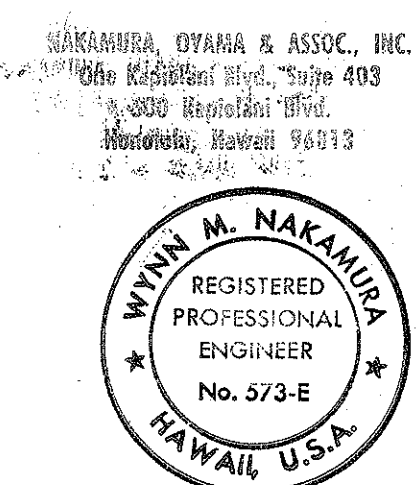

THIS WORK WAS PREPARED BY ME OR UNDER MY SUPERVISION.
 Wini M. Nakamura

STATE OF HAWAII
 DEPARTMENT OF TRANSPORTATION
 HIGHWAYS DIVISION

HIGHWAY LIGHTING SYSTEM

INTERSTATE ROUTE H-1
 HIGHWAY LIGHTING IMPROVEMENTS
 AALA STREET TO PUNCHBOWL STREET
 KEEAUMOKU STREET TO OLD WAIALAE ROAD
 PROJECT NO. IR-H-1(186)

SCALE: AS NOTED DATE: 30 JAN '87

SHEET NO. 6 OF 32 SHEETS

DATE	
SURVEY PLOTTED BY	
DRAWN BY	
DESIGNED BY	
CHECKED BY	
ORIGINAL PLAN	
NOTE BOOK	
No.	

