FED. ROAD DIST. NO.	STATE	FED. AID PROJ. NO.	FISCAL YEAR	SHEET NO.	TOTAL SHEETS
HAWAII	HAW.	IR-HI-1(204)	1987	2	97

INDEX TO DRAWINGS

SHEET NO.	DESCRIPTION
2	TITLE SHEET
3	STANDARD DETAIL SUMMARY
4	TYPICAL SECTION
5	GENERAL NOTES
6	SUMMARY GUARDRAIL CONN.
7 - 27	PLANS
28-29	MISCELLANEOUS DETAILS
30-56	SIGNING & PAVEMENT MARKERS
57-62	GUARDRAIL CONNECTIONS & RETROFIT DETAILS
63	TYPICAL DETAIL THRIE BEAM

STATE OF HAWAII

DEPARTMENT OF TRANSPORTATION

HIGHWAYS DIVISION

PLANS FOR

INTERSTATE ROUTE H-1 RESURFACING

MIDDLE STREET TO AINAKOA AVENUE

PROJECT NO. IR-HI-1(204)

DISTRICT OF HONOLULU

ISLAND OF OAHU

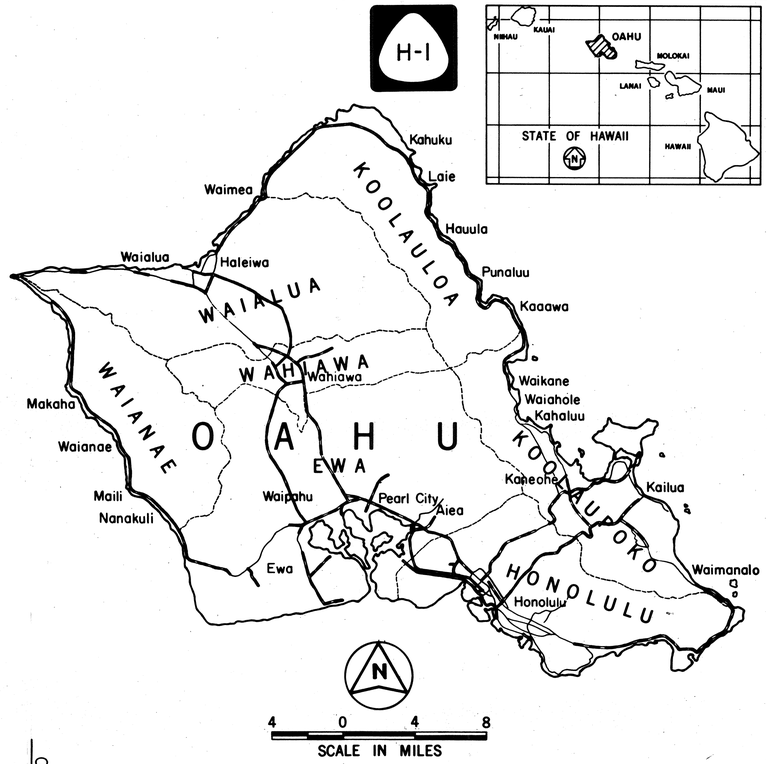

FEDERAL AID PROJECTS PREVIOUSLY CONSTRUCTED OR UNDER CONSTRUCTION

DESIGN DESIGNATION

CURRENT ADT (1987)	168,900
DESIGN ADT (1997)	187,100
DHV	14,000
D	60/40
T_{24}	2.5%
V	50 MPH

BEGIN PROJECT
BEGIN RESURFACING ⊕ STA. 144+00
END RESURFACING ⊕ STA. 45+80
BEGIN SHOULDER RESURFACING
END SHOULDER RESURFACING
BEGIN RESURFACING ⊕ STA. 162+65
END PROJECT ⊕ STA. 176+00
