FED. ROAD DIST. NO.	STATE	PROJ. NO.	FISCAL YEAR	SHEET NO.	TOTAL SHEETS
HAWAII	HAW.	HWY-0-03-83M	1983	1	16

INDEX TO DRAWINGS

SHEET NO.	DESCRIPTION
1	TITLE SHEET
2-3	TYPICAL SECTION
4	GENERAL NOTES
5-8	PLANS
9-12	PAVEMENT MARKING PLANS
13-16	STANDARD DETAILS

STATE OF HAWAII

DEPARTMENT OF TRANSPORTATION

HIGHWAYS DIVISION

HONOLULU, HAWAII

"AS BUILT"

PLANS FOR

WAIAWA INTERCHANGE COMPLEX RESURFACING

KAMEHAMEHA HIGHWAY CONNECTOR AND WAIPAHU STREET REALIGNMENT

PROJECT NO. HWY-0-03-83M

DISTRICT OF EWA

ISLAND OF OAHU

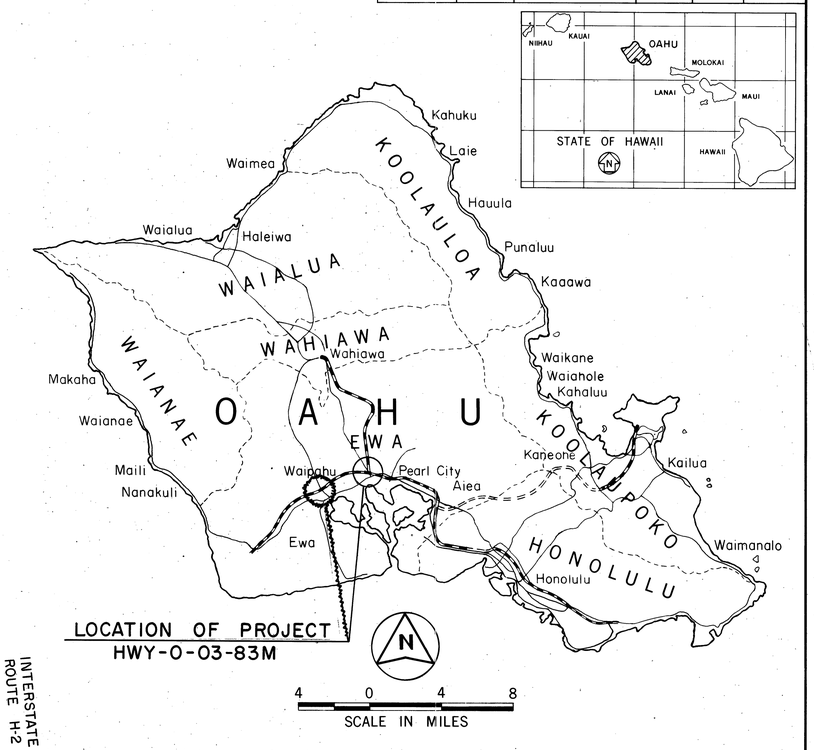

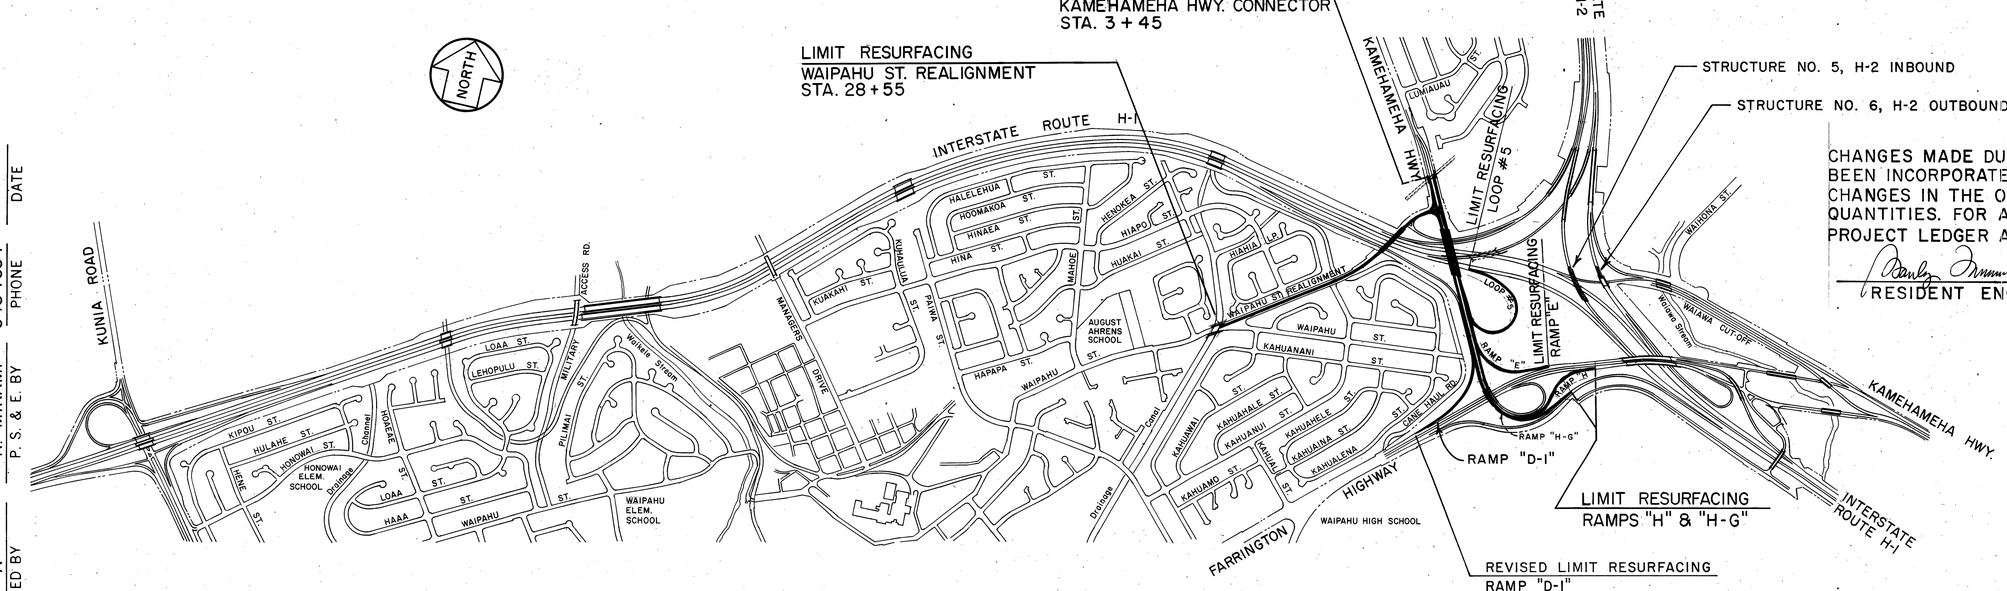

LAYOUT PLAN

CHANGES MADE DURING CONSTRUCTION HAVE BEEN INCORPORATED ON THESE PLANS CHANGES IN THE ORIGINAL THEORETICAL QUANTITIES. FOR ACTUAL QUANTITIES, REFER TO PROJECT LEDGER AND/OR COMPUTATION BOOK.

RESIDENT ENGINEER — DATE 12-22-83

GROSS LENGTH OF PROJECT

KAMEHAMEHA HIGHWAY CONNECTOR = 0.769 Mi.
WAIPAHU STREET REALIGNMENT = 0.529 Mi.

DEPARTMENT OF TRANSPORTATION
STATE OF HAWAII

APPROVED:

DIR. OF TRANSPORTATION — DATE 2/2/83

UNIT "A" — DESIGNED BY R. MIKAMI, P. S. & E. BY — PHONE 548-7534 — DATE

D-4-8