FED. ROAD DIST. NO.	STATE	FED. AID PROJ. NO.	FISCAL YEAR	SHEET NO.	TOTAL SHEETS
HAWAII	HAW.	I-HB-1(24):11	1983	69	328

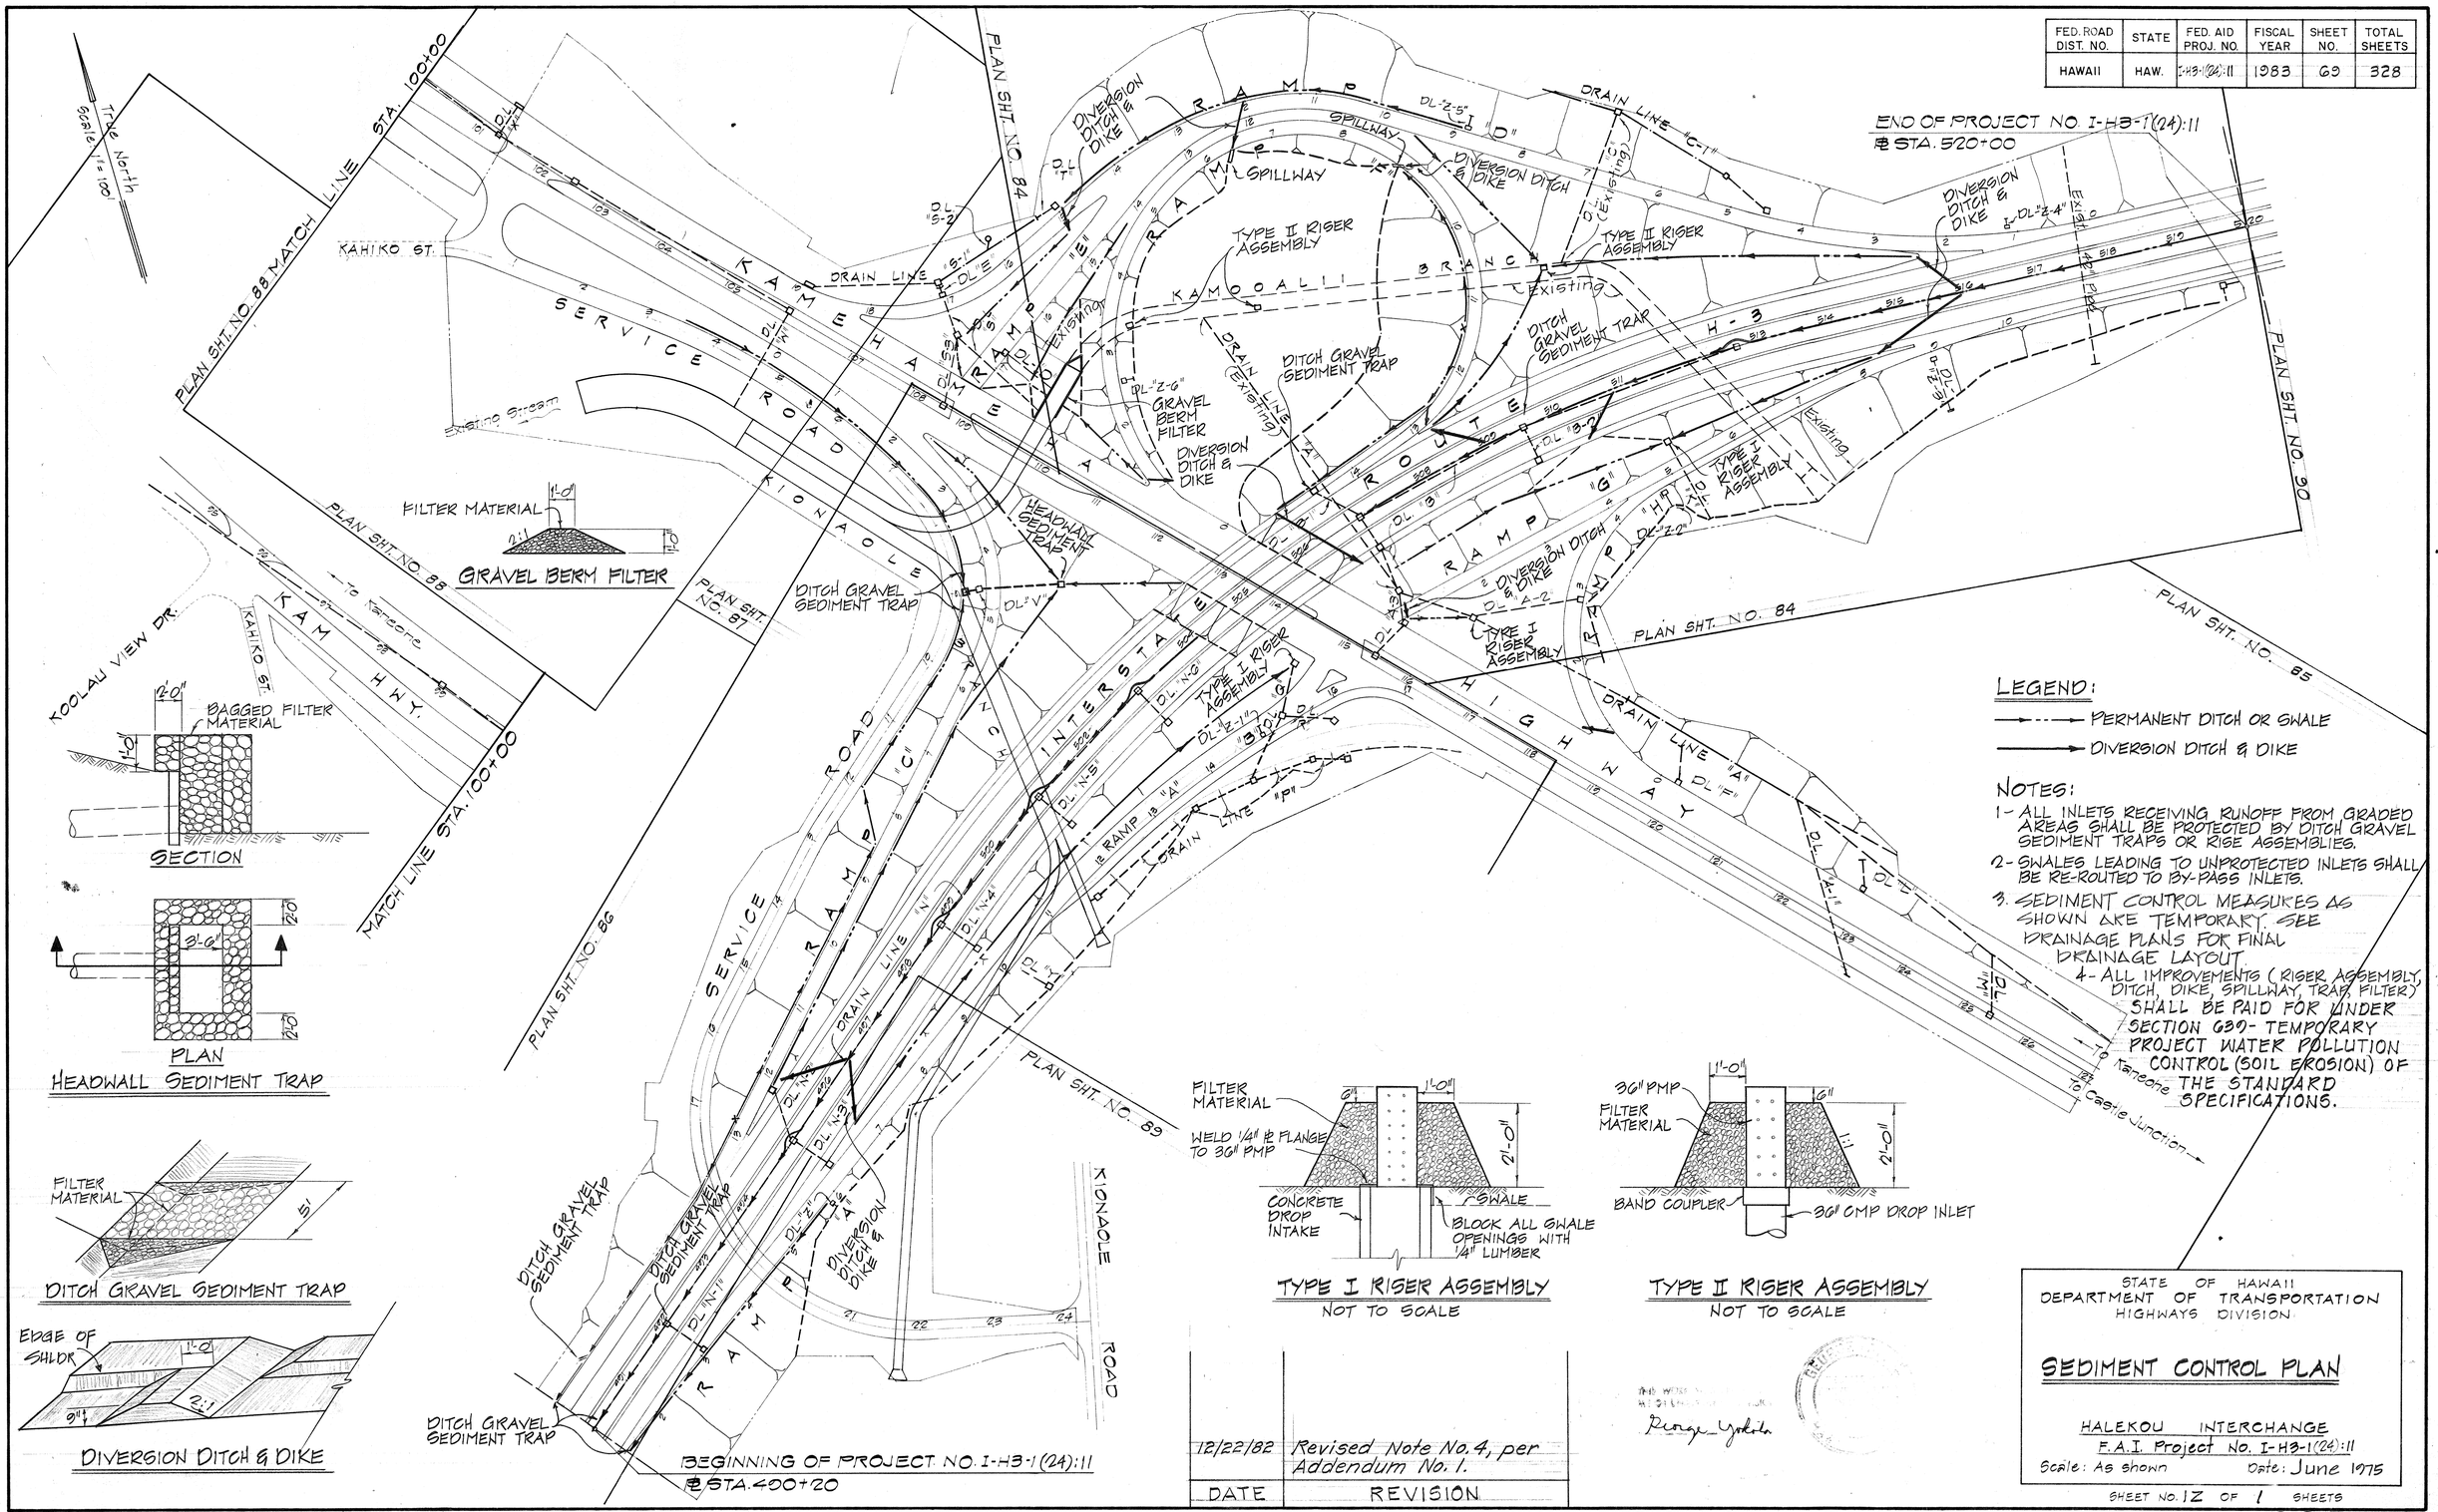

LEGEND:

→·→ PERMANENT DITCH OR SWALE

→ DIVERSION DITCH & DIKE

NOTES:

1- ALL INLETS RECEIVING RUNOFF FROM GRADED AREAS SHALL BE PROTECTED BY DITCH GRAVEL SEDIMENT TRAPS OR RISE ASSEMBLIES.

2- SWALES LEADING TO UNPROTECTED INLETS SHALL BE RE-ROUTED TO BY-PASS INLETS.

3. SEDIMENT CONTROL MEASURES AS SHOWN ARE TEMPORARY. SEE DRAINAGE PLANS FOR FINAL DRAINAGE LAYOUT.

4- ALL IMPROVEMENTS (RISER ASSEMBLY, DITCH, DIKE, SPILLWAY, TRAP, FILTER) SHALL BE PAID FOR UNDER SECTION 639- TEMPORARY PROJECT WATER POLLUTION CONTROL (SOIL EROSION) OF THE STANDARD SPECIFICATIONS.

DATE	REVISION
12/22/82	Revised Note No. 4, per Addendum No. 1.

STATE OF HAWAII
DEPARTMENT OF TRANSPORTATION
HIGHWAYS DIVISION

SEDIMENT CONTROL PLAN

HALEKOU INTERCHANGE
F.A.I. Project No. I-HB-1(24):11

Scale: As shown Date: June 1975

SHEET NO. 12 OF 1 SHEETS

69R