



FED. ROAD DIST. NO.	STATE	PROJ. NO.	FISCAL YEAR	SHEET NO.	TOTAL SHEETS
HAWAII	HAW.	A-90-01-66 90A-02-68	1967	3	4

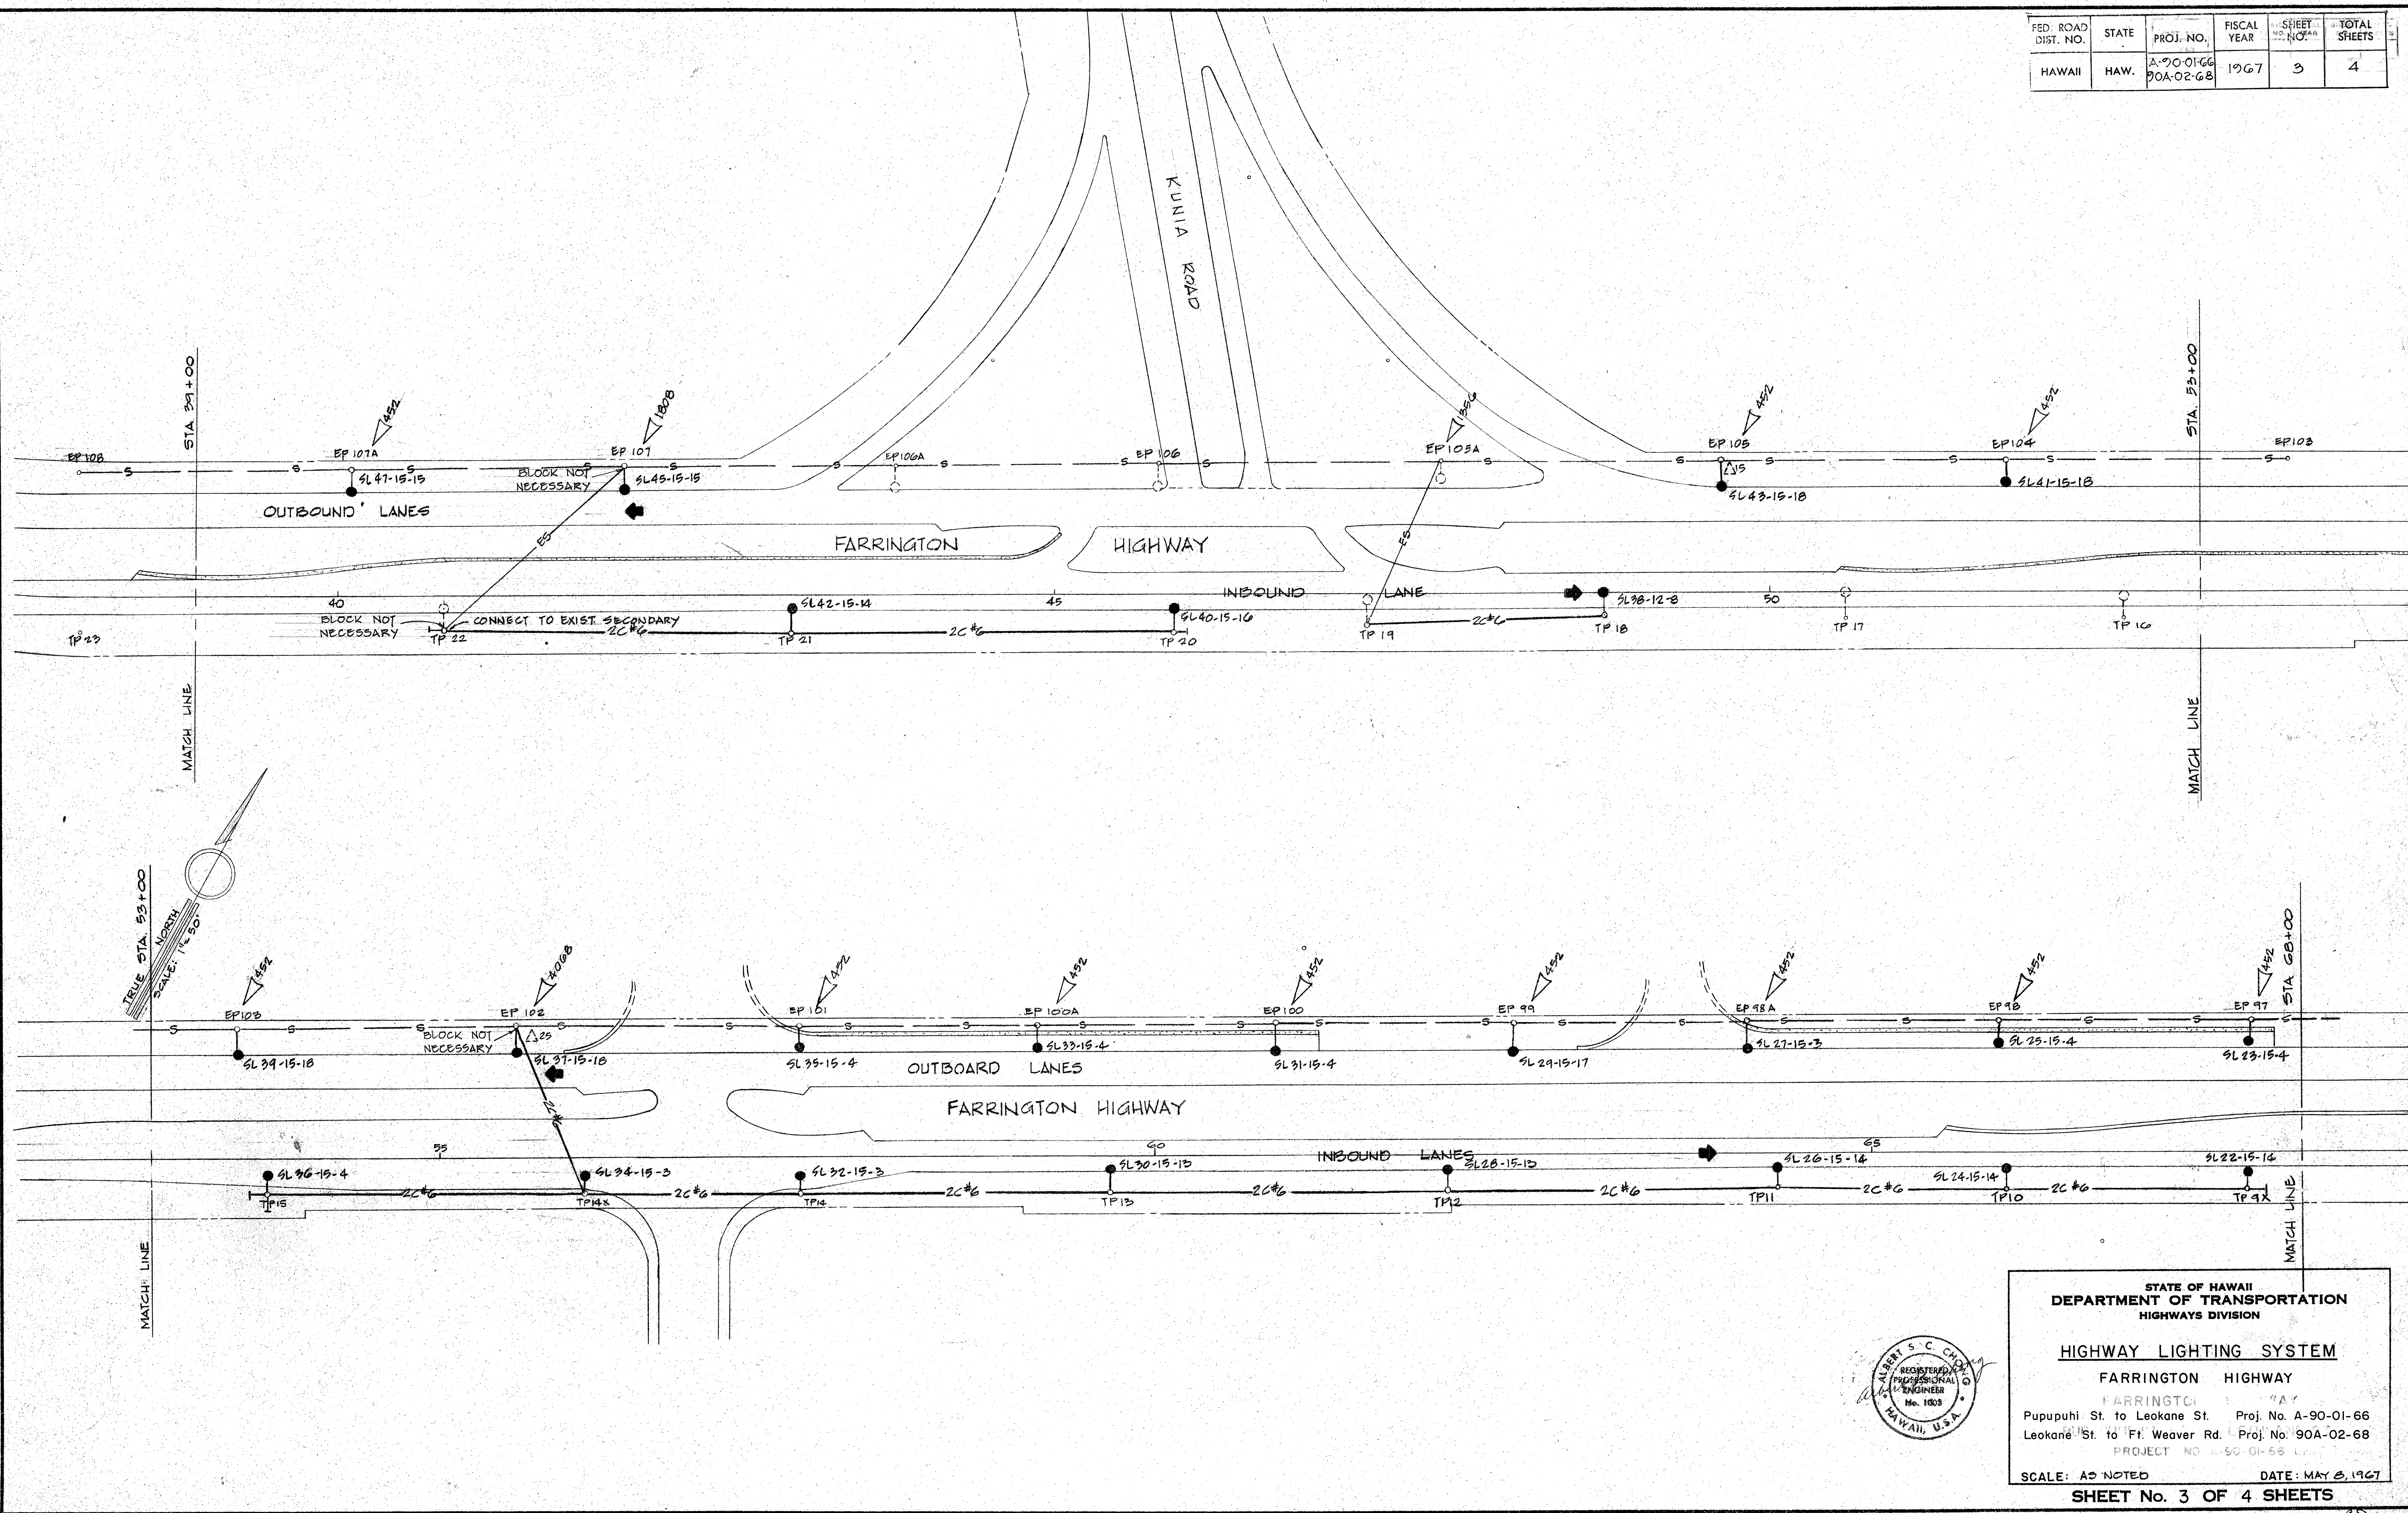

DATE	_____
SURVEY PLOTTED BY	_____
DRAWN BY	_____
DESIGNED BY	_____
NOTED BY	_____
CHECKED BY	_____

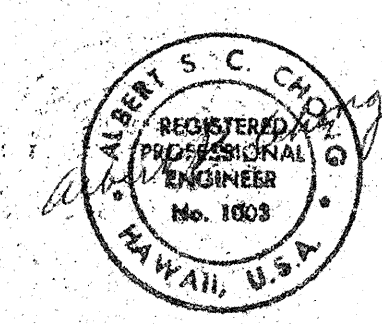

STATE OF HAWAII
DEPARTMENT OF TRANSPORTATION
HIGHWAYS DIVISION

HIGHWAY LIGHTING SYSTEM

FARRINGTON HIGHWAY

Pupupuhi St. to Leokane St. Proj. No. A-90-01-66
Leokane St. to Ft. Weaver Rd. Proj. No. 90A-02-68
PROJECT NO. A-90-01-66

SCALE: AS NOTED DATE: MAY 8, 1967

SHEET No. 3 OF 4 SHEETS